

BACKWALL REPAIR DETAIL

LAK 44-0207L - SOUTH ABUTMENT

LAK 44-0207R - NORTH ABUTMENT

BACKWALL REPAIR DETAIL

LAK 44-0207L-NORTH ABUTMENT

LAK 44-0207R-SOUTH ABUTMENT



LAKE COUNTY
LAK-44-202
CHANGE ORDER

PLAN NO.

ESTIMATED QUANTITIES

ITEM	UNIT	TOTAL	DESCRIPTION	LAK 44	LAK 44	PARTICIPATION	
				0207L	0207R	I	II
503	LB.	2260	REINFORCING STEEL	986	1274	—	2260

- * Bend existing A 603 or 4 bars, as shown
- ** Add D 801 Bars next to A 603 or 4.

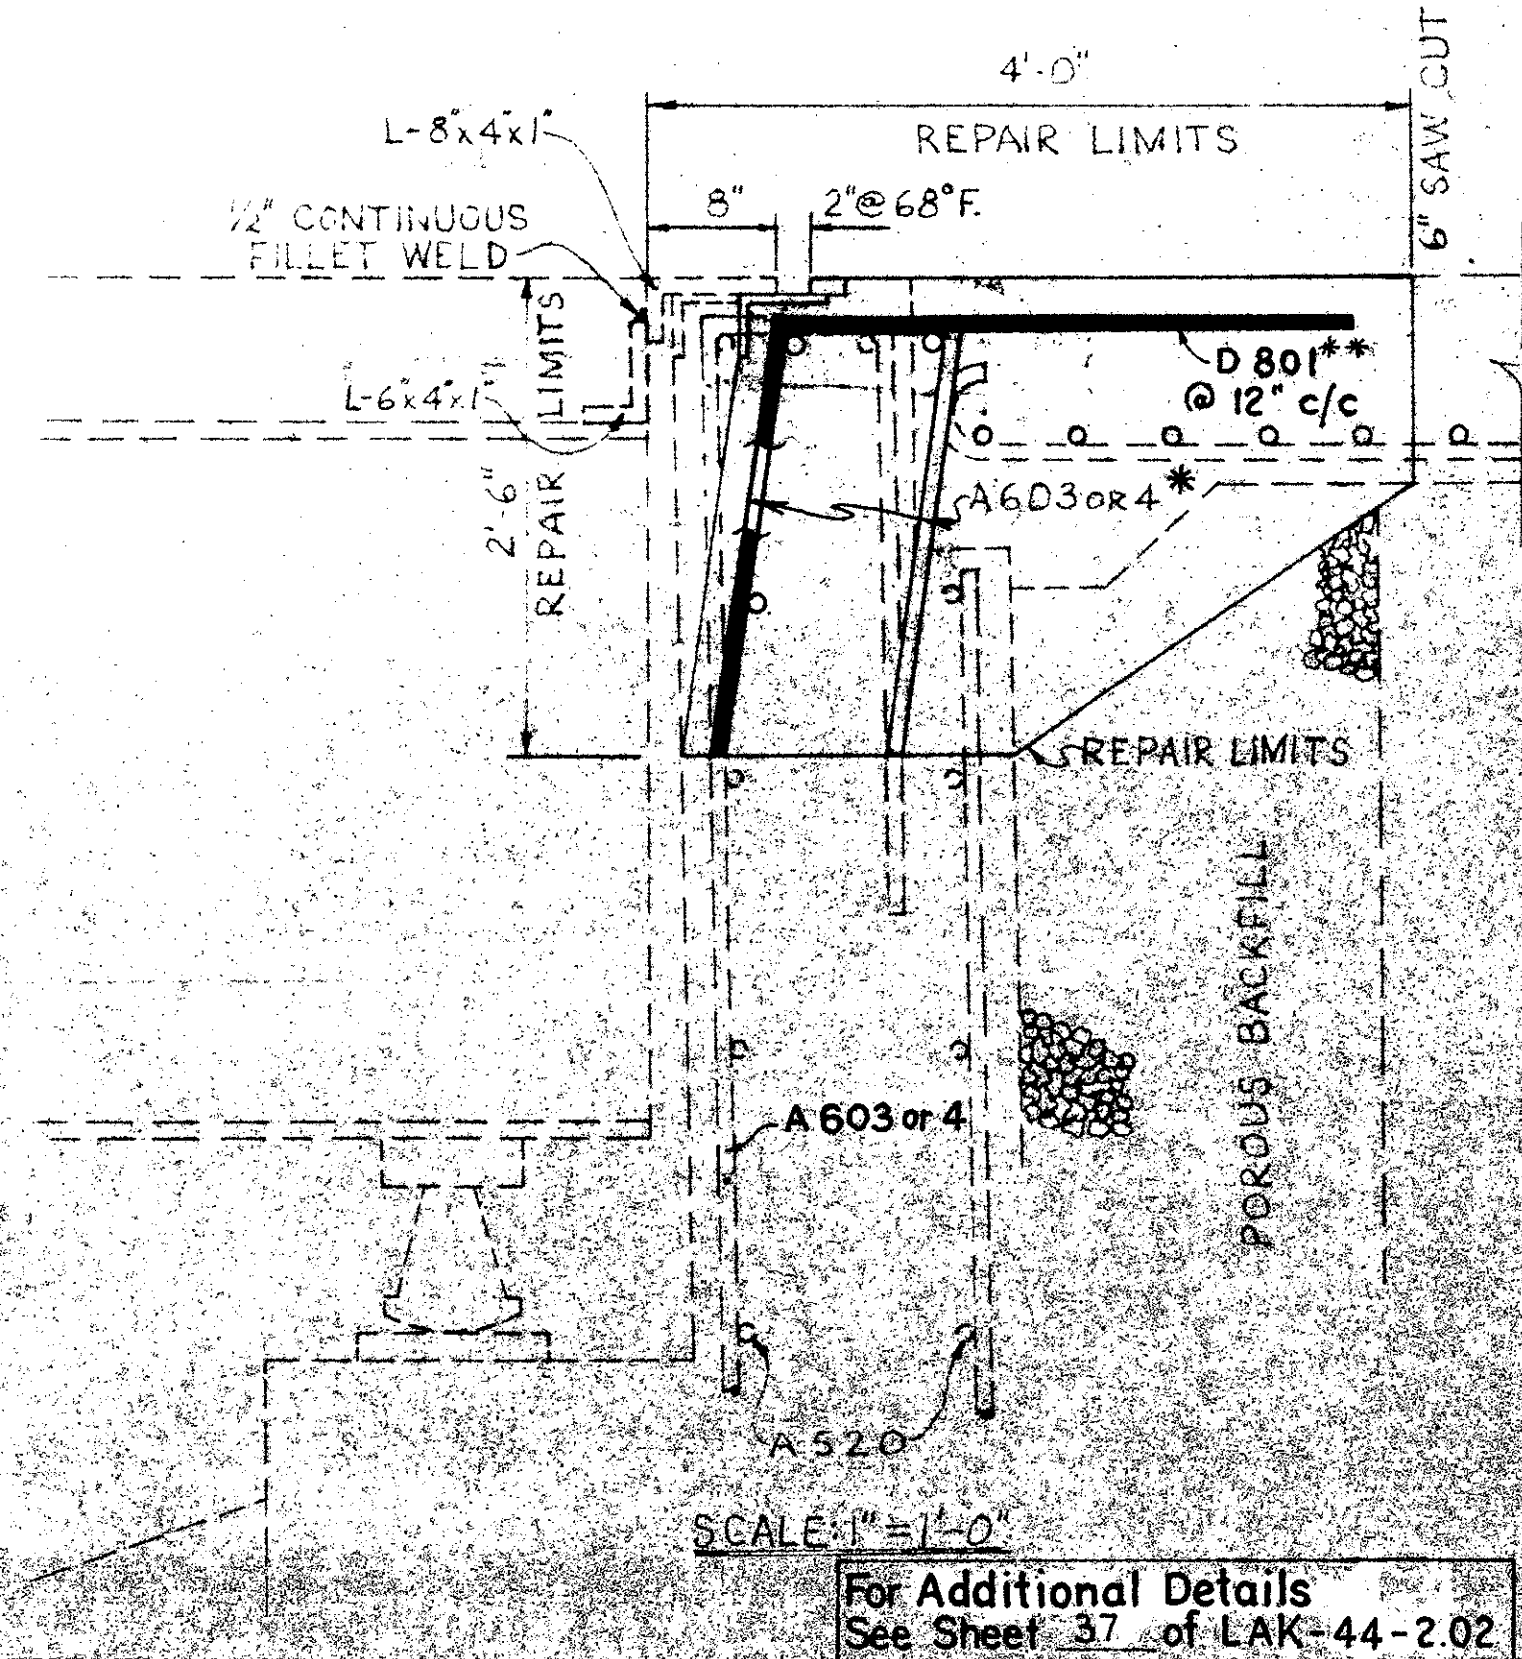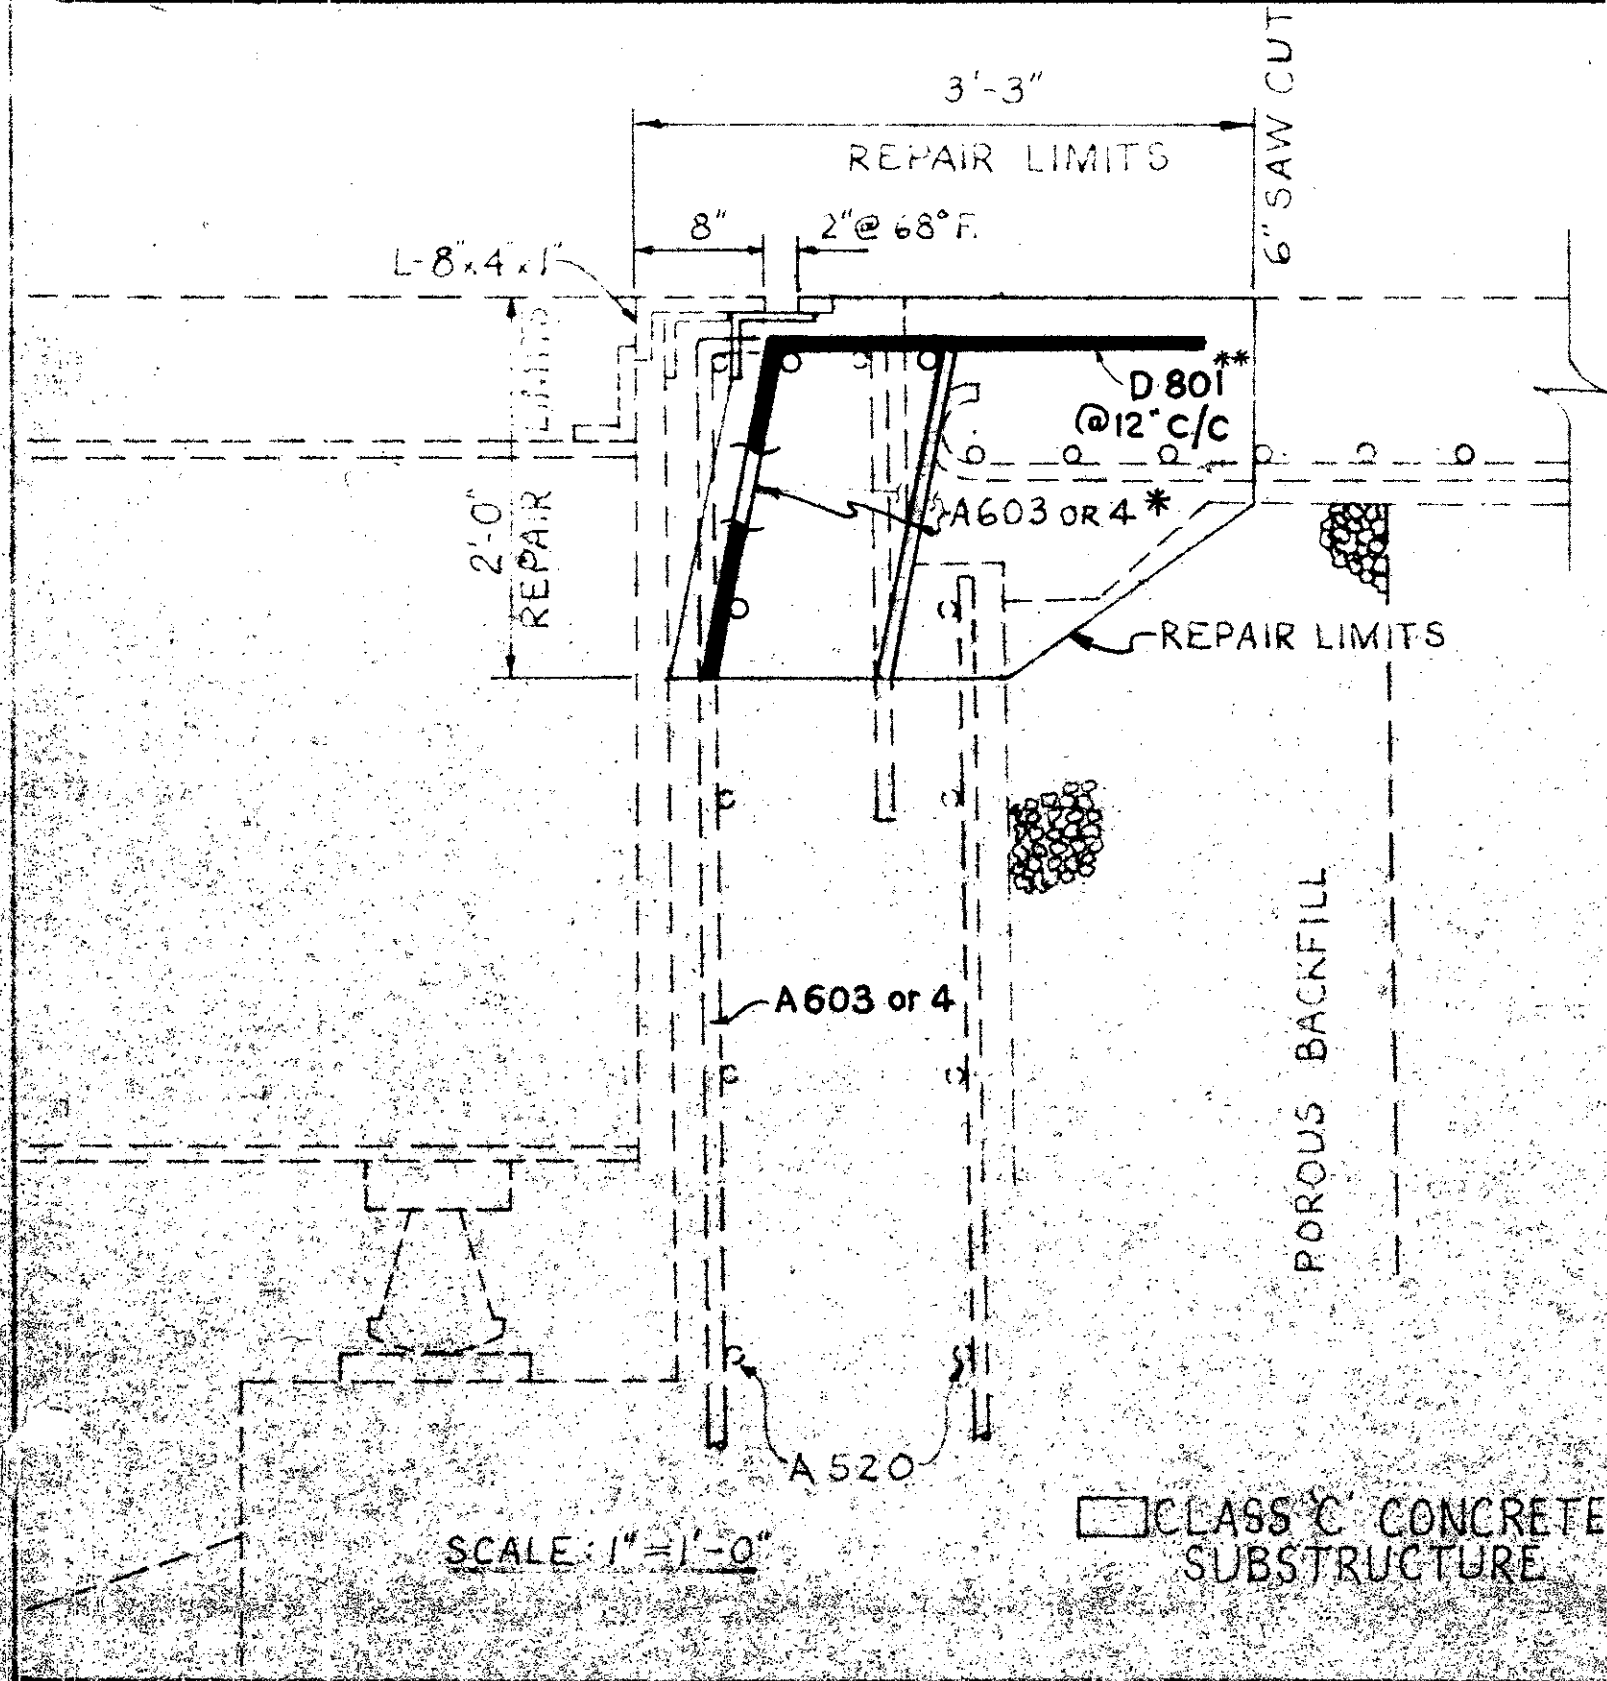

For Additional Details
See Sheet 37 of LAK-44-2.02