


FINAL SURVEY SURVEYED PLOTTED TEMPLATE AREAS CHECKED
 NO. BY DATE

ORIGINAL SURVEY SURVEYED PLOTTED TEMPLATE AREAS CHECKED
 NO. BY DATE

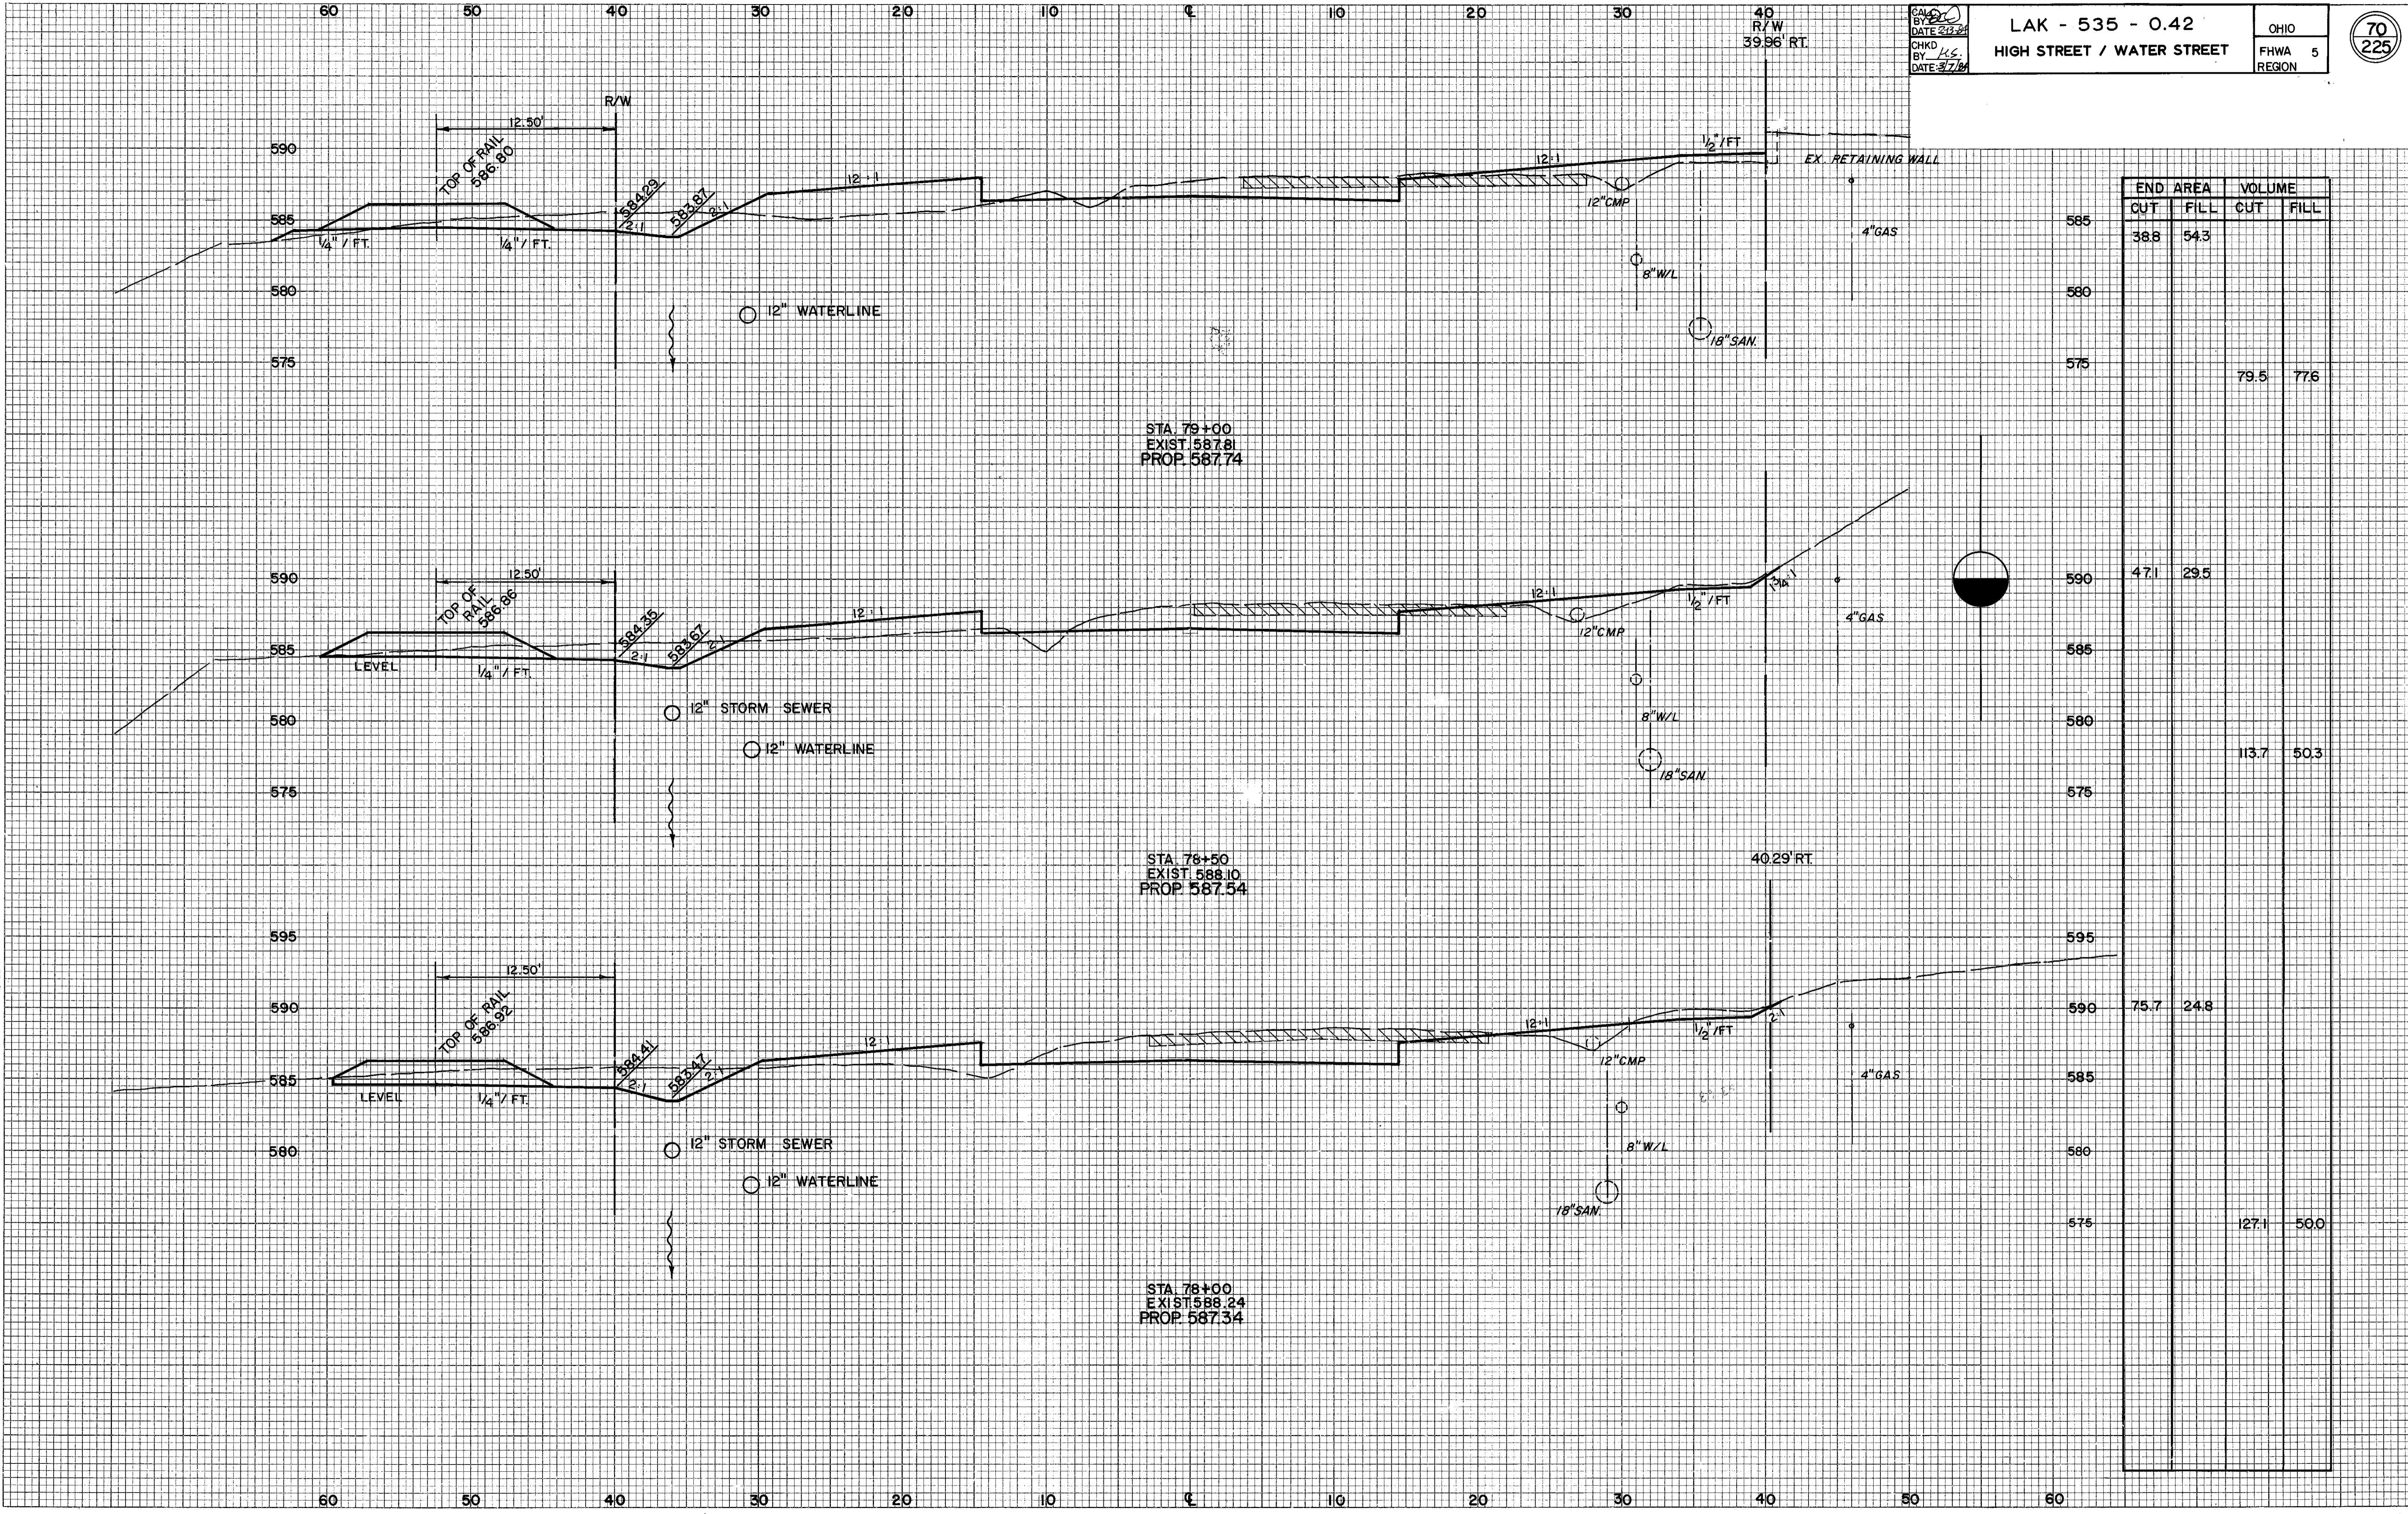

ELEVATION	END AREA		VOLUME	
	CUT	FILL	CUT	FILL
585	38.8	54.3		
575			79.5	77.6
590	47.1	29.5		
585				
575			113.7	50.3
595				
590	75.7	24.8		
585				
575			127.1	50.0