


01-1-1

70 60 50 40 30 20 10 0 10 20 30 40

FINAL SURVEY PLOTTED  
 REPORT BOOK PREPARED  
 BY: [Signature]  
 DATE: 3/7/64

ORIGINAL SURVEY PLOTTED  
 NOTE BOOK PREPARED  
 BY: [Signature]  
 DATE: 3/7/64

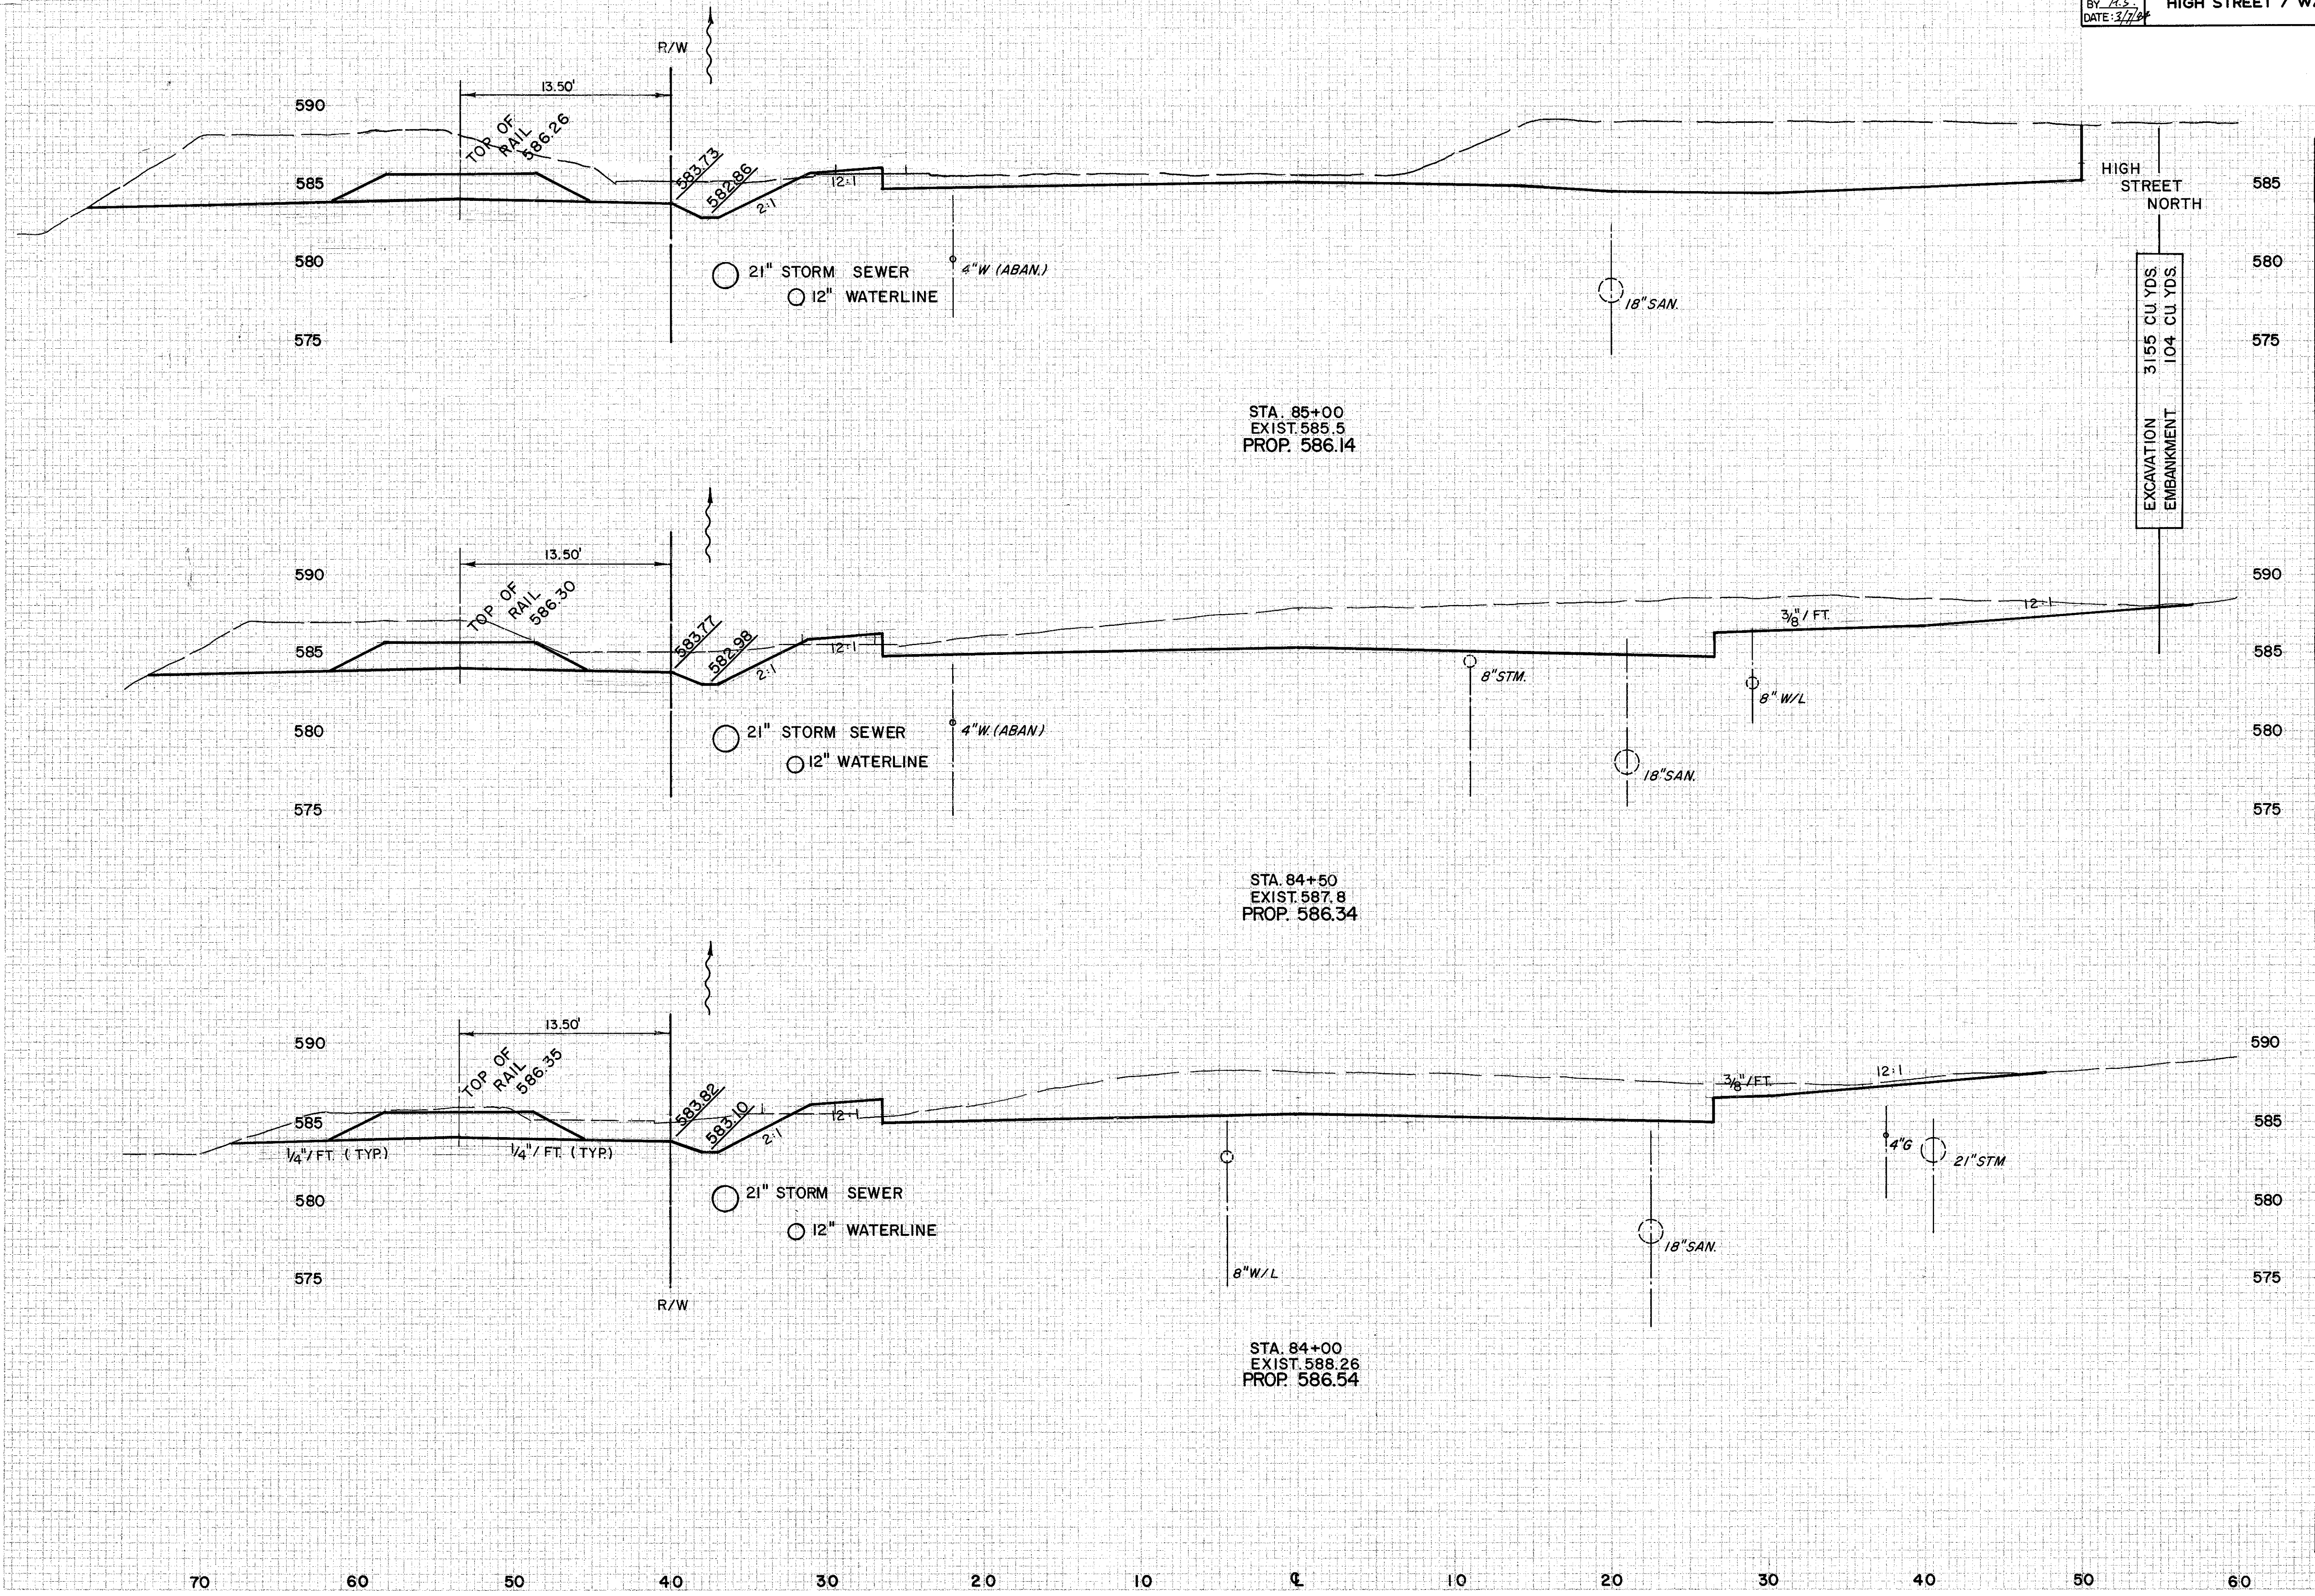

ELEVATION	END AREA		VOLUME	
	CUT	FILL	CUT	FILL
585	327.3	0.8		
580				
575			5330	2.6
590	248.3	2.0		
585				
580				
575			391.7	5.4
590				
585				
580				
575				
590	174.7	3.8		
585				
580				
575				
			291.3	7.3

HIGH STREET NORTH  
 EXCAVATION 3155 CU YDS.  
 EMBANKMENT 104 CU YDS.

STA. 85+00  
 EXIST. 585.5  
 PROP. 586.14

STA. 84+50  
 EXIST. 587.8  
 PROP. 586.34

STA. 84+00  
 EXIST. 588.26  
 PROP. 586.54

HIGH STREET