


60 50 40 30 20 10 0 10 20 30 40

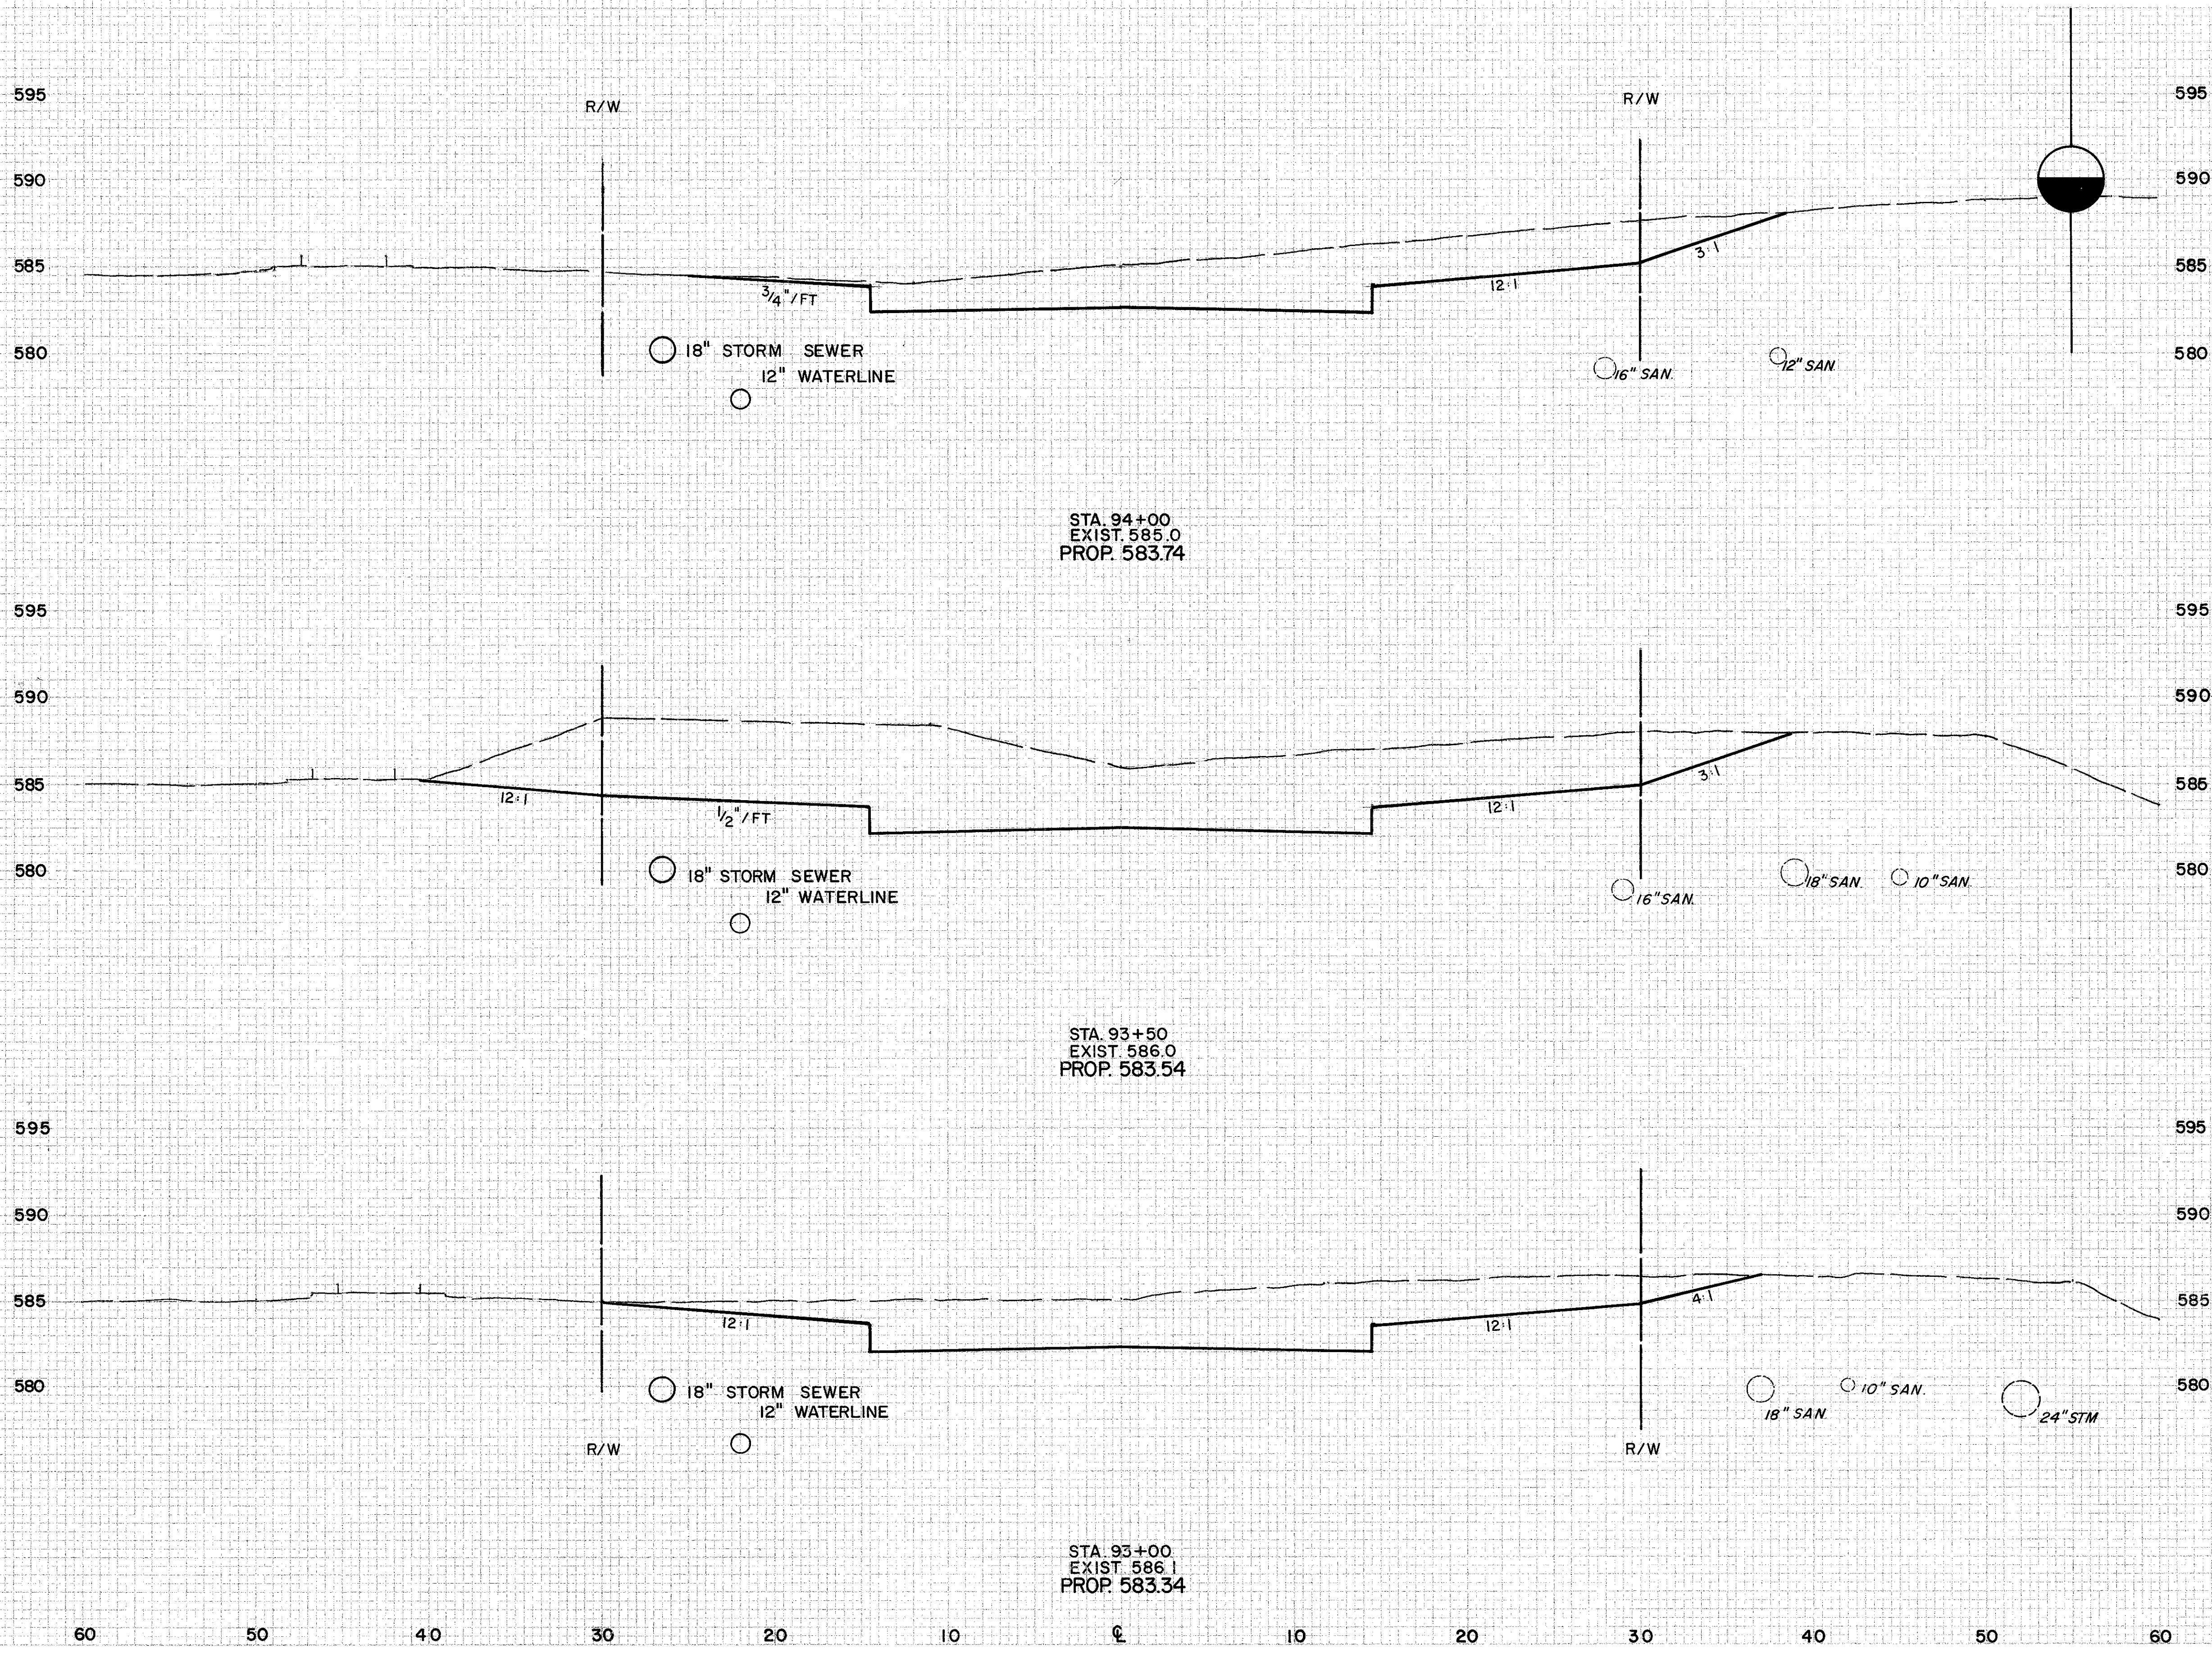

END AREA	VOLUME	
	CUT	FILL
117.4	0	
		377.5 0
290.3	0	
		401.2 0
143.0	0	
		291.4 0

FINAL SURVEY
 PART 1: 1/13/04
 PART 2: 3/7/04
 PART 3: 3/7/04
FINAL SURVEY
 PART 1: 1/13/04
 PART 2: 3/7/04
 PART 3: 3/7/04
