


60 50 40 30 20 10 0 10 20 30 40

FINAL SURVEY PLOTTED  
 DATE 2/17/81

ORIGINAL SURVEY PLOTTED  
 DATE 2/17/81

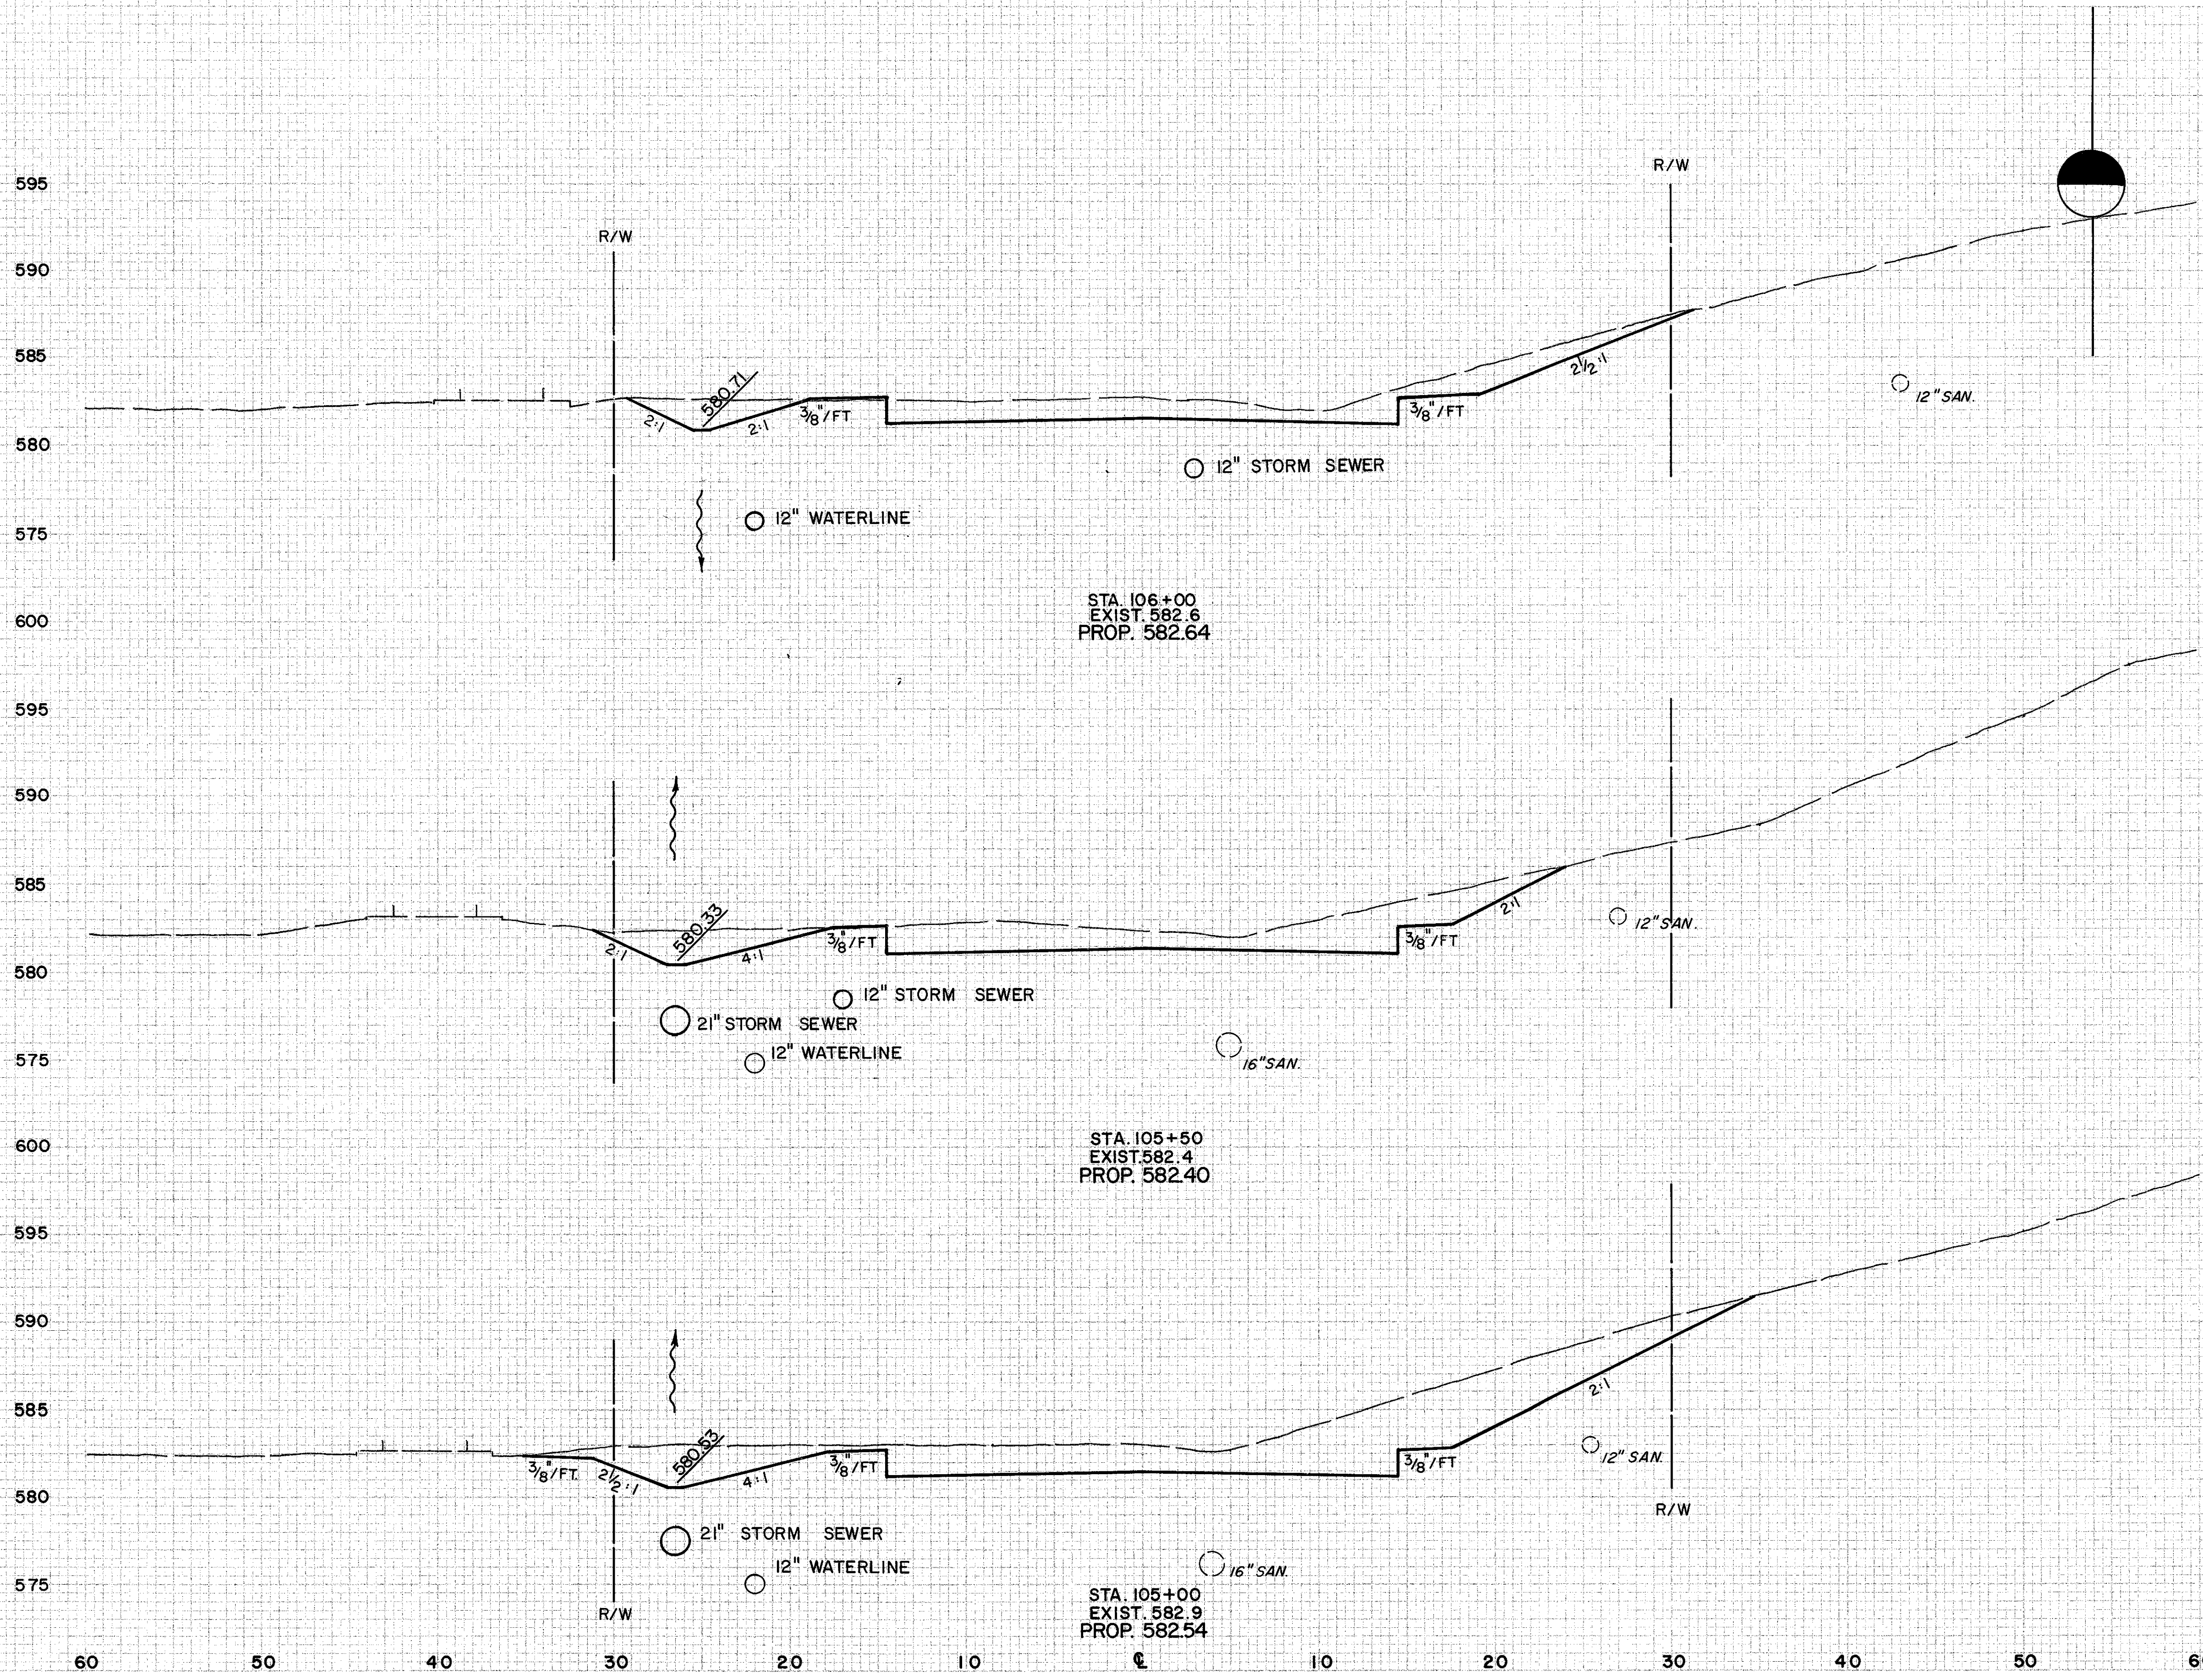

END AREA		VOLUME	
CUT	FILL	CUT	FILL
54.2	0.7		
		110.0	0.6
64.6	0		
		171.8	0
120.9	0		
		229.7	0

PLATE 3 CROSS SECTION OF P. & R. S. DRAWINGS  
 REFERENCE TO DRAWING

CROSS-SECTIONS STA. 105+00 TO STA. 106+00

WATER STREET