


60 50 40 30 20 10 0 10 20 30 40

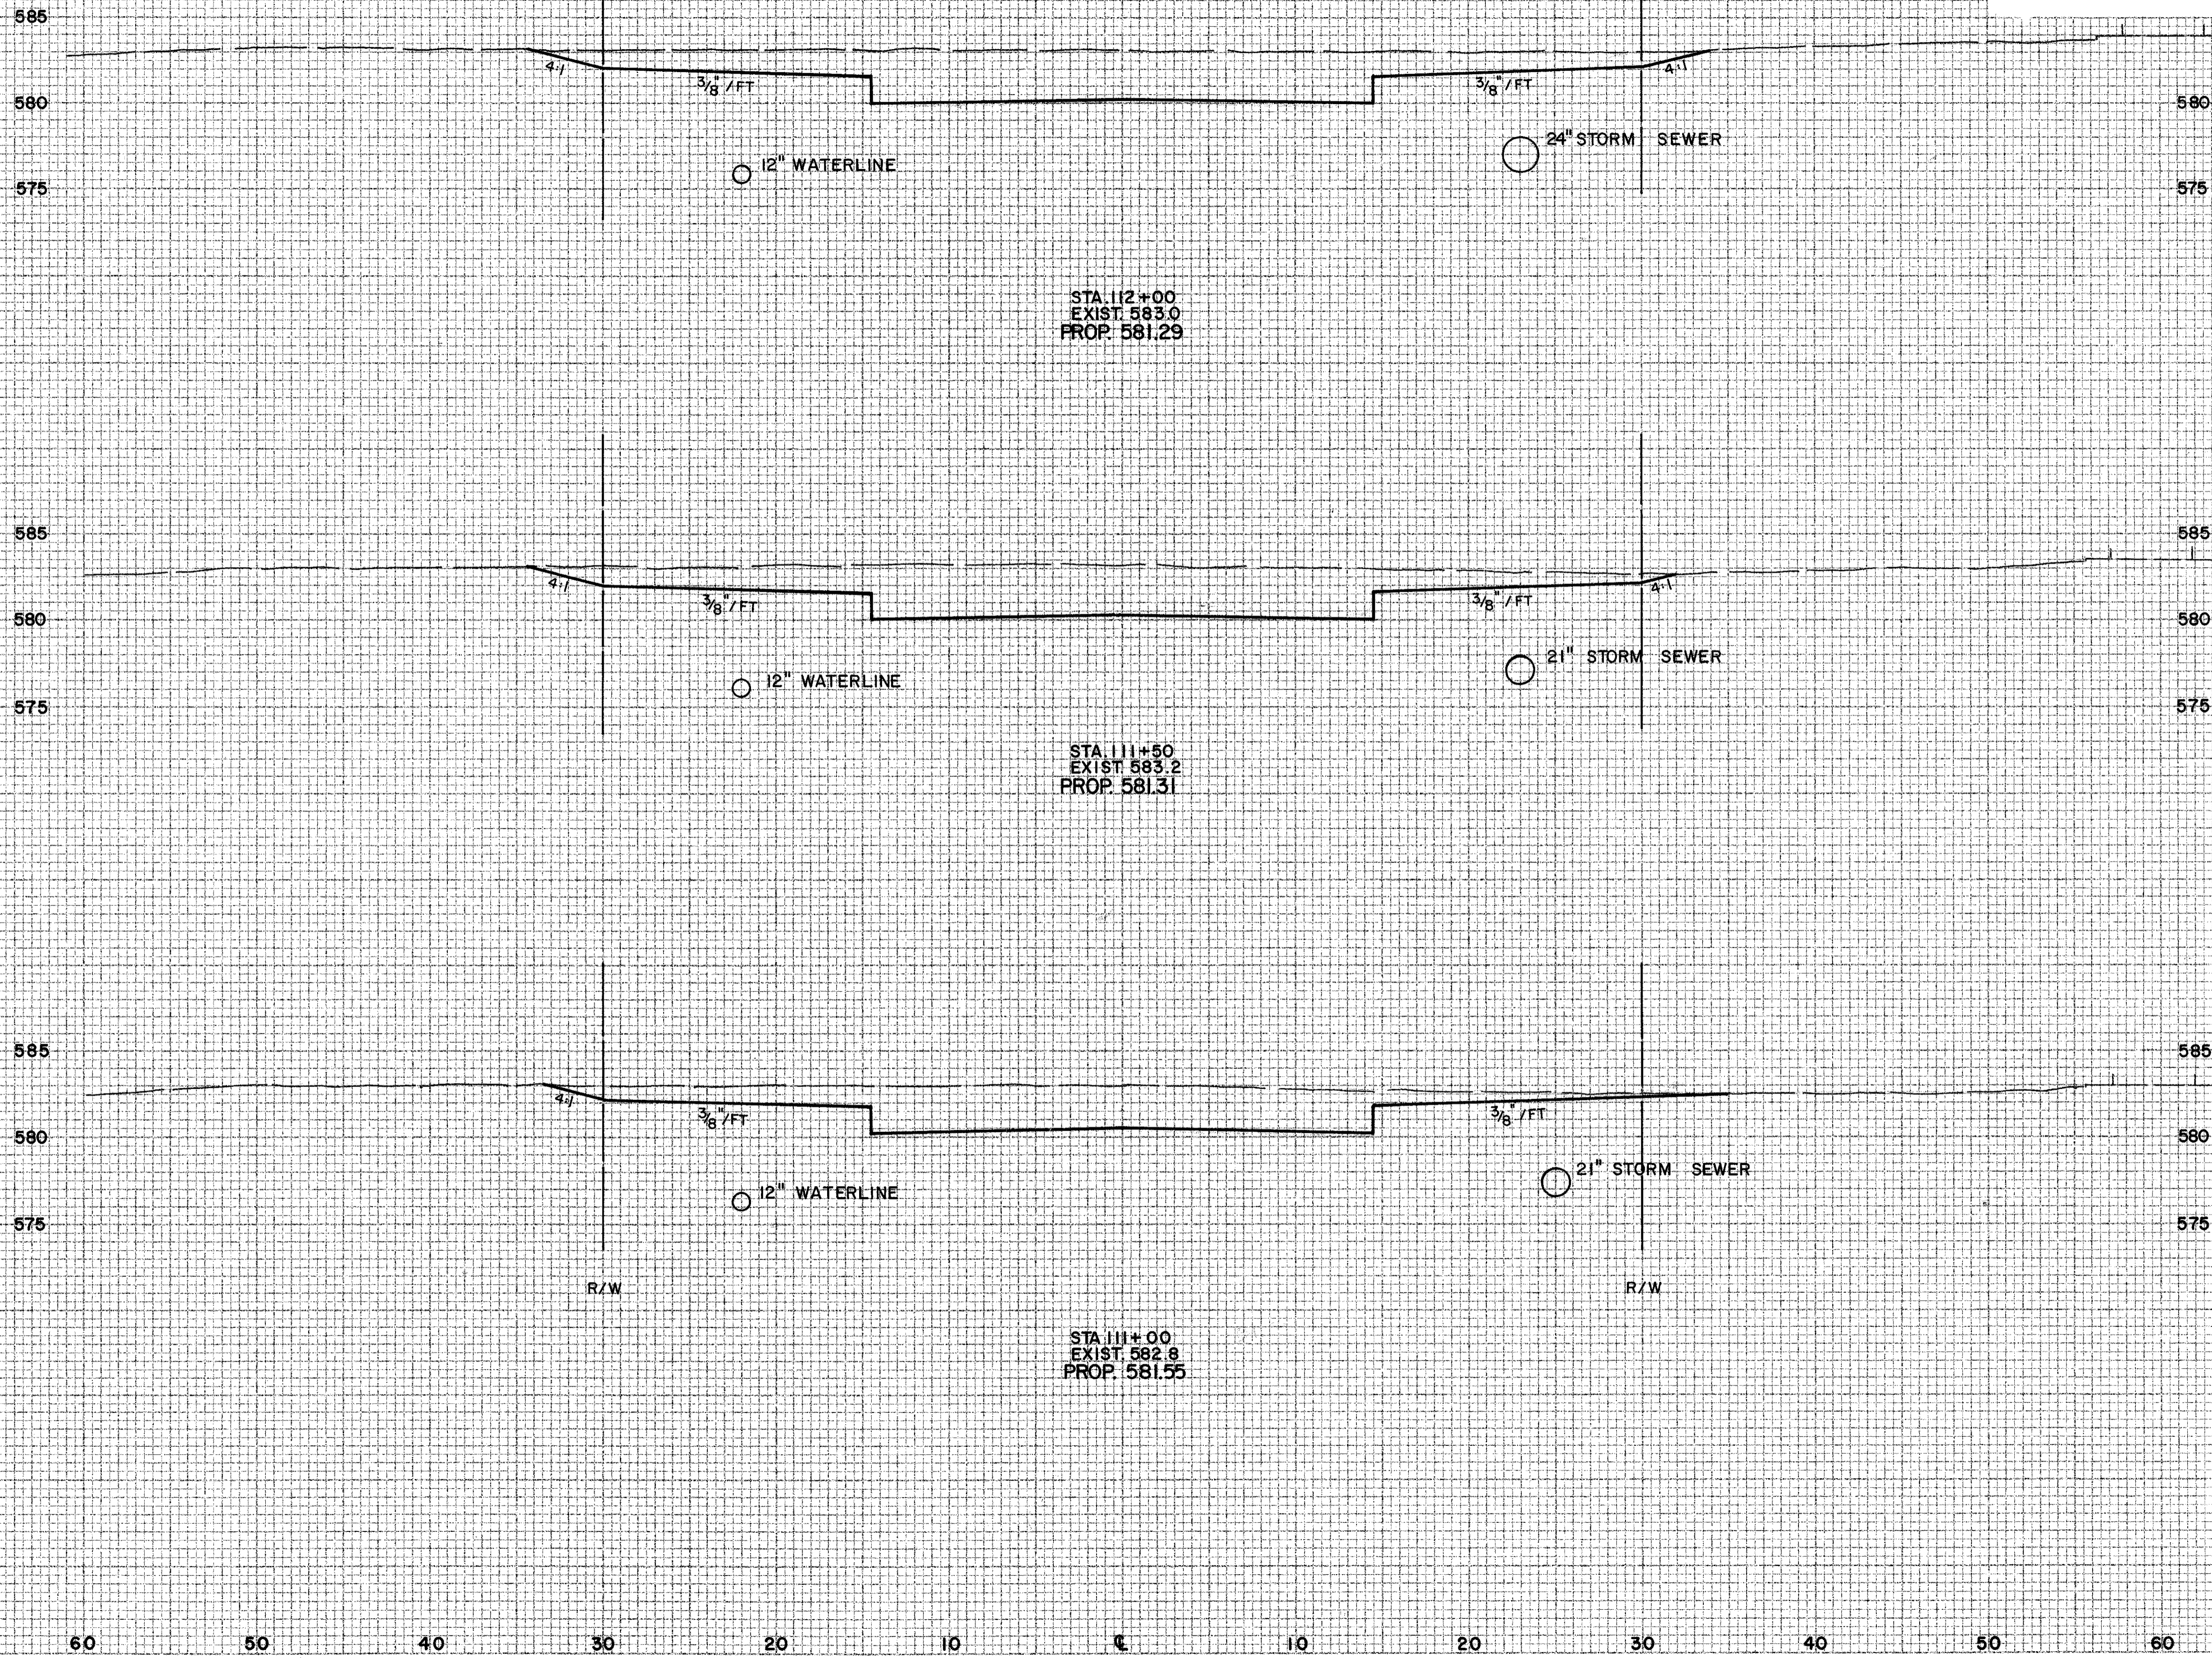

END AREA		VOLUME	
CUT	FILL	CUT	FILL
129.3	0		
		234.7	0
124.2	0		
		2053	0
97.5	0		
		1706	0

FINAL SURVEY PLOTTED.
 NOTE BOOK 13941E
 AREAS CHECKED.

ORIGINAL SURVEY PLOTTED.
 NOTE BOOK 13941E
 AREAS CHECKED.

WATER STREET