


FINAL SURVEY  

ORIGINAL SURVEY  

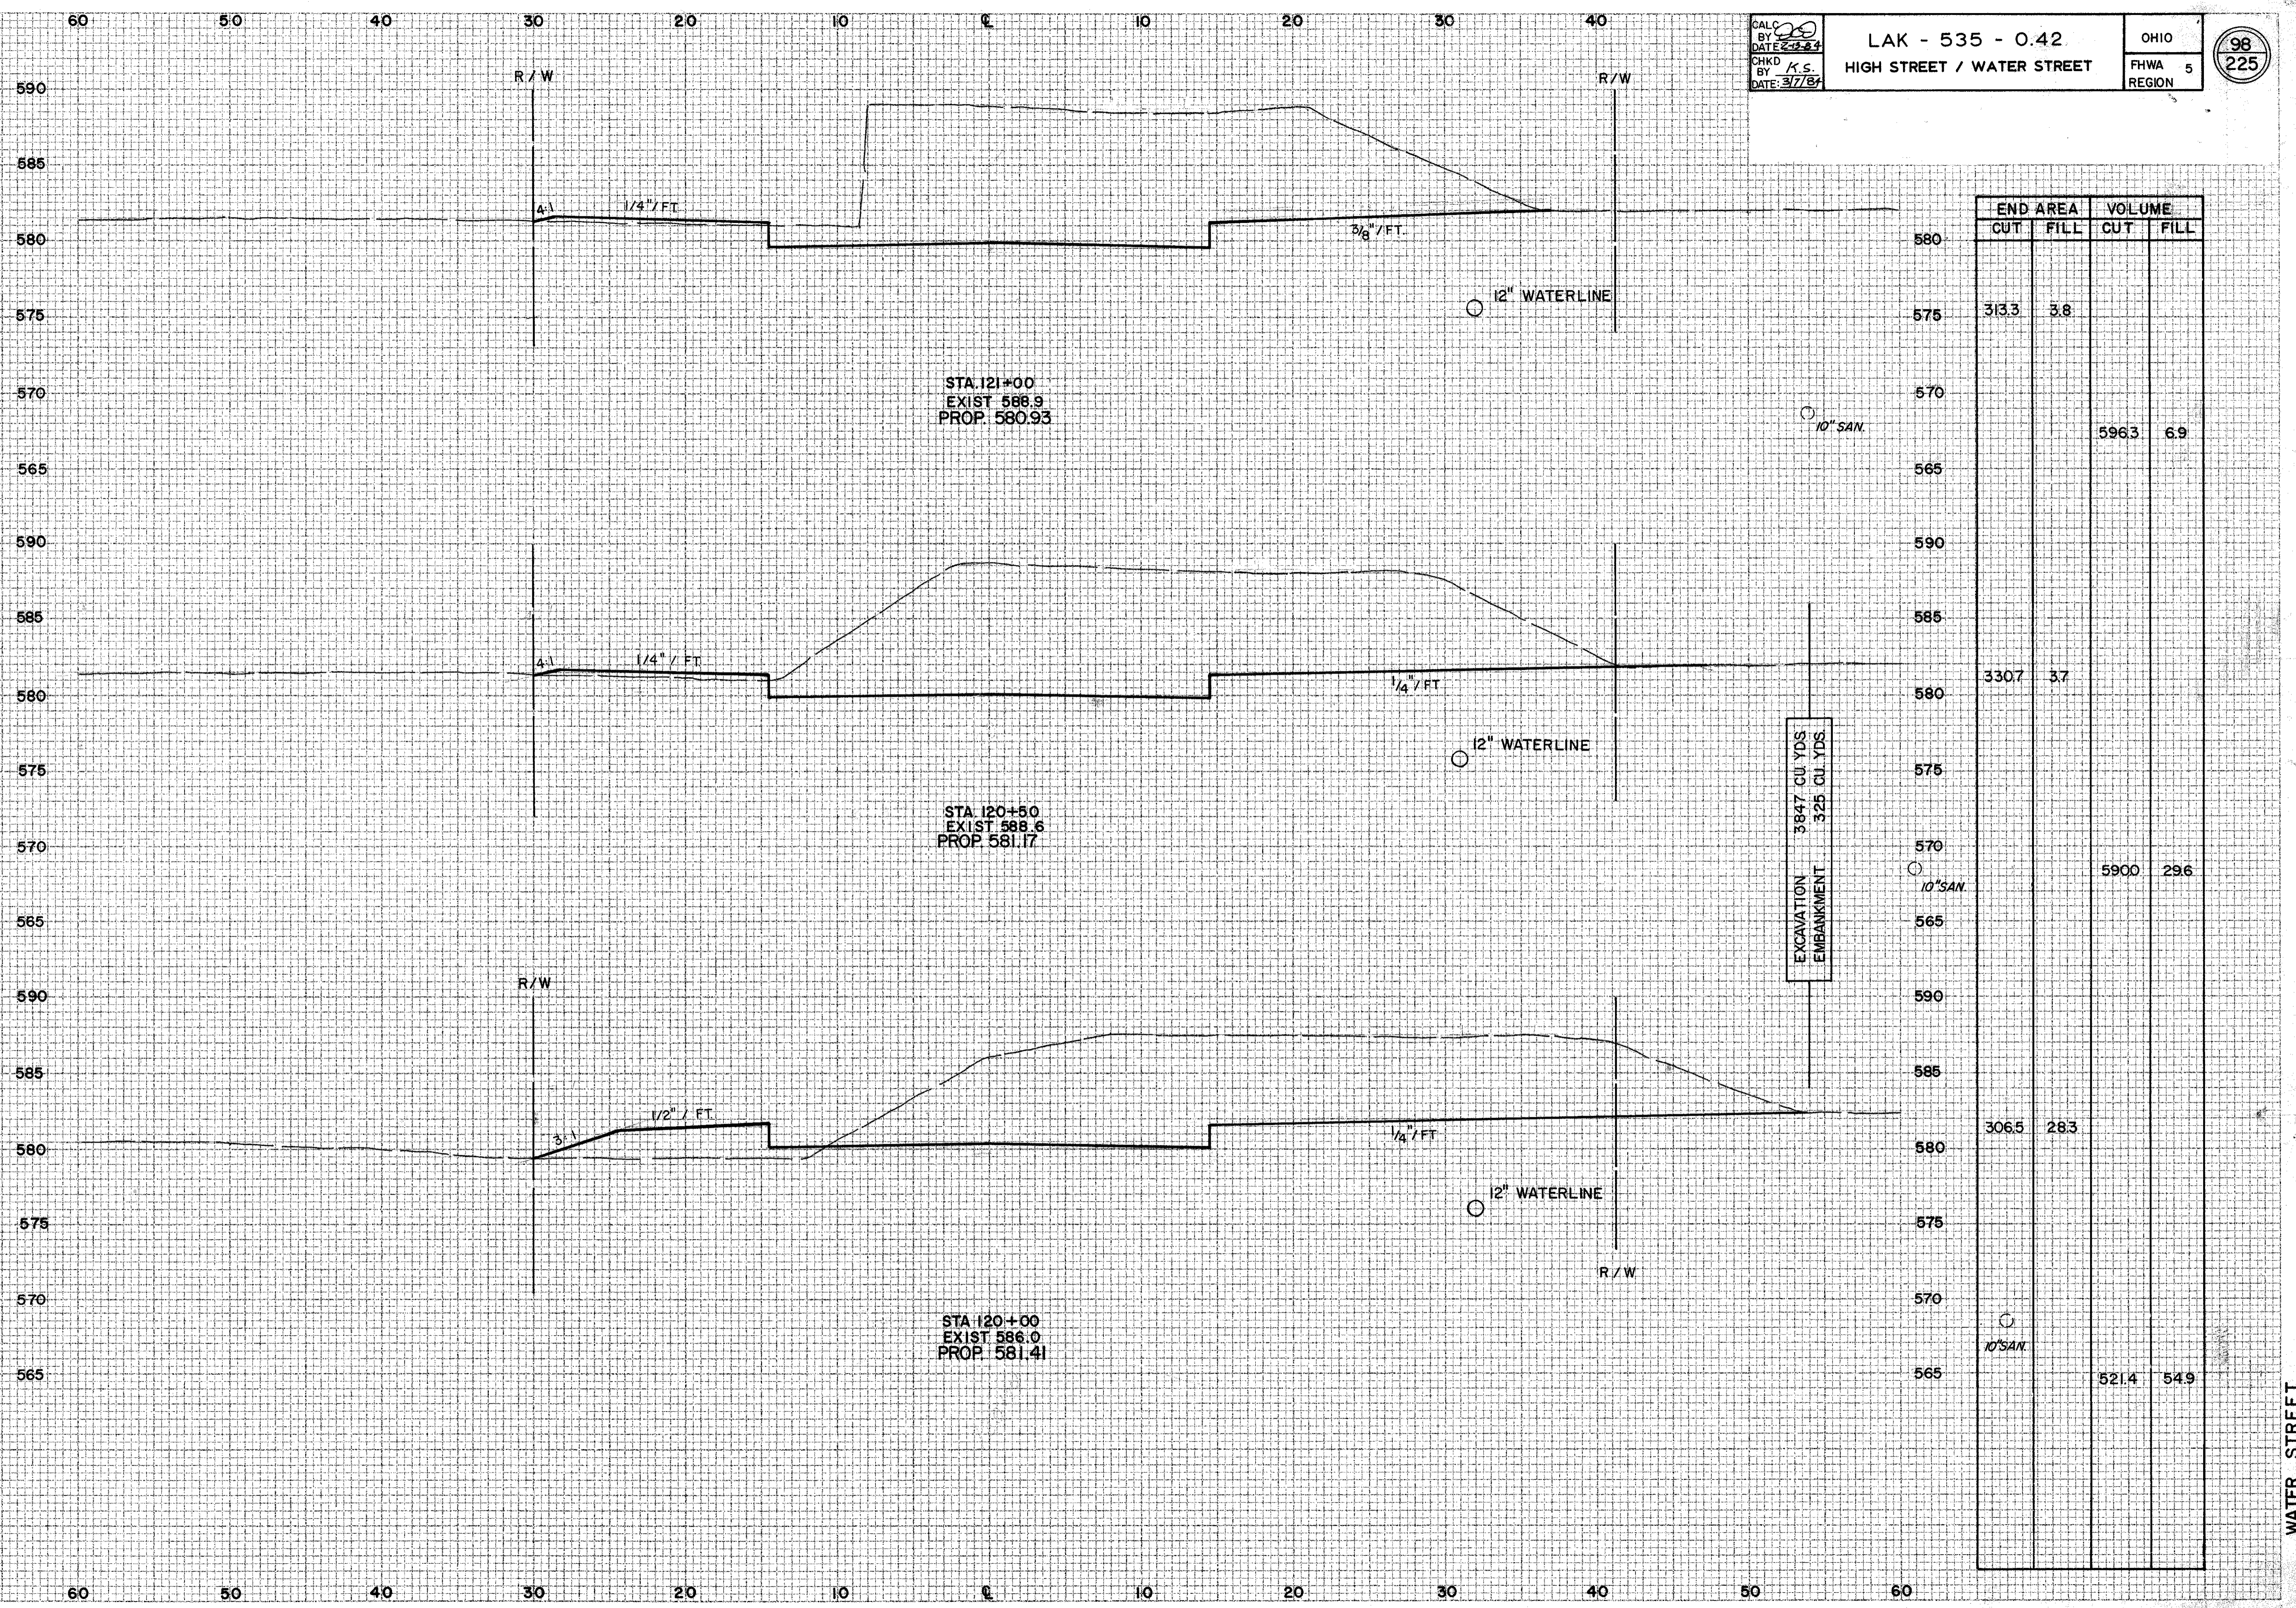

ELEVATION	END AREA		VOLUME	
	CUT	FILL	CUT	FILL
580	313.3	3.8		
570			596.3	6.9
580	330.7	3.7		
570			590.0	29.6
580	306.5	28.3		
570			521.4	54.9

WATER STREET