


80 70 60 50 40 30 20 10 0 10 20 30 40

FINAL SURVEY
 SURVEYED BY: *[Signature]*
 DATE: *[Date]*
 CHECKED BY: *[Signature]*
 DATE: *[Date]*
 NO. *[Number]*

ORIGINAL SURVEY
 SURVEYED BY: *[Signature]*
 DATE: *[Date]*
 CHECKED BY: *[Signature]*
 DATE: *[Date]*
 NO. *[Number]*

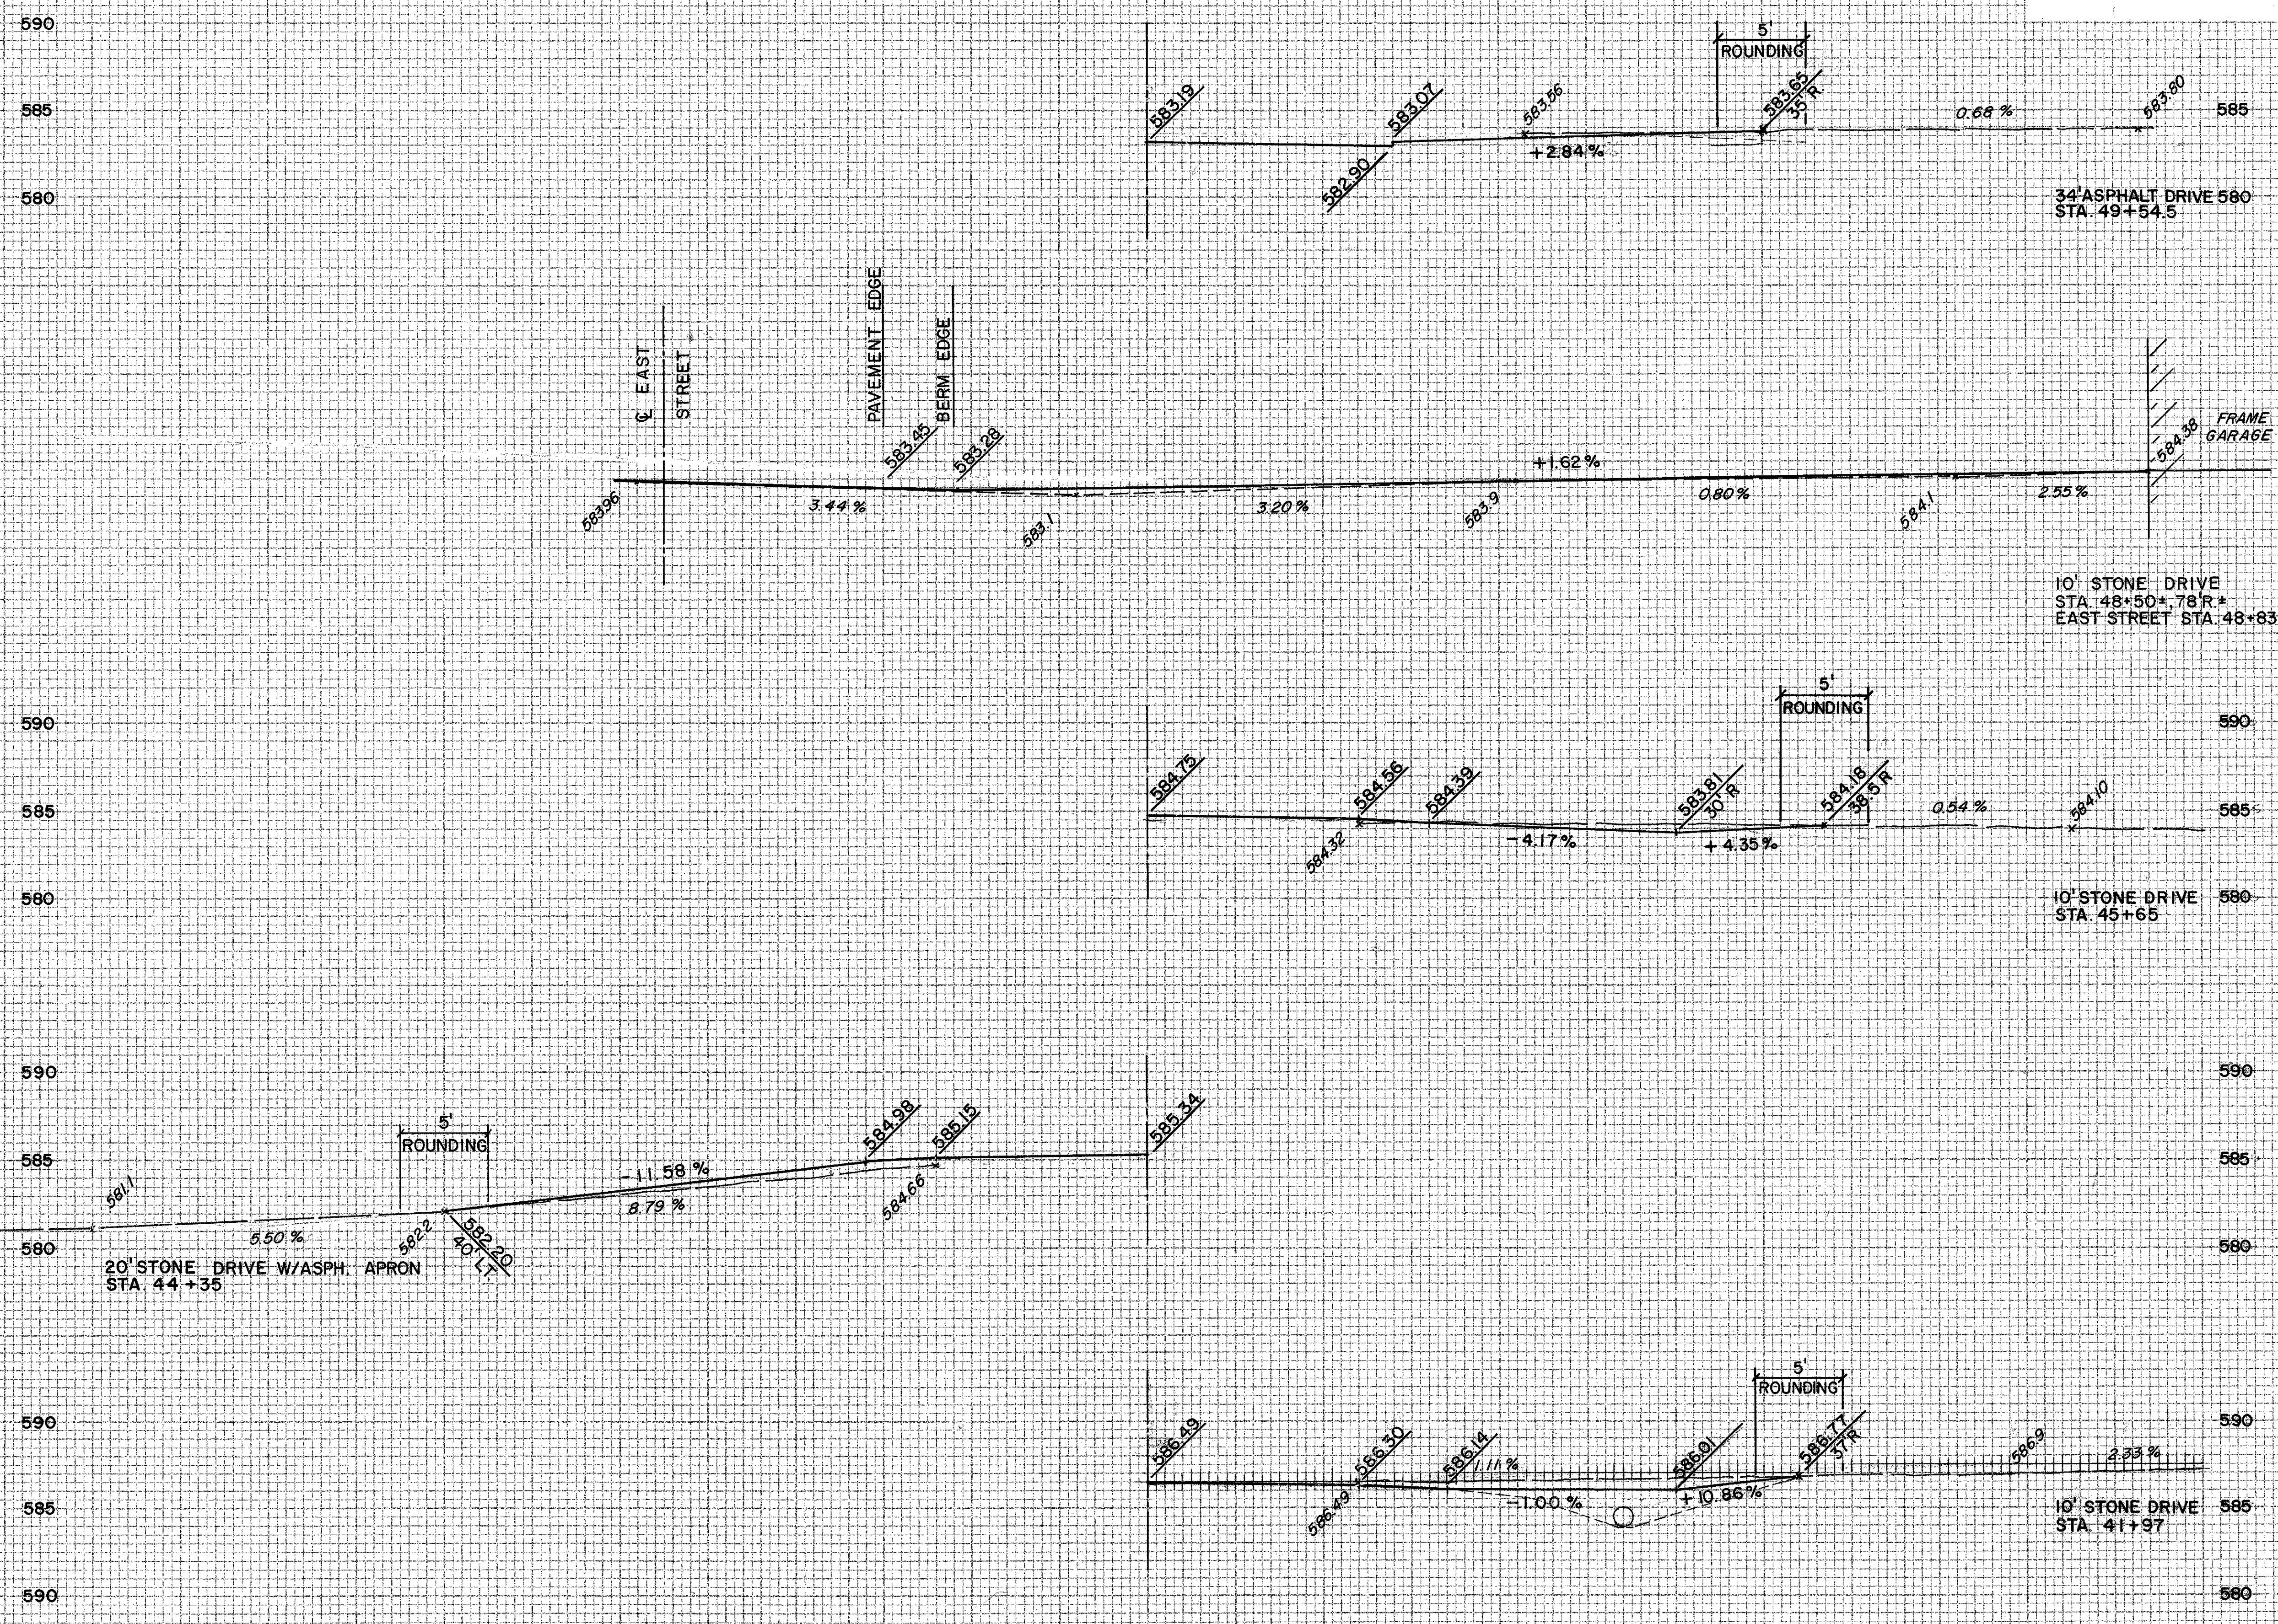

END AREA		VOLUME	
CUT	FILL	CUT	FILL
		14.4	0
		23.1	0
		11.1	0
		22.1	0
		8.1	9.3

DRIVE PROFILES