


FINAL SURVEY PLANNED
 NO. 1
 NO. 2
ORIGINAL SURVEY PLANNED
 NO. 1
 NO. 2
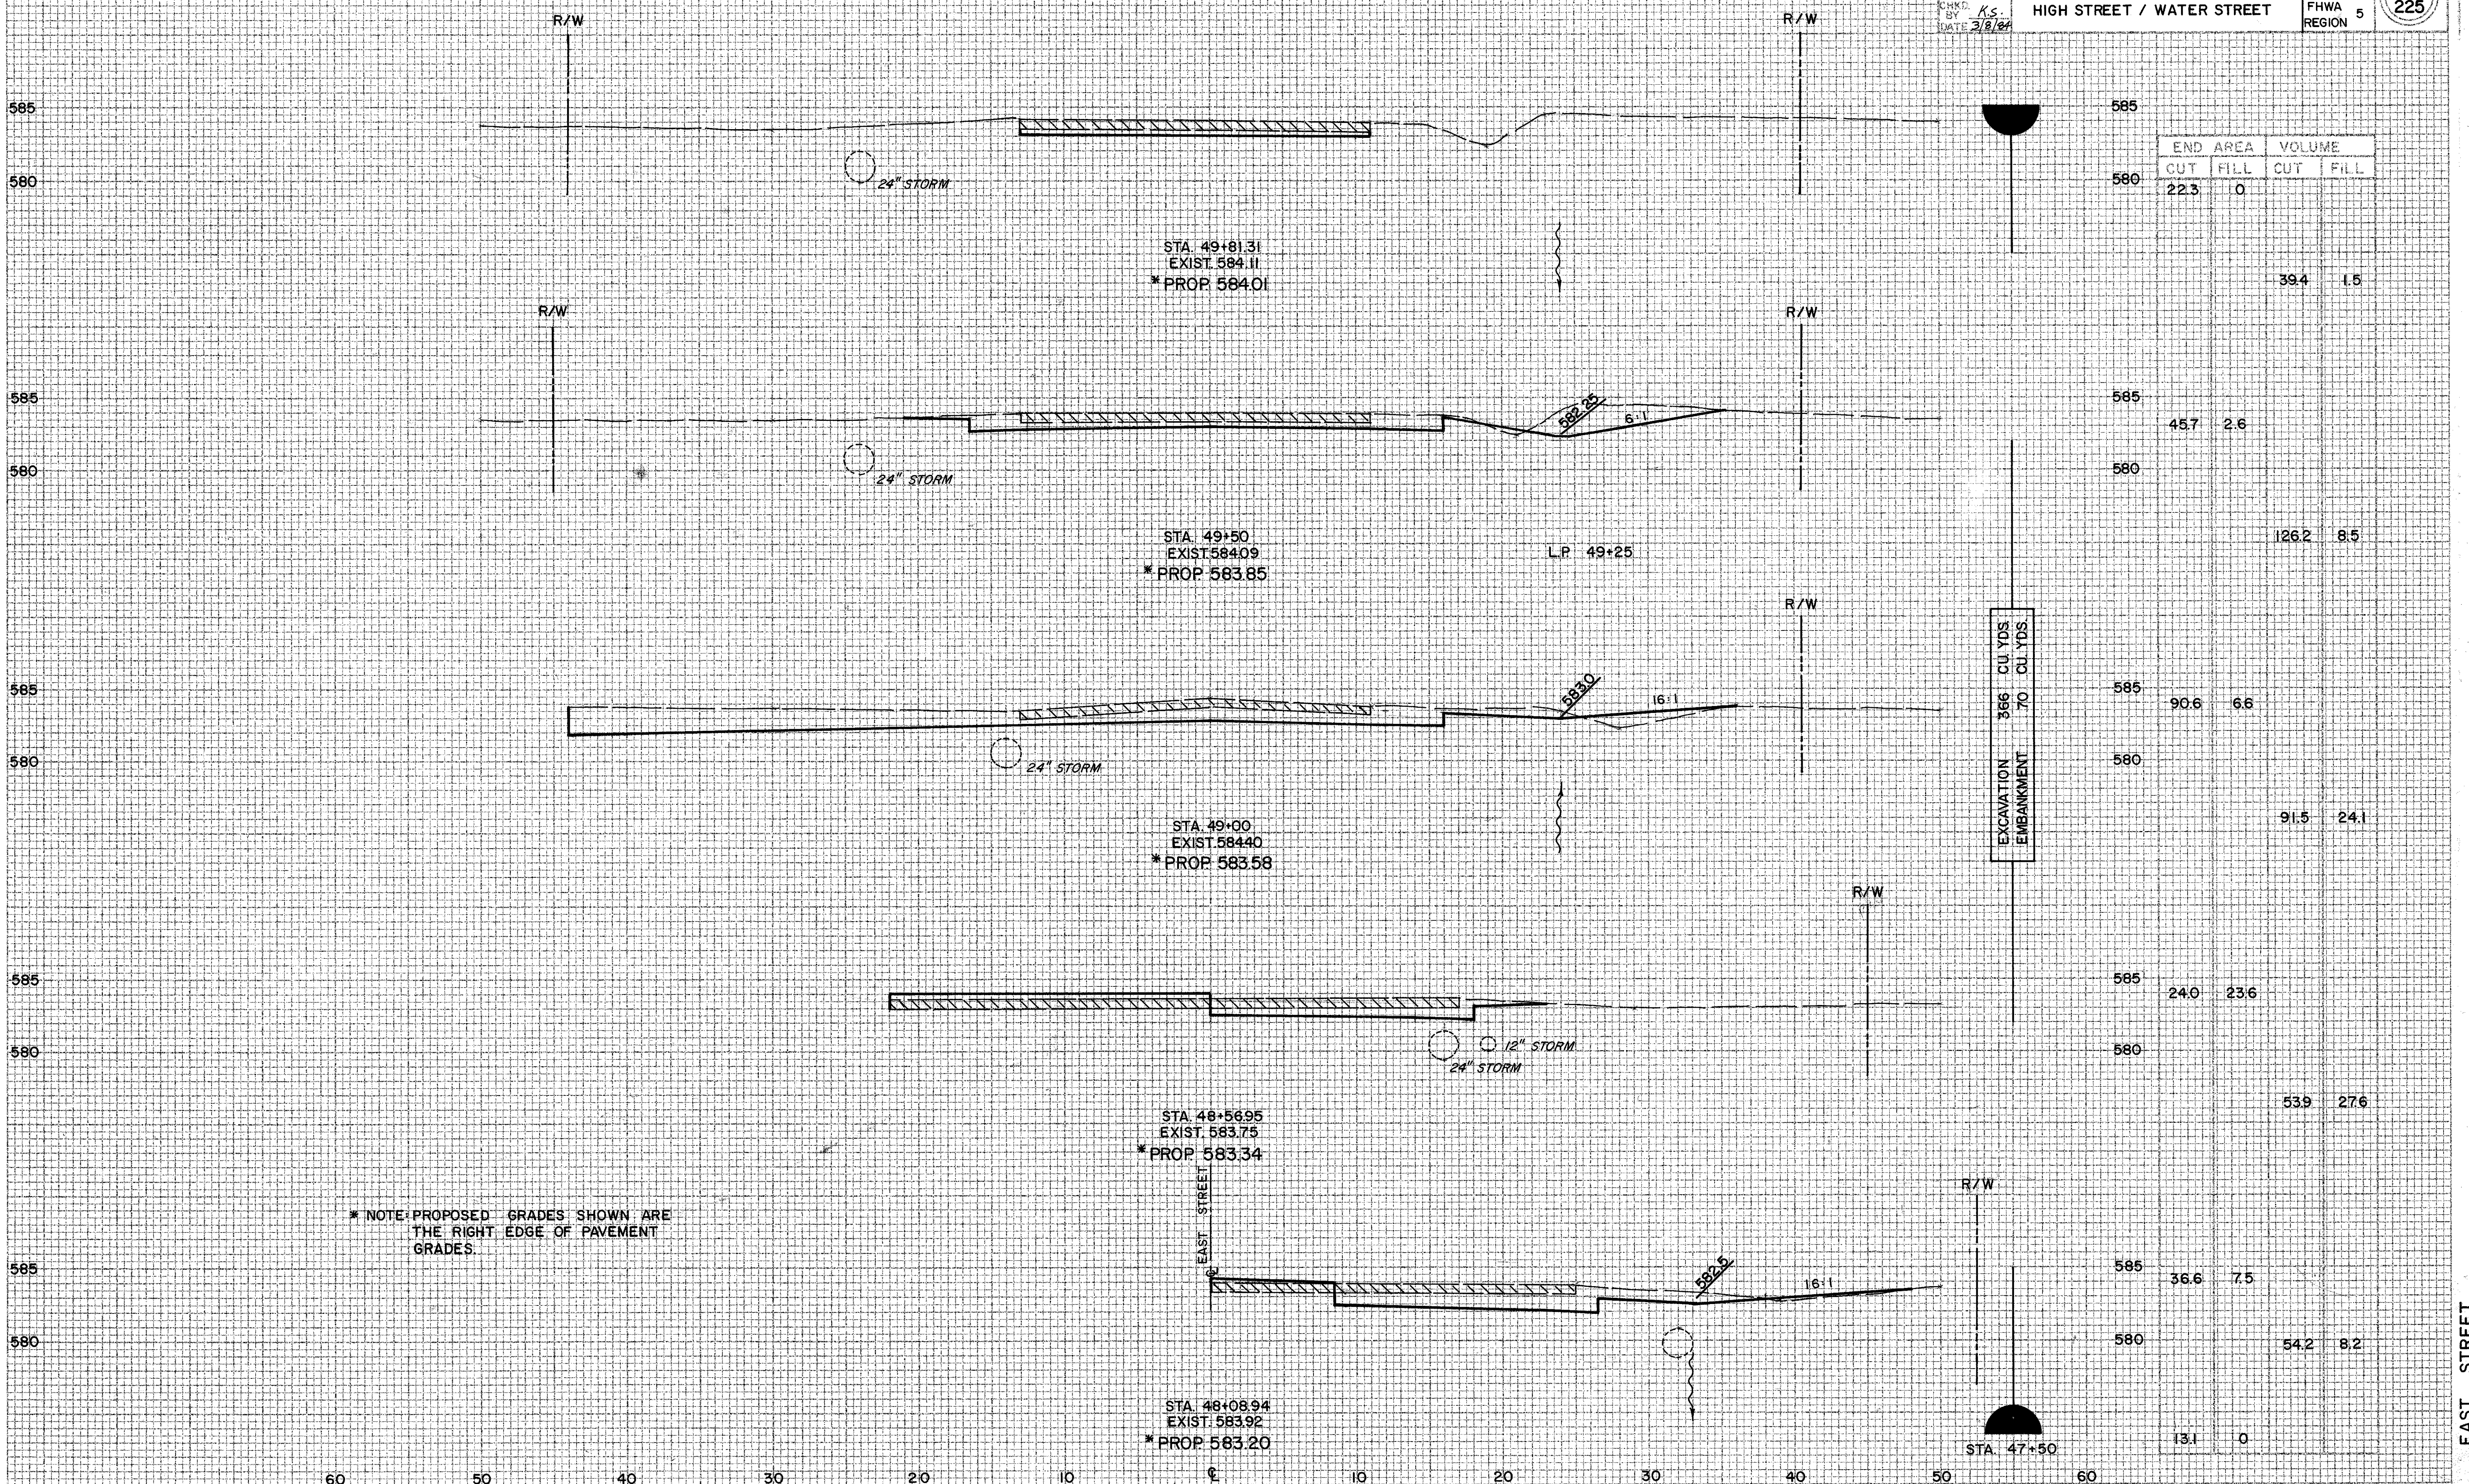

END	AREA		VOLUME	
	CUT	FILL	CUT	FILL
585	22.3	0		
580			39.4	1.5
585	45.7	2.6		
580			126.2	8.5
585	90.6	6.6		
580			91.5	24.1
585	24.0	23.6		
580			53.9	27.6
585	36.6	7.5		
580			54.2	8.2
585	13.1	0		

* NOTE: PROPOSED GRADES SHOWN ARE THE RIGHT EDGE OF PAVEMENT GRADES.

EAST STREET