

CALC. BY: *JK*
 DATE: *4/10/04*
 CHKD. BY: *KS*
 DATE: *3/7/04*


LAK - 535 - 0.42
 HIGH STREET / WATER STREET

OHIO
 FHWA REGION 5

117
 225

WATERWORKS		604	
REF	LOCATION	EA.	
W-1	2+08.5, 28.5'R.	1	
TOTALS		1	

DRAINAGE		603	603	604	604	605	605	604		
REF	LOCATION	LF.	LF.	EA.	EA.	LF.	LF.	EA.		
D-1	2+48.5, 19.6'L. - 2+49.07, 23.42'R.	41.5								
D-2	1+78.5, 25.6'R. - 2+49.07, 23.42'R.	70.5								
D-3	2+48.5, 19.6'L.			1						
D-4	2+49.07, 23.42'R.			1						
D-5	1+78.5, 25.6'R. (STORM)				1					
D-6	2+16, 1'L. (SANITARY)							1		
D-7	0+32, 37'L. - 2+66, 20'L.		20			152				
D-8	0+28, 34'R. - 1+86, 20'R.		10			117				
D-9	1+86, 20'R. - 2+03, 64'R.						53			
D-10	2+32, 64'R. - 2+49, 24'R.		10				36			
D-11	2+49, 24'R. - 2+66, 21'R.		10			7				
TOTALS		112	50	2	1	276	89	1		

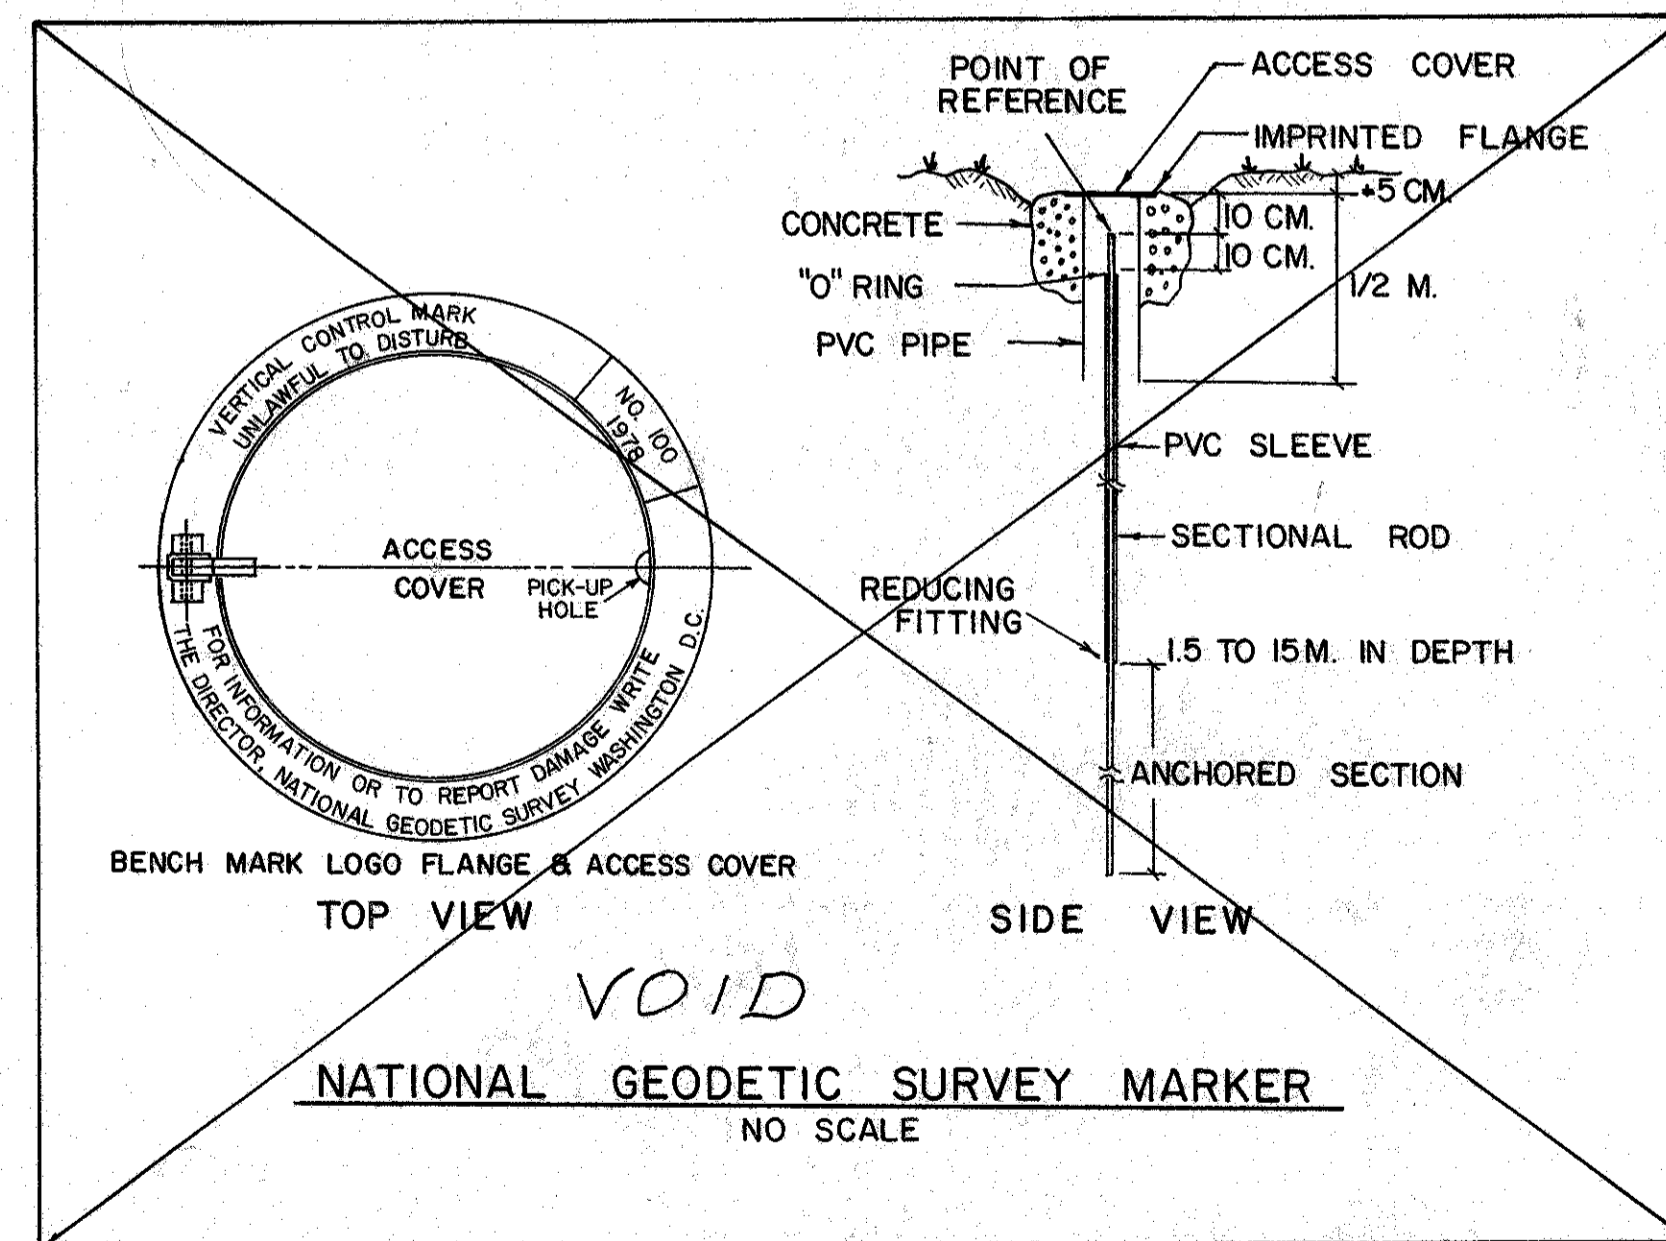

ROADWAY		202	202	202	202	202	202		
REF	LOCATION	SY.	LF.	SF.	LF.	EA.	EA.		
R-1	0+35, 80'R.	34							
R-2	0+37, 71'R. - 2+04, 67'R.		195						
R-3	0+17, 40'R. - 2+66, 19.6'L.		218						
R-4	2+30, 67'R. - 2+66, 19.8'R.		76						
R-5	0+40, 81'R. - 2+04, 34'R.			785					
R-6	1+90, 20.5'R. - 34'R.			67.5					
R-7	2+43, 23'R. - 34'R.			55					
R-8	2+30-2+66, 34'R.			180					
R-9	0+12, 51'R. - 0+36, 80'R.			47					
R-10	0+12, 51'R.					1			
R-11	0+34, 76'R.					1			
R-12	0+72, 36'R. - 1+05, 22'R.	66							
R-13	1+19, 20'R. - 1+87, 20'R.	31							
R-14	0+32, 88'R.						1		
TOTALS		131	489	1087.5	47	2	1		