


60 50 40 30 20 10 0 10 20 30 40

FINAL SURVEY  
 SHEET NO. 1  
 DATE: 3/22/22  
 BY: K.S.  
 PROJECT: LAK-535-0.42  
 SHEET: 128 OF 225

ORIGINAL SURVEY  
 SHEET NO. 1  
 DATE: 3/22/22  
 BY: K.S.  
 PROJECT: LAK-535-0.42  
 SHEET: 128 OF 225

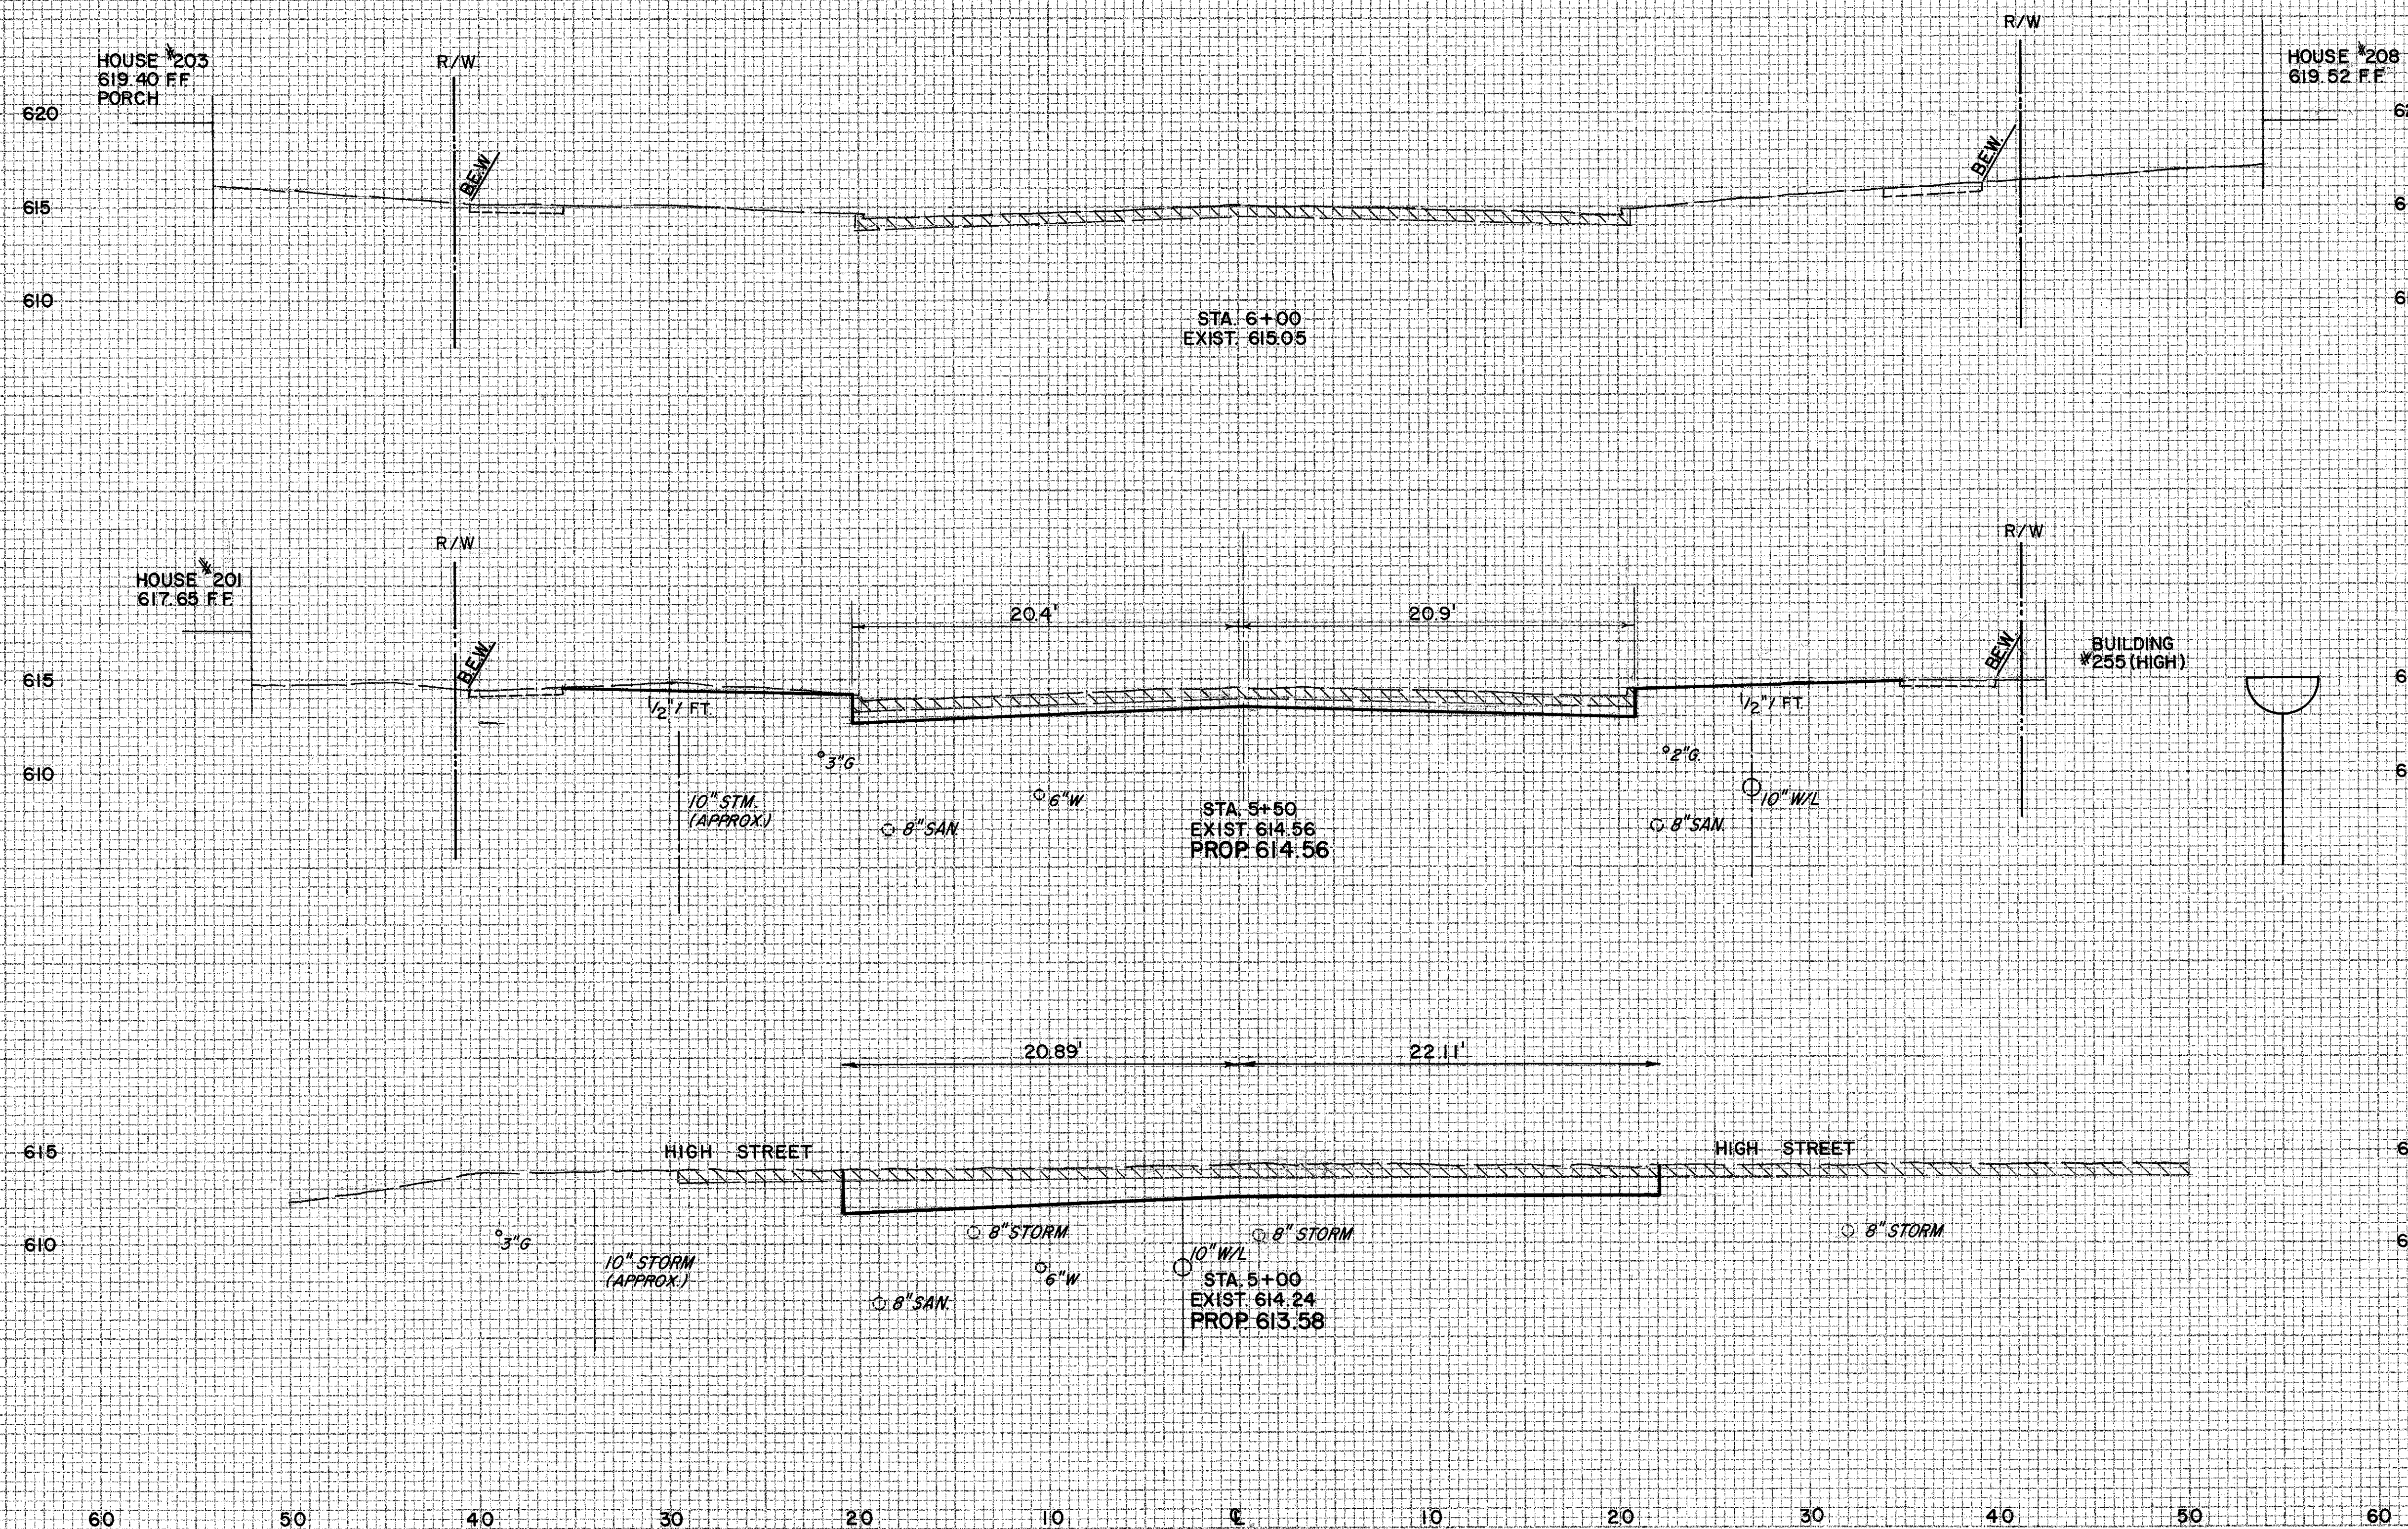

END AREA		VOLUME	
CUT	FILL	CUT	FILL
22.6	0		
		72.5	0
55.7	0		
		84.1	6.3

SECOND STREET