

CEMETERY
Willoughby Township Trustees

Leon E. Smith

James Bailey

SCHRAMS CORNERS

Wm. J. Smith

Wm. J. Smith

Leon E. Smith

Wm. C. & Anna L. Wieland

James Bailey

Willoughby Township Board of Education

Vertical Curve

Vertical Curve

Vertical Curve

Vertical Curve

Vertical Curve

Vertical Curve


Grading Sta. 50 to Sta. 60
Cut = 1091.5 Cu.Yds.
Fill = 1733 "

Grading Sta. 60 to Sta. 70
Cut = 580.9 Cu.Yds.
Fill = 2734 "

Grading Sta. 70 to Sta. 80
Cut = 1423 Cu.Yds.
Fill = 5152 "

I hereby approve that the making require the closing and that the designs as shown

End of Contract Sec. A
Beginning of Sec. B.

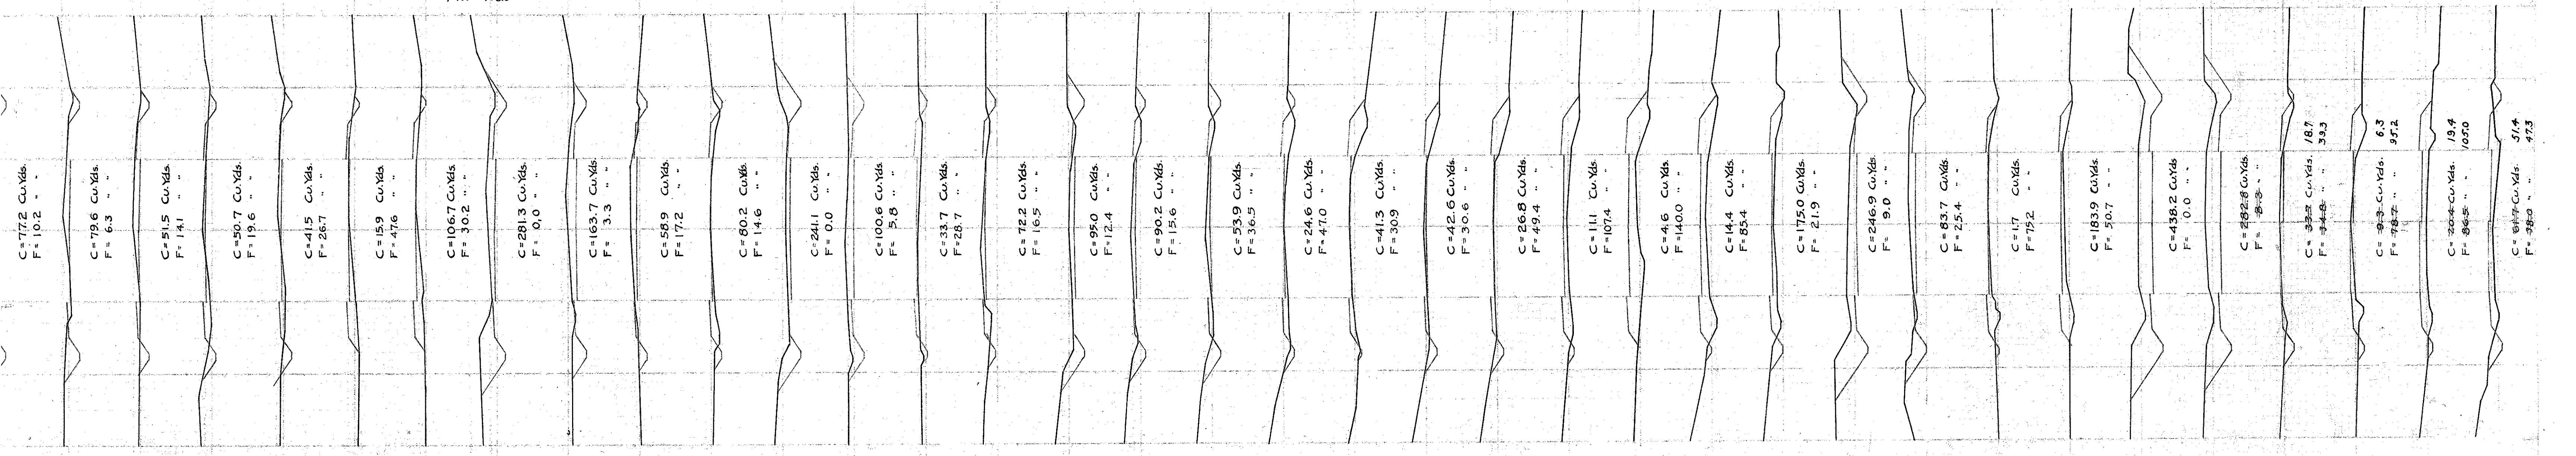

C=77.2 Cu.Yds. F=10.2 "	C=79.6 Cu.Yds. F=6.3 "	C=51.5 Cu.Yds. F=14.1 "	C=50.7 Cu.Yds. F=19.6 "	C=41.5 Cu.Yds. F=26.7 "	C=15.9 Cu.Yds. F=47.6 "	C=106.7 Cu.Yds. F=30.2 "	C=281.3 Cu.Yds. F=0.0 "	C=163.7 Cu.Yds. F=3.3 "	C=58.9 Cu.Yds. F=17.2 "	C=80.2 Cu.Yds. F=14.6 "	C=241.1 Cu.Yds. F=0.0 "	C=100.6 Cu.Yds. F=5.8 "	C=33.7 Cu.Yds. F=28.7 "	C=72.2 Cu.Yds. F=16.5 "	C=95.0 Cu.Yds. F=12.4 "	C=90.2 Cu.Yds. F=15.6 "	C=53.9 Cu.Yds. F=36.5 "	C=24.6 Cu.Yds. F=47.0 "	C=41.3 Cu.Yds. F=30.9 "	C=42.6 Cu.Yds. F=30.6 "	C=26.8 Cu.Yds. F=49.4 "	C=11.1 Cu.Yds. F=107.4 "	C=4.6 Cu.Yds. F=140.0 "	C=14.4 Cu.Yds. F=85.4 "	C=175.0 Cu.Yds. F=21.9 "	C=246.9 Cu.Yds. F=9.0 "	C=83.7 Cu.Yds. F=25.4 "	C=17 Cu.Yds. F=152 "	C=183.9 Cu.Yds. F=50.7 "	C=438.2 Cu.Yds. F=0.0 "	C=282.8 Cu.Yds. F=8.3 "	C=33.3 Cu.Yds. F=34.8 "	C=8.3 Cu.Yds. F=78.7 "	C=26.4 Cu.Yds. F=86.5 "	C=117.7 Cu.Yds. F=38.0 "


49 50 51 52 53 54 55 56 57 58 59 60 61 62 63 64 65 66 67 68 69 70 71 72 73 74 75 76 77 78 79 80 81 82 83