

SEEDING SODDING	
WIDTH	AREA
LIN. FT.	SQ. YDS.
69	387
74	428
80	157
85	189
91	590
96	536
97	417
53	

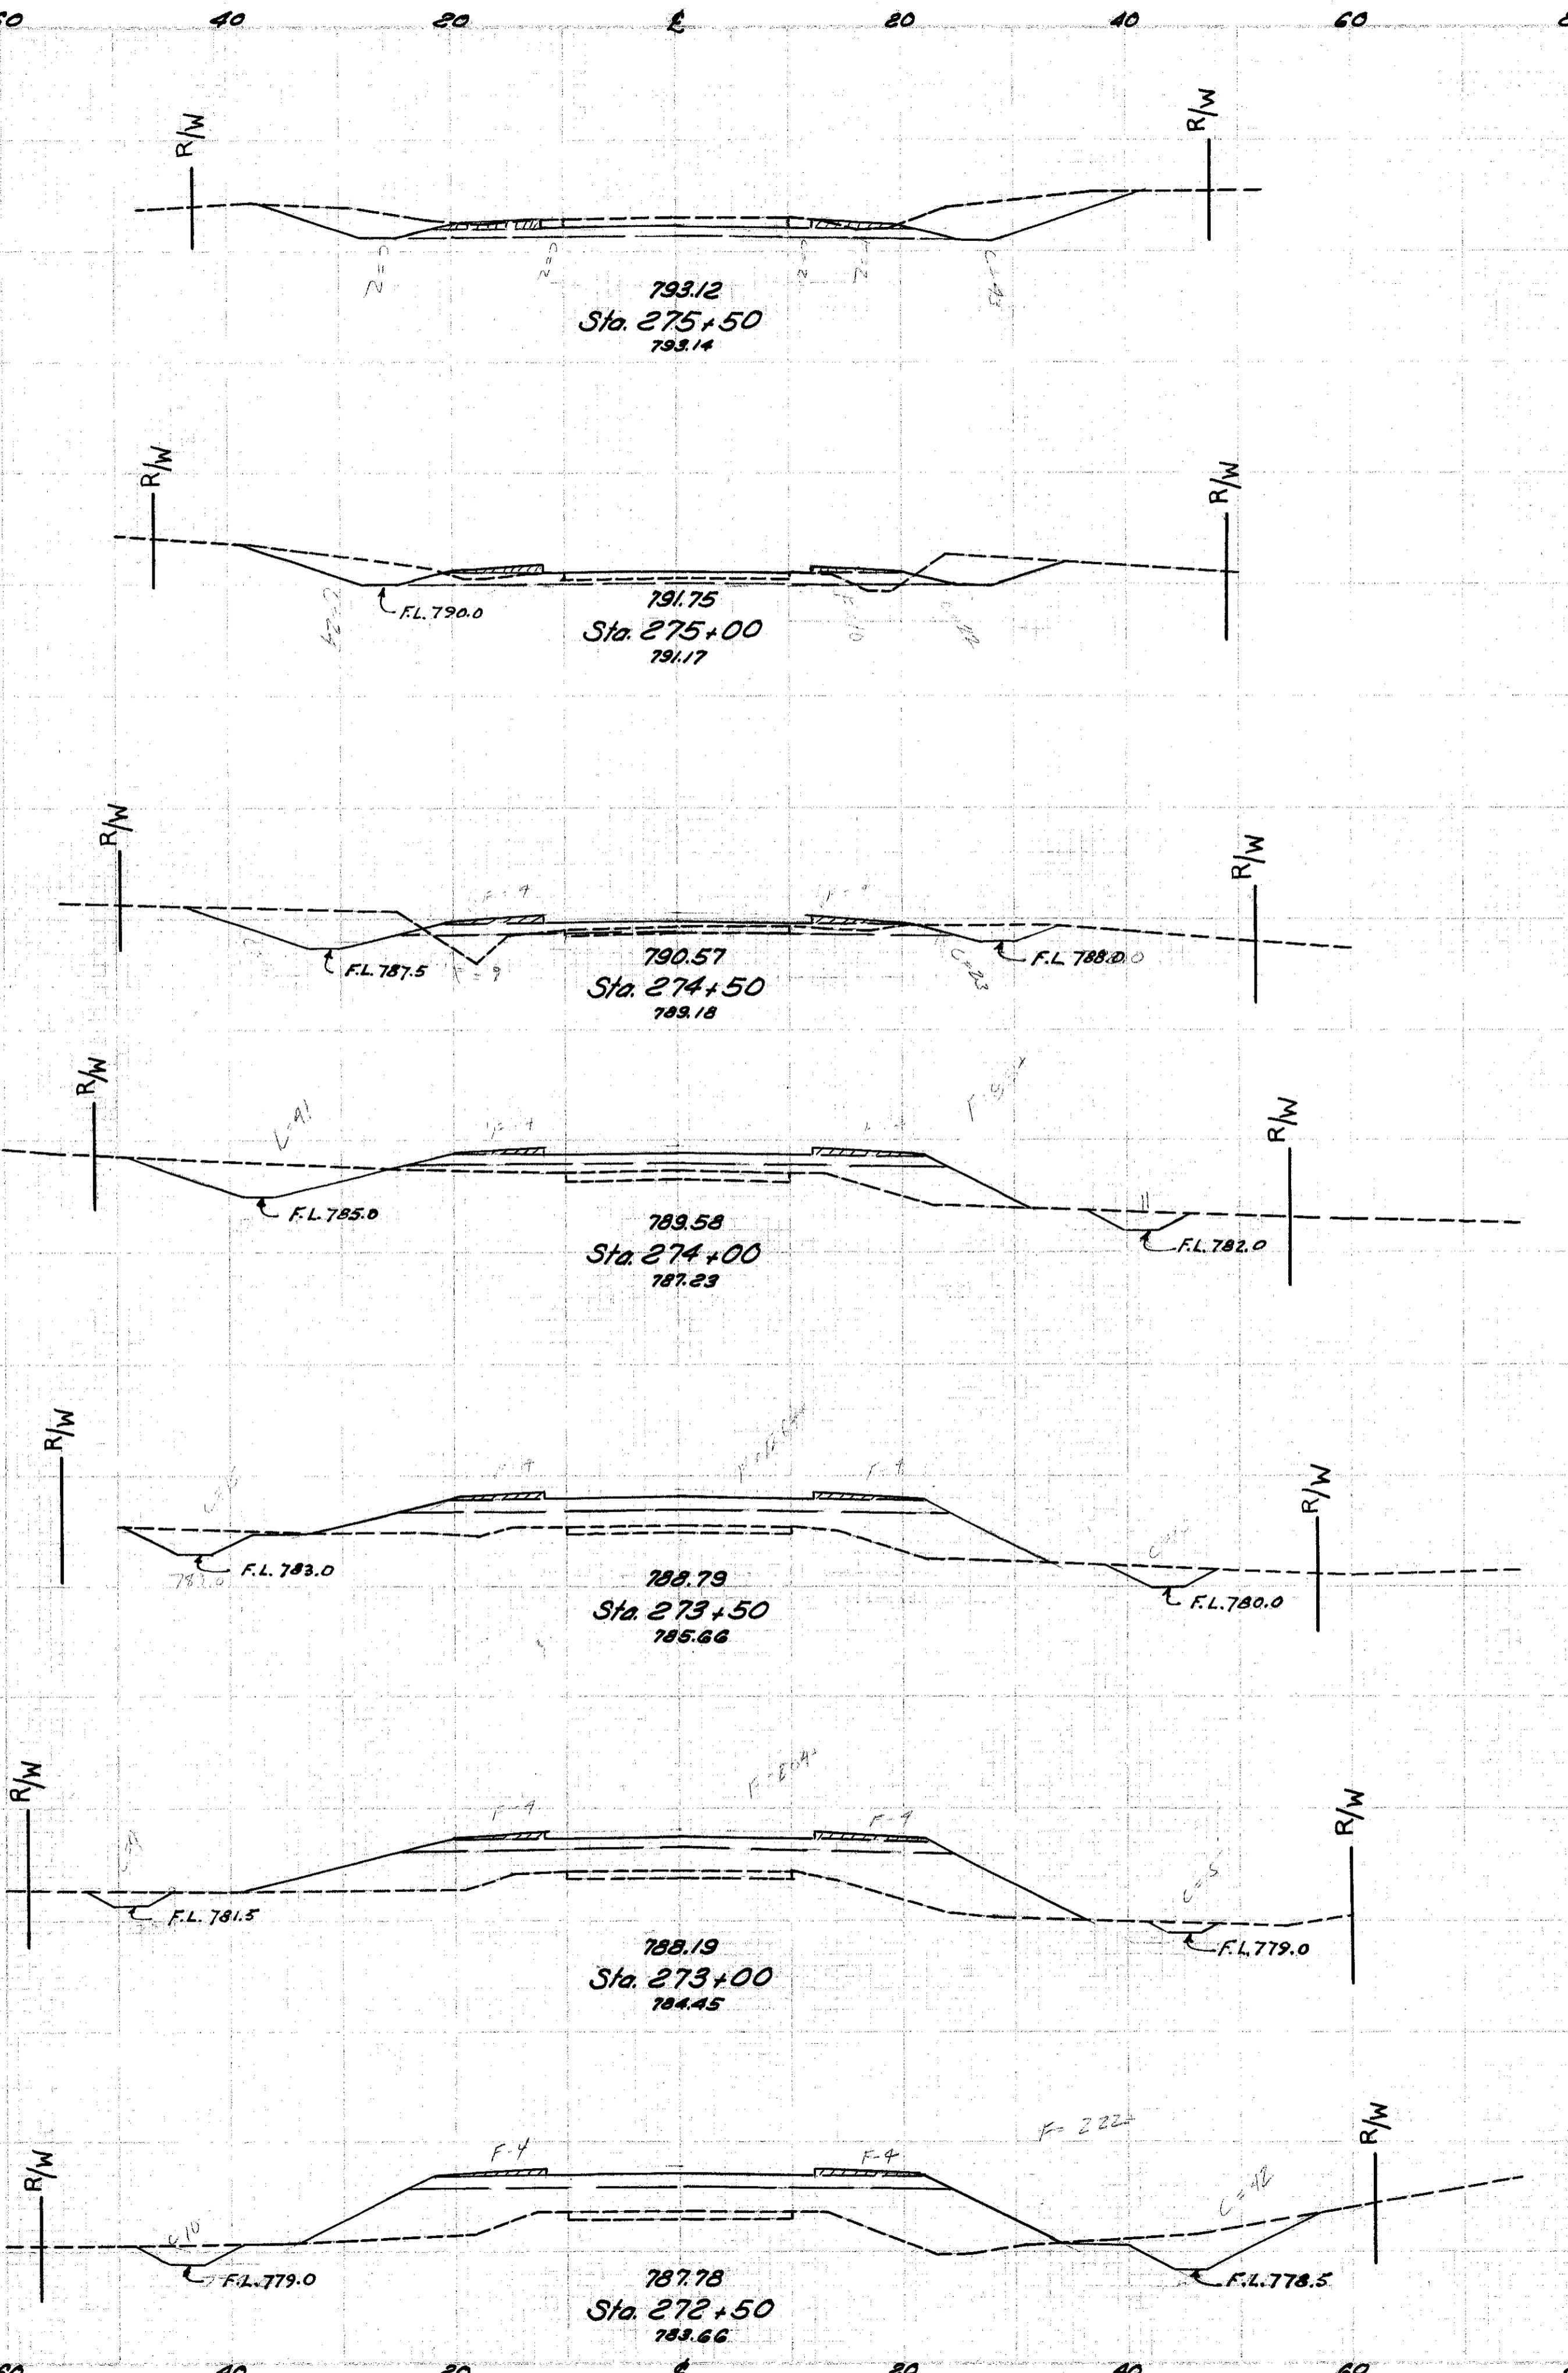


CHART		F-366 (1)		POST	
E COUNTY					
-6 (3.60 - 3.76)					
END AREA	CU. YDS.	CUT	FILL	CUT	FILL
CUT	FILL				
800	19	2			
790				88	17
76		16			
800				105	31
790	68	17			
				111	105
790					
780	52	96			
				72	213
790					
780	25	134			
				35	321
790					
780	12	212			
				60	910
790	52	230			
				98	917
780					
0	0	252			
				180	

CROSS SECTIONS STA. 272+50 TO STA. 275+50