


70 60 50 LEFT 40 30 20 10 0 10 20 30 40 RIGHT 50

LAK. -608 -0.60

SEEDING & SODDING	
WIDTH LIN. FT.	AREA SQ. YDS.

END AREA		CU. YDS.	
CUT	FILL	CUT	FILL

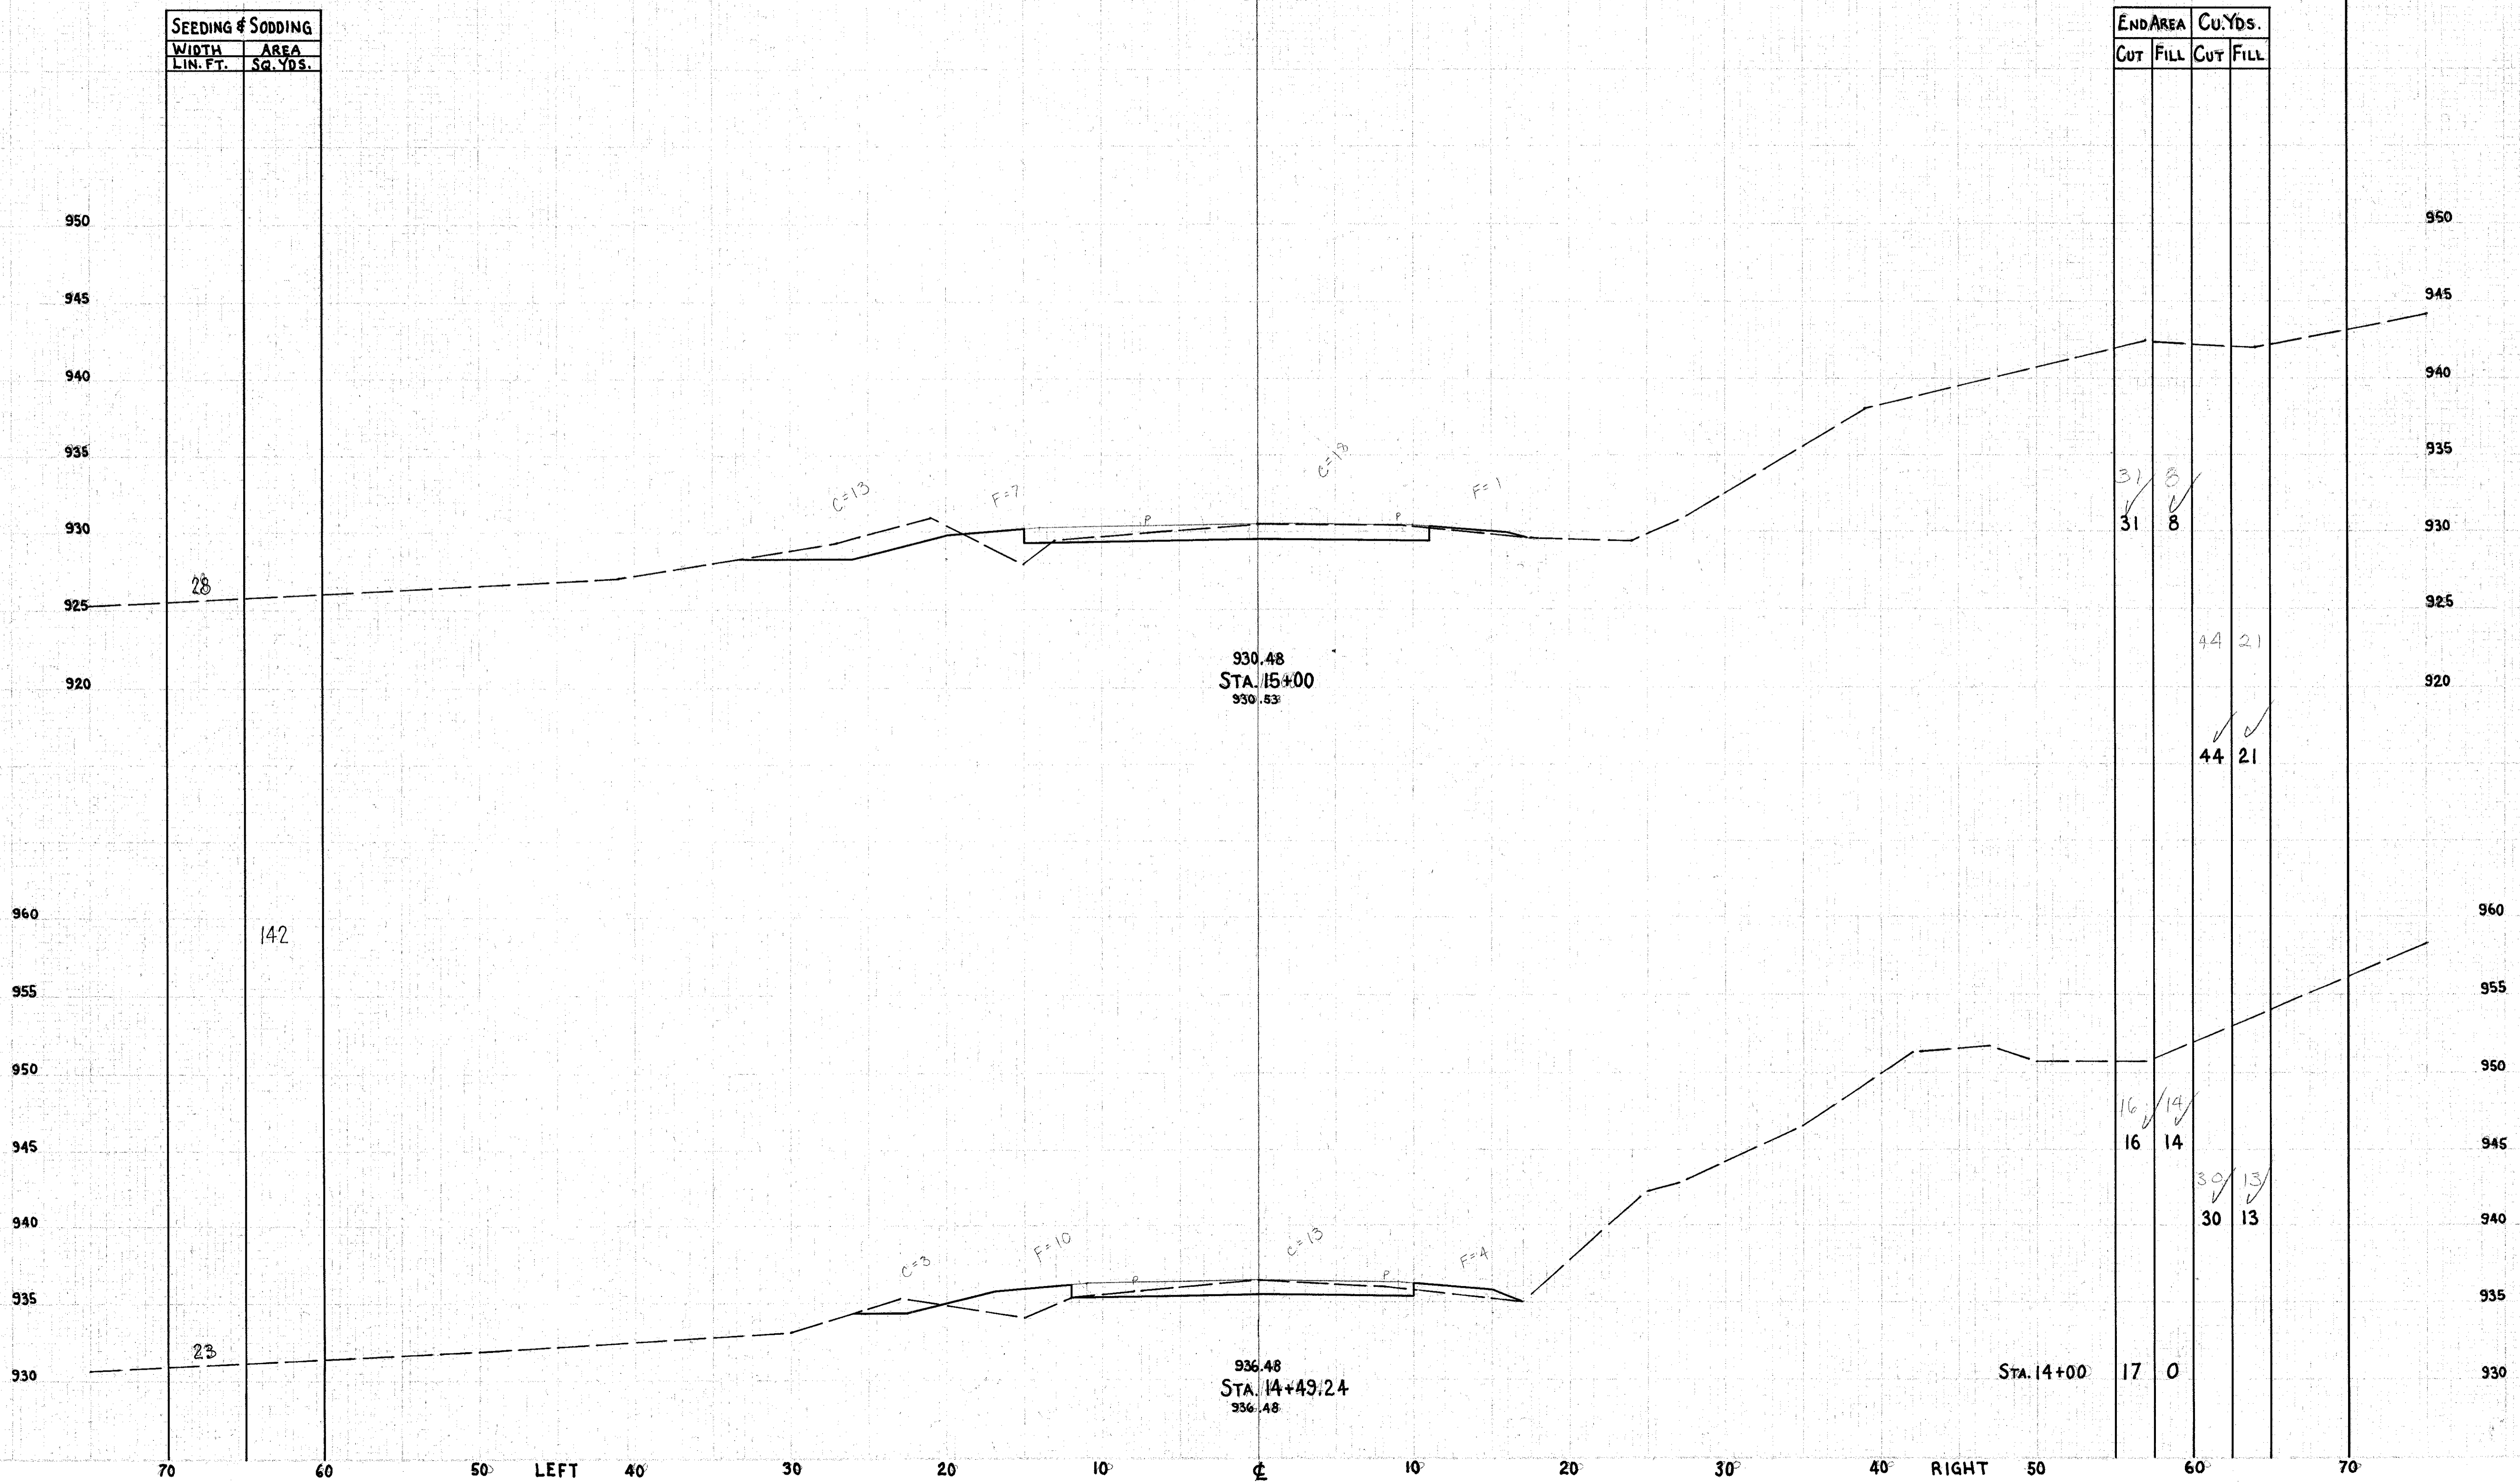

SEEDING & SODDING	
WIDTH LIN. FT.	AREA SQ. YDS.
28	
23	142

END AREA		CU. YDS.	
CUT	FILL	CUT	FILL
31	8	31	8
		44	21
		44	21
16	14	16	14
		30	13
17	0	17	0