


70 60 50 LEFT 40 30 20 10 0 10 20 30 40 RIGHT 50

LAK. -608 -0.60

SEEDING & SODDING	
WIDTH LIN. FT.	AREA SQ. YDS.

END AREA		Cu. Yds.	
CUT	FILL	CUT	FILL

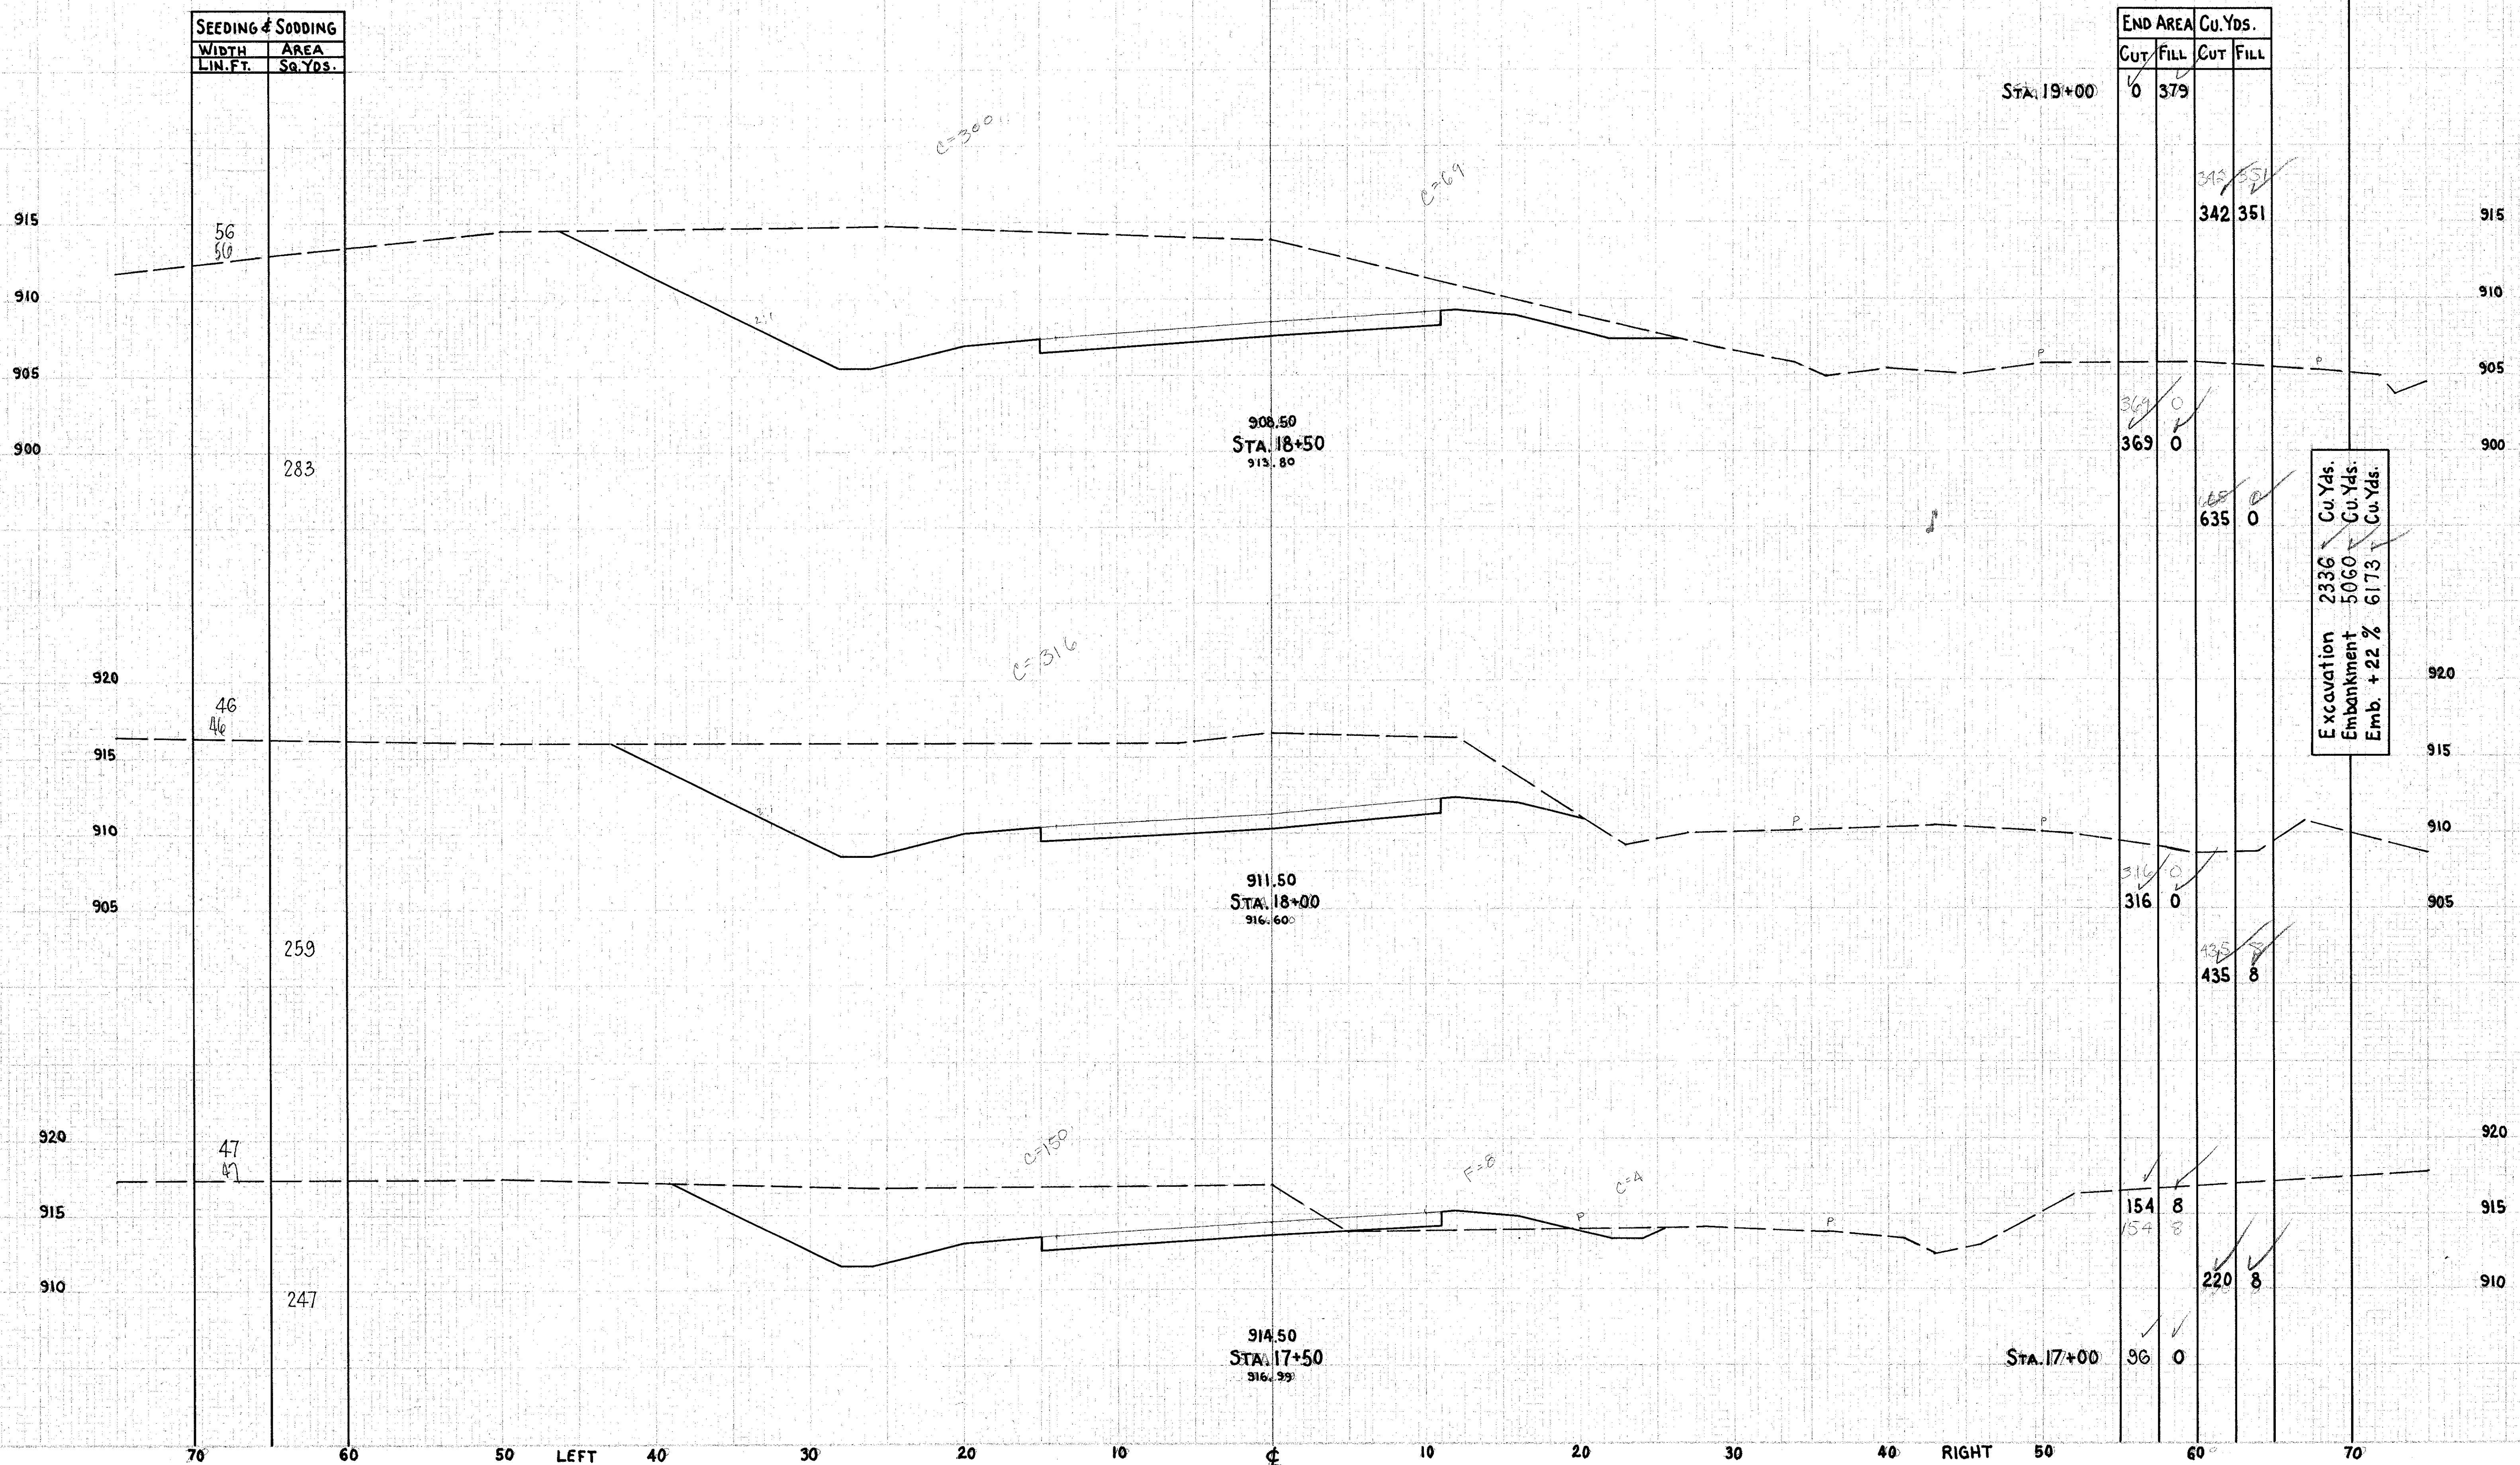

WIDTH LIN. FT.	AREA SQ. YDS.
56	283
46	259
47	247

END AREA		Cu. Yds.	
CUT	FILL	CUT	FILL
0	379	342	351
369	0	635	0
316	0	435	8
154	8	220	8
96	0		

Excavation	2336	Cu. Yds.
Embankment	5060	Cu. Yds.
Emb. + 22 %	6173	Cu. Yds.