



H:\CT\97260\SDSK\306pp.dwg 10/01/99 07:39:45 AM EDT

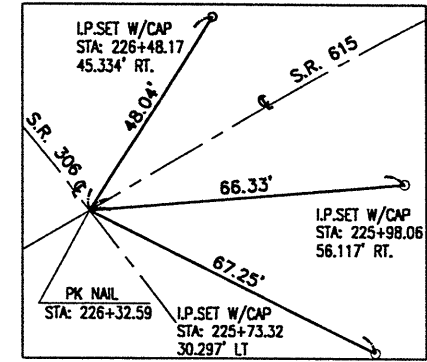

SWTIE#10

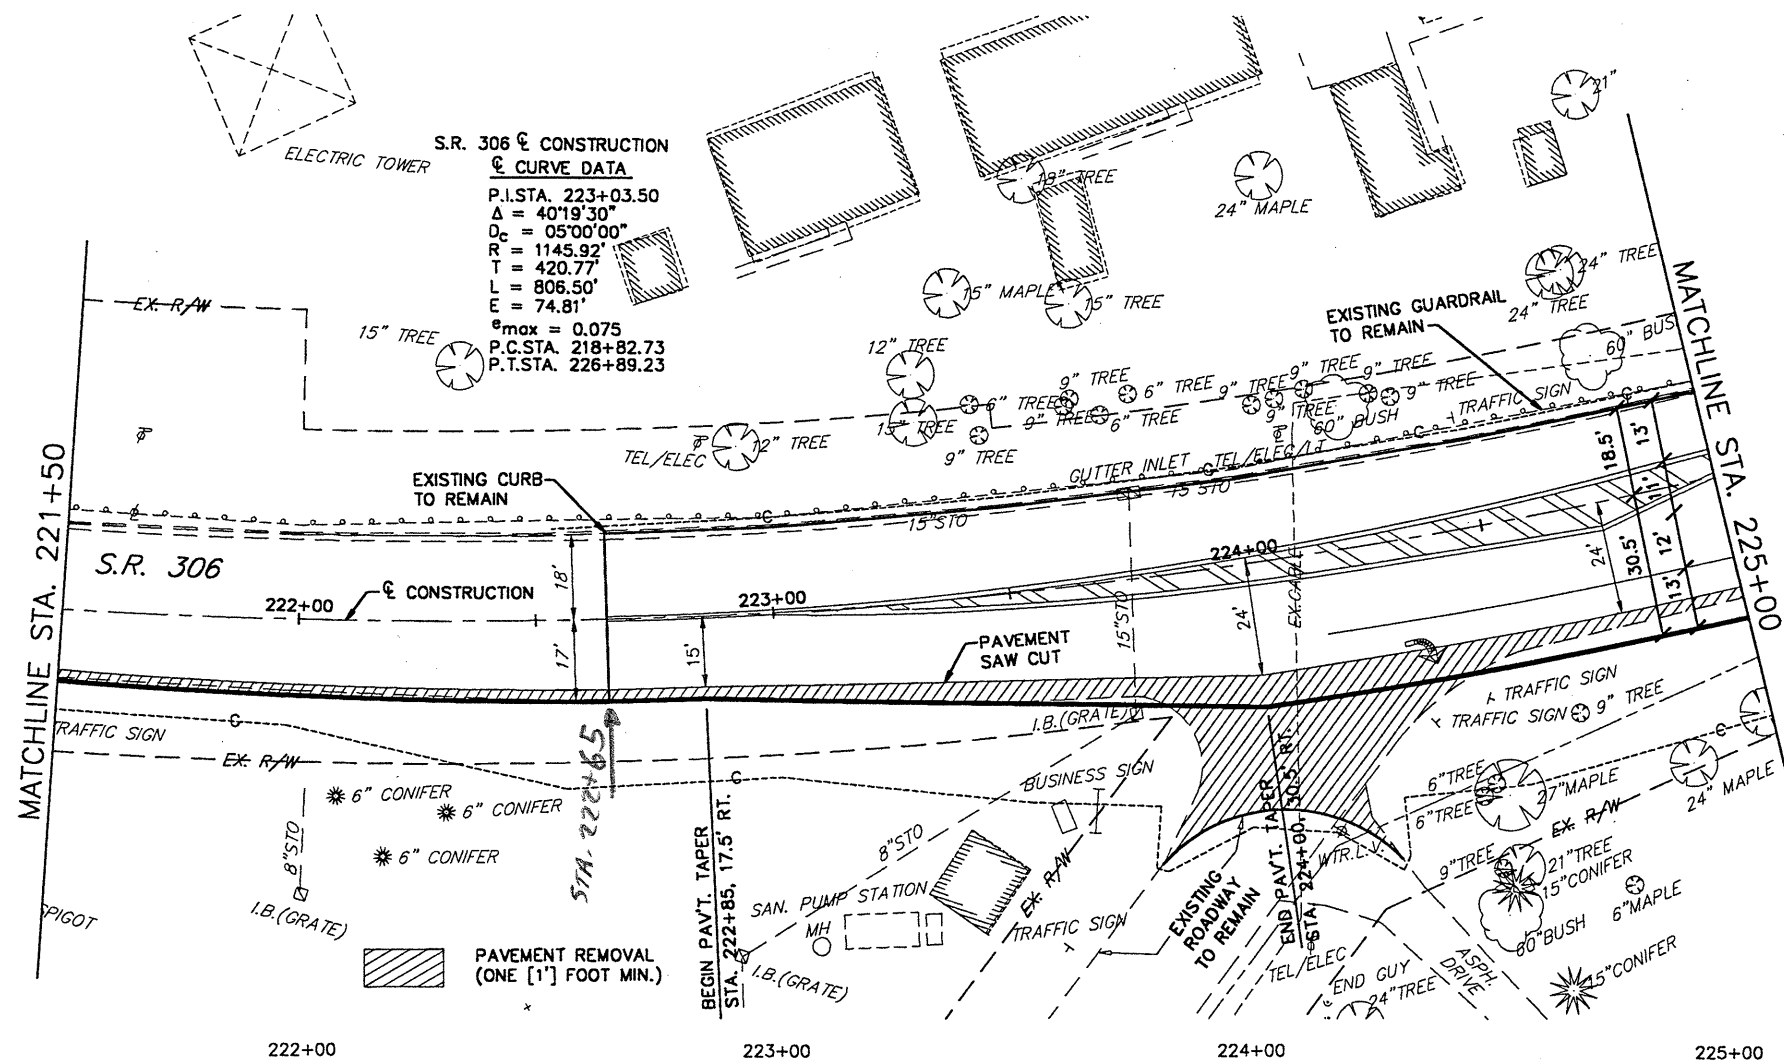