
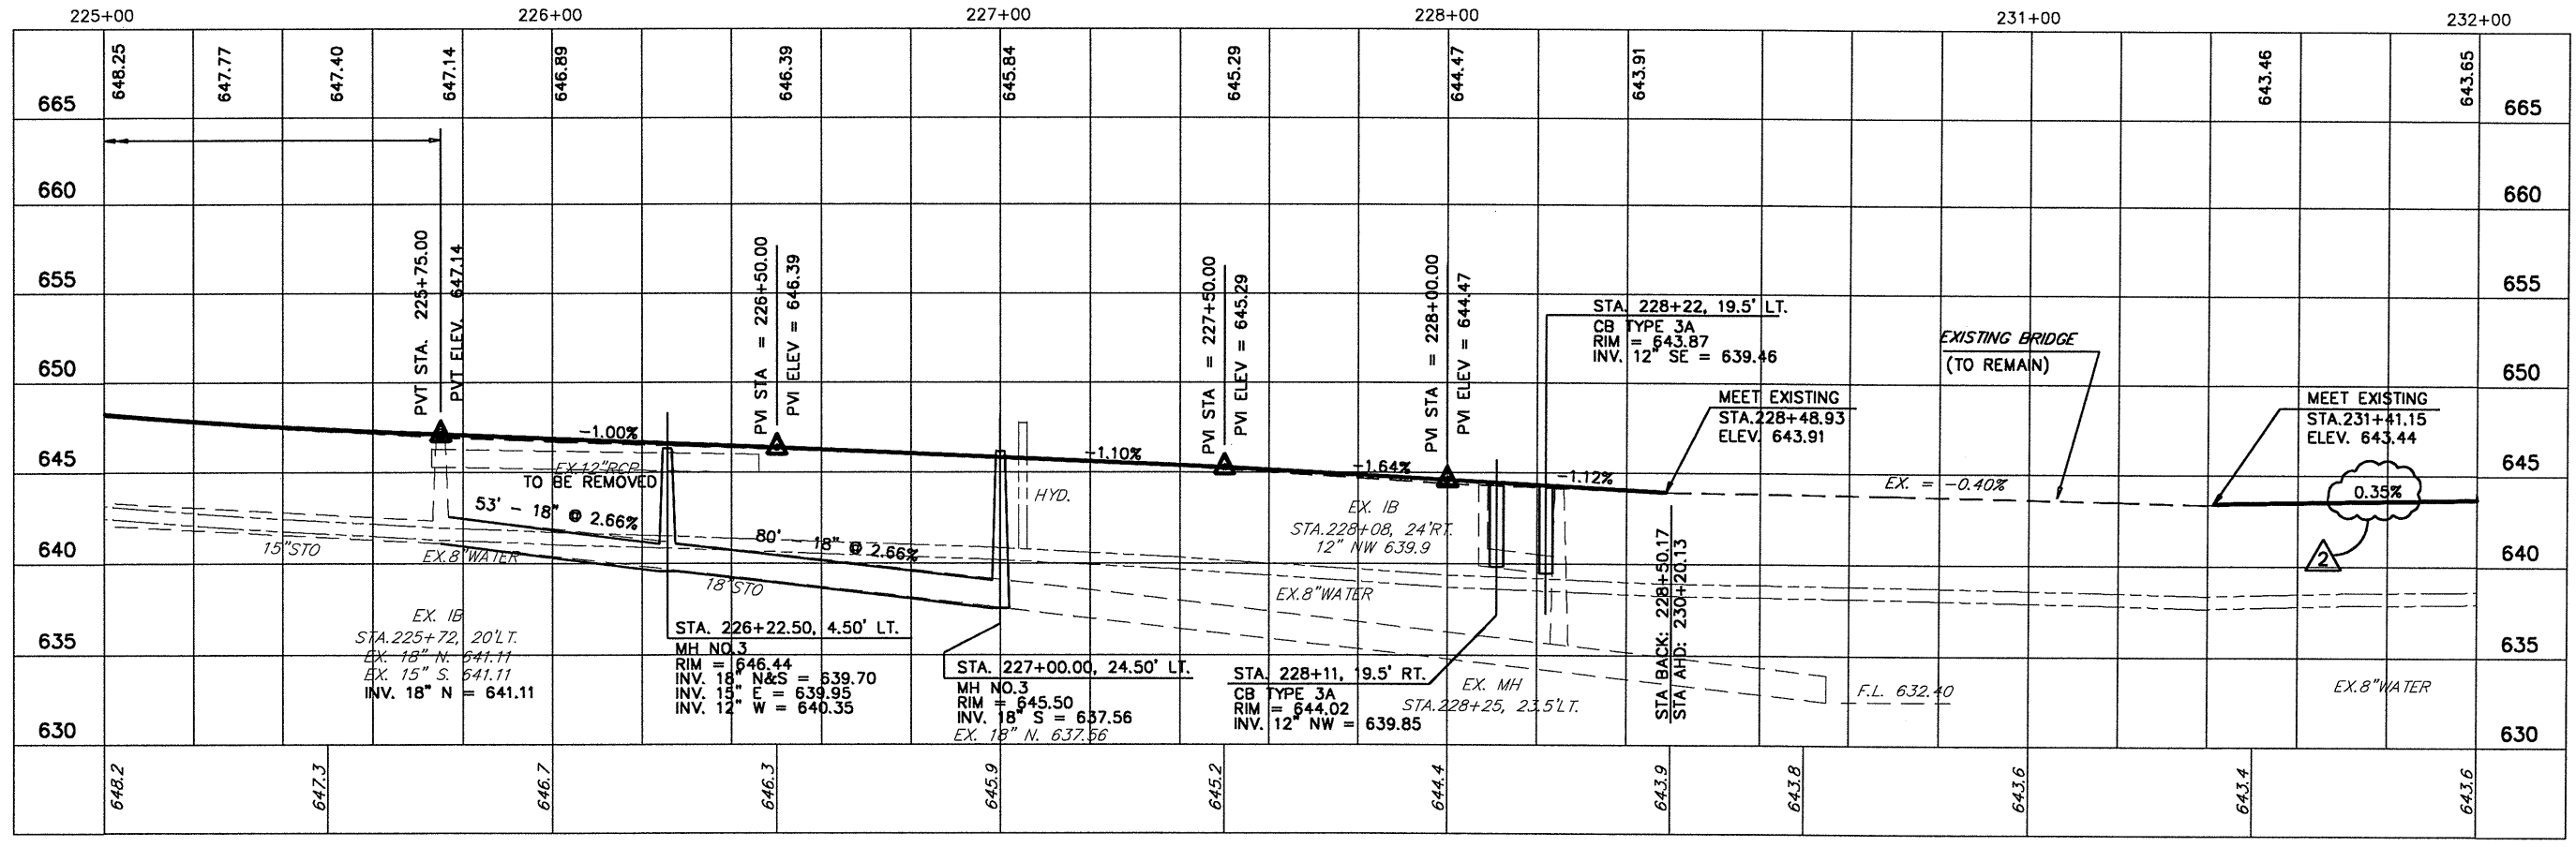


No.	REVISIONS	By	Date
1	Lane Widths	RLB	2/28/00
2	Grade Change	RLB	2/28/00
3	Lane Widths	RLB	4/12/00

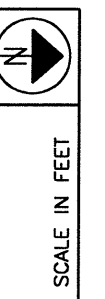

PLAN AND PROFILE - S.R. 306
STA. 225+00 TO STA. 232+00

LAK - 615 - 0.00