
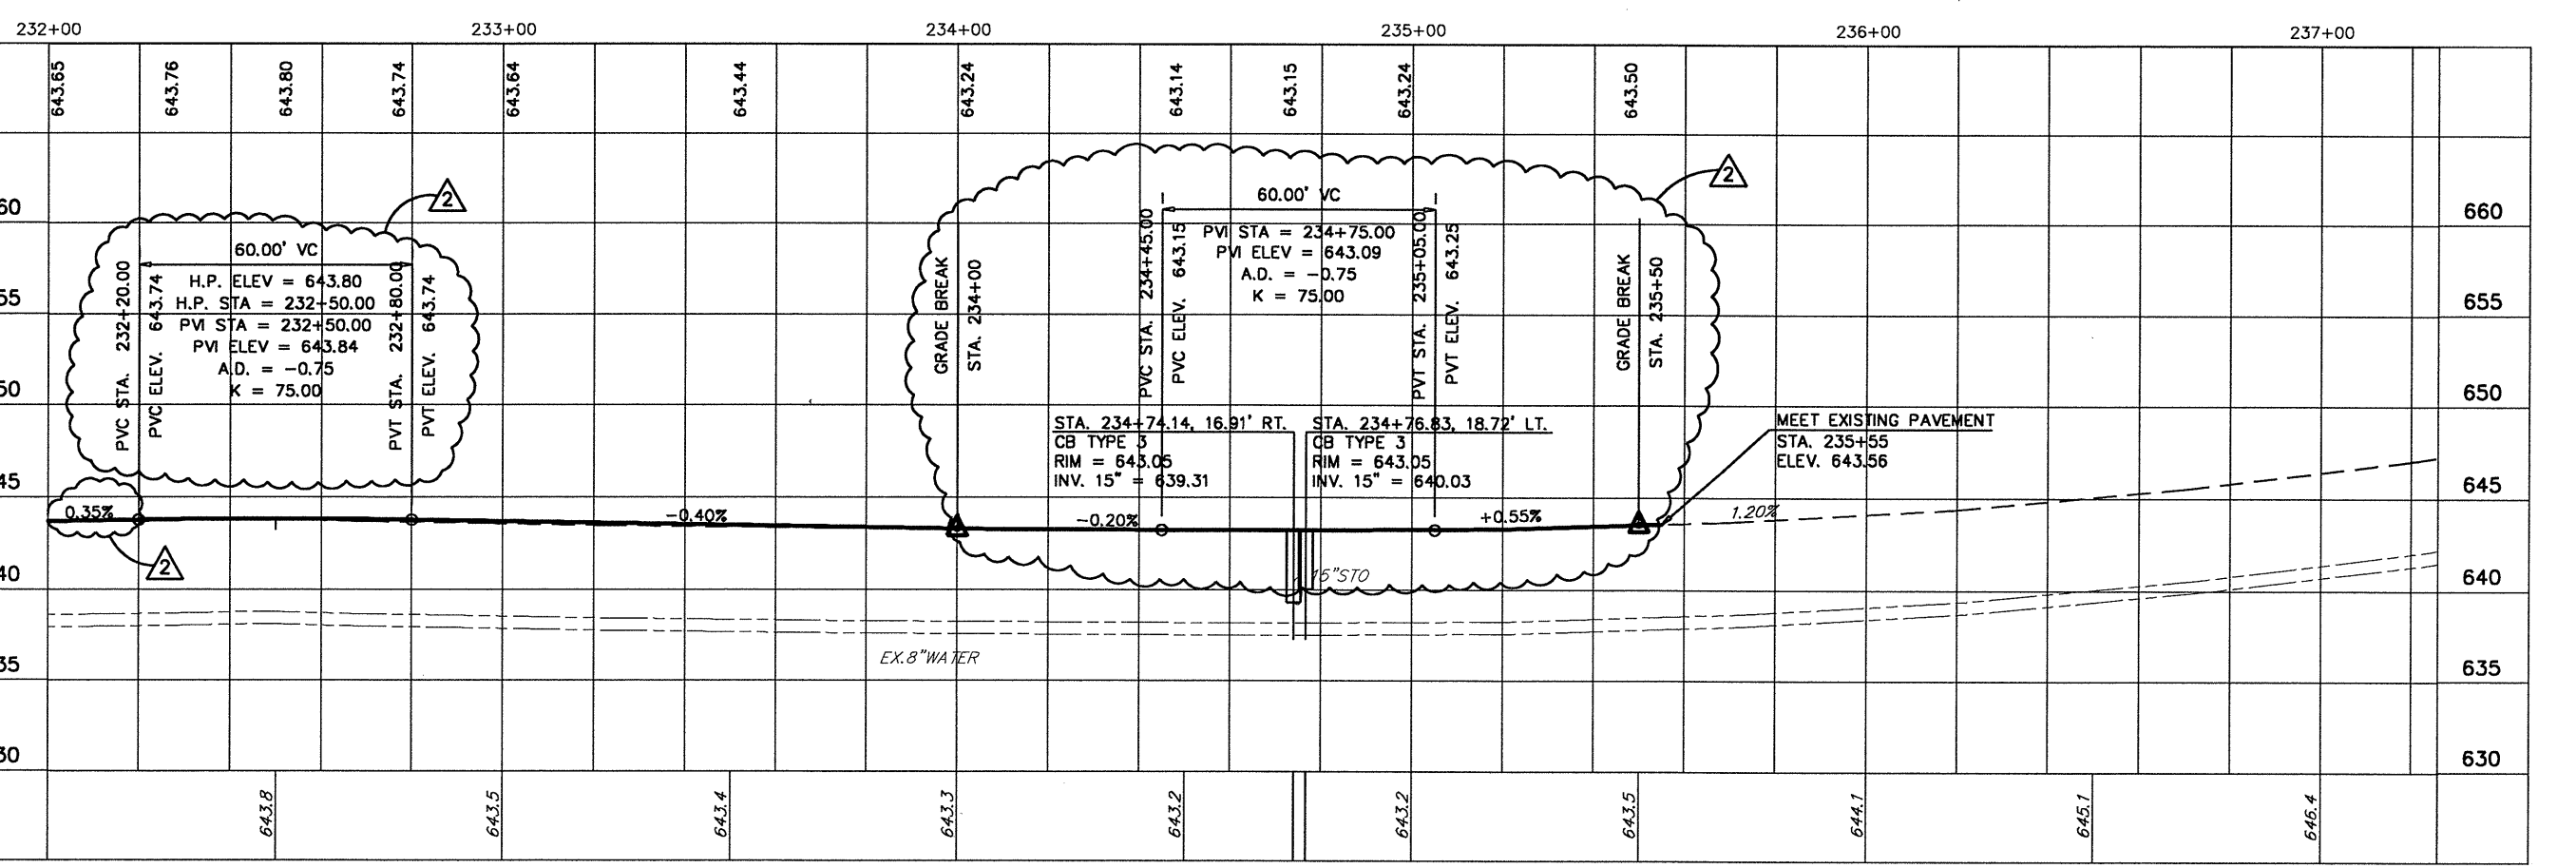


H:\CT\97260\SDSK\306pp.dwg 10/01/99 07:39:45 AM EDT

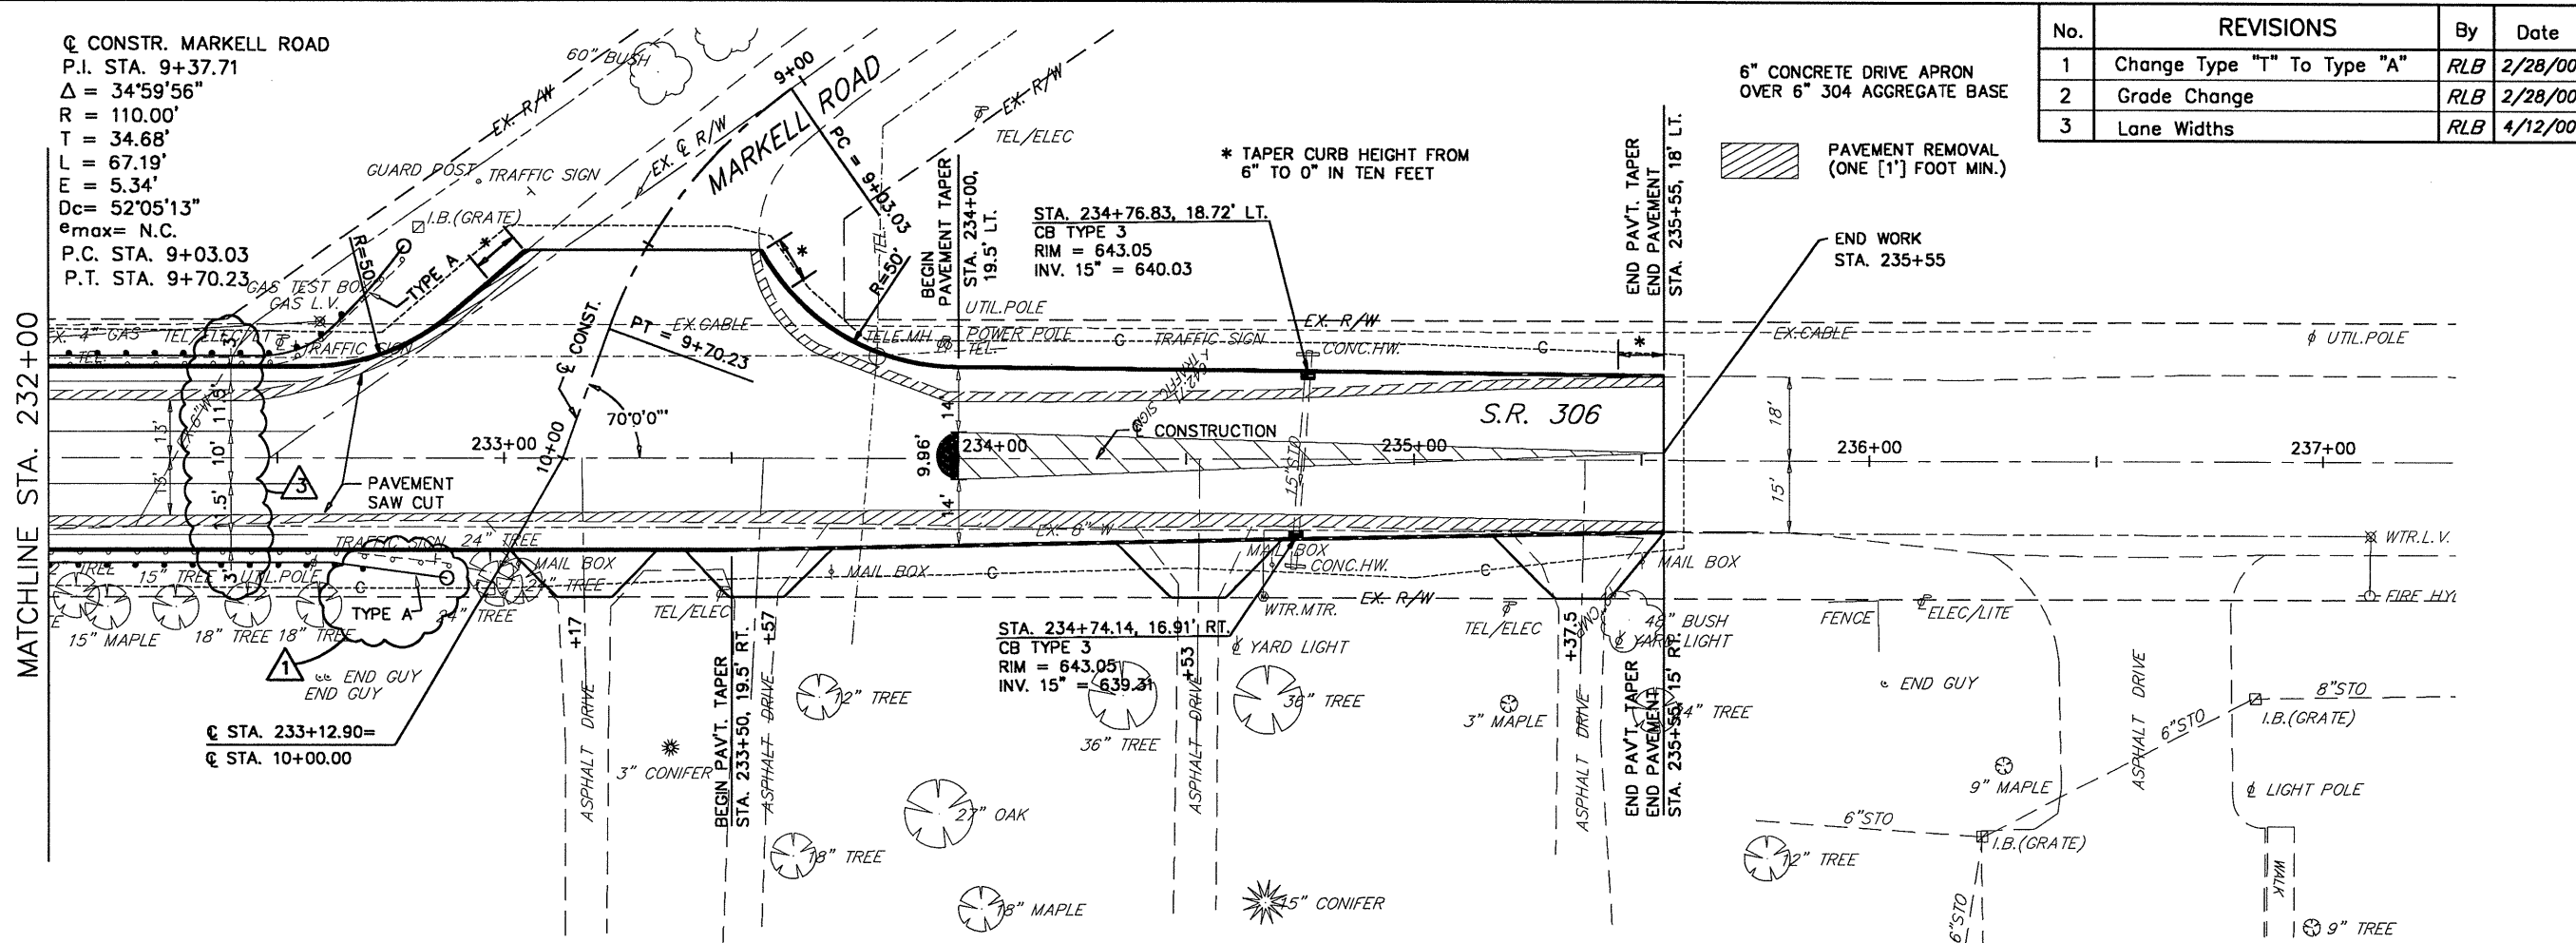

No.	REVISIONS	By	Date
1	Change Type "T" To Type "A"	RLB	2/28/00
2	Grade Change	RLB	2/28/00
3	Lane Widths	RLB	4/12/00

SCALE IN FEET

PLAN AND PROFILE - S.R. 306
STA. 232+00 TO STA. 237+00

LAK - 615 - 0.00

31
95