

| No. | REVISIONS | By | Date |
|-----|-------------|-----|---------|
| 1 | Lane Widths | RLB | 4/12/00 |




SCALE IN FEET

CALCULATED
CHECKED

INTERSECTION DETAIL
S.R. 306 / EISENHOWER DRIVE / RELOCATED S.R. 615

LAK - 615 - 0.00

51
95

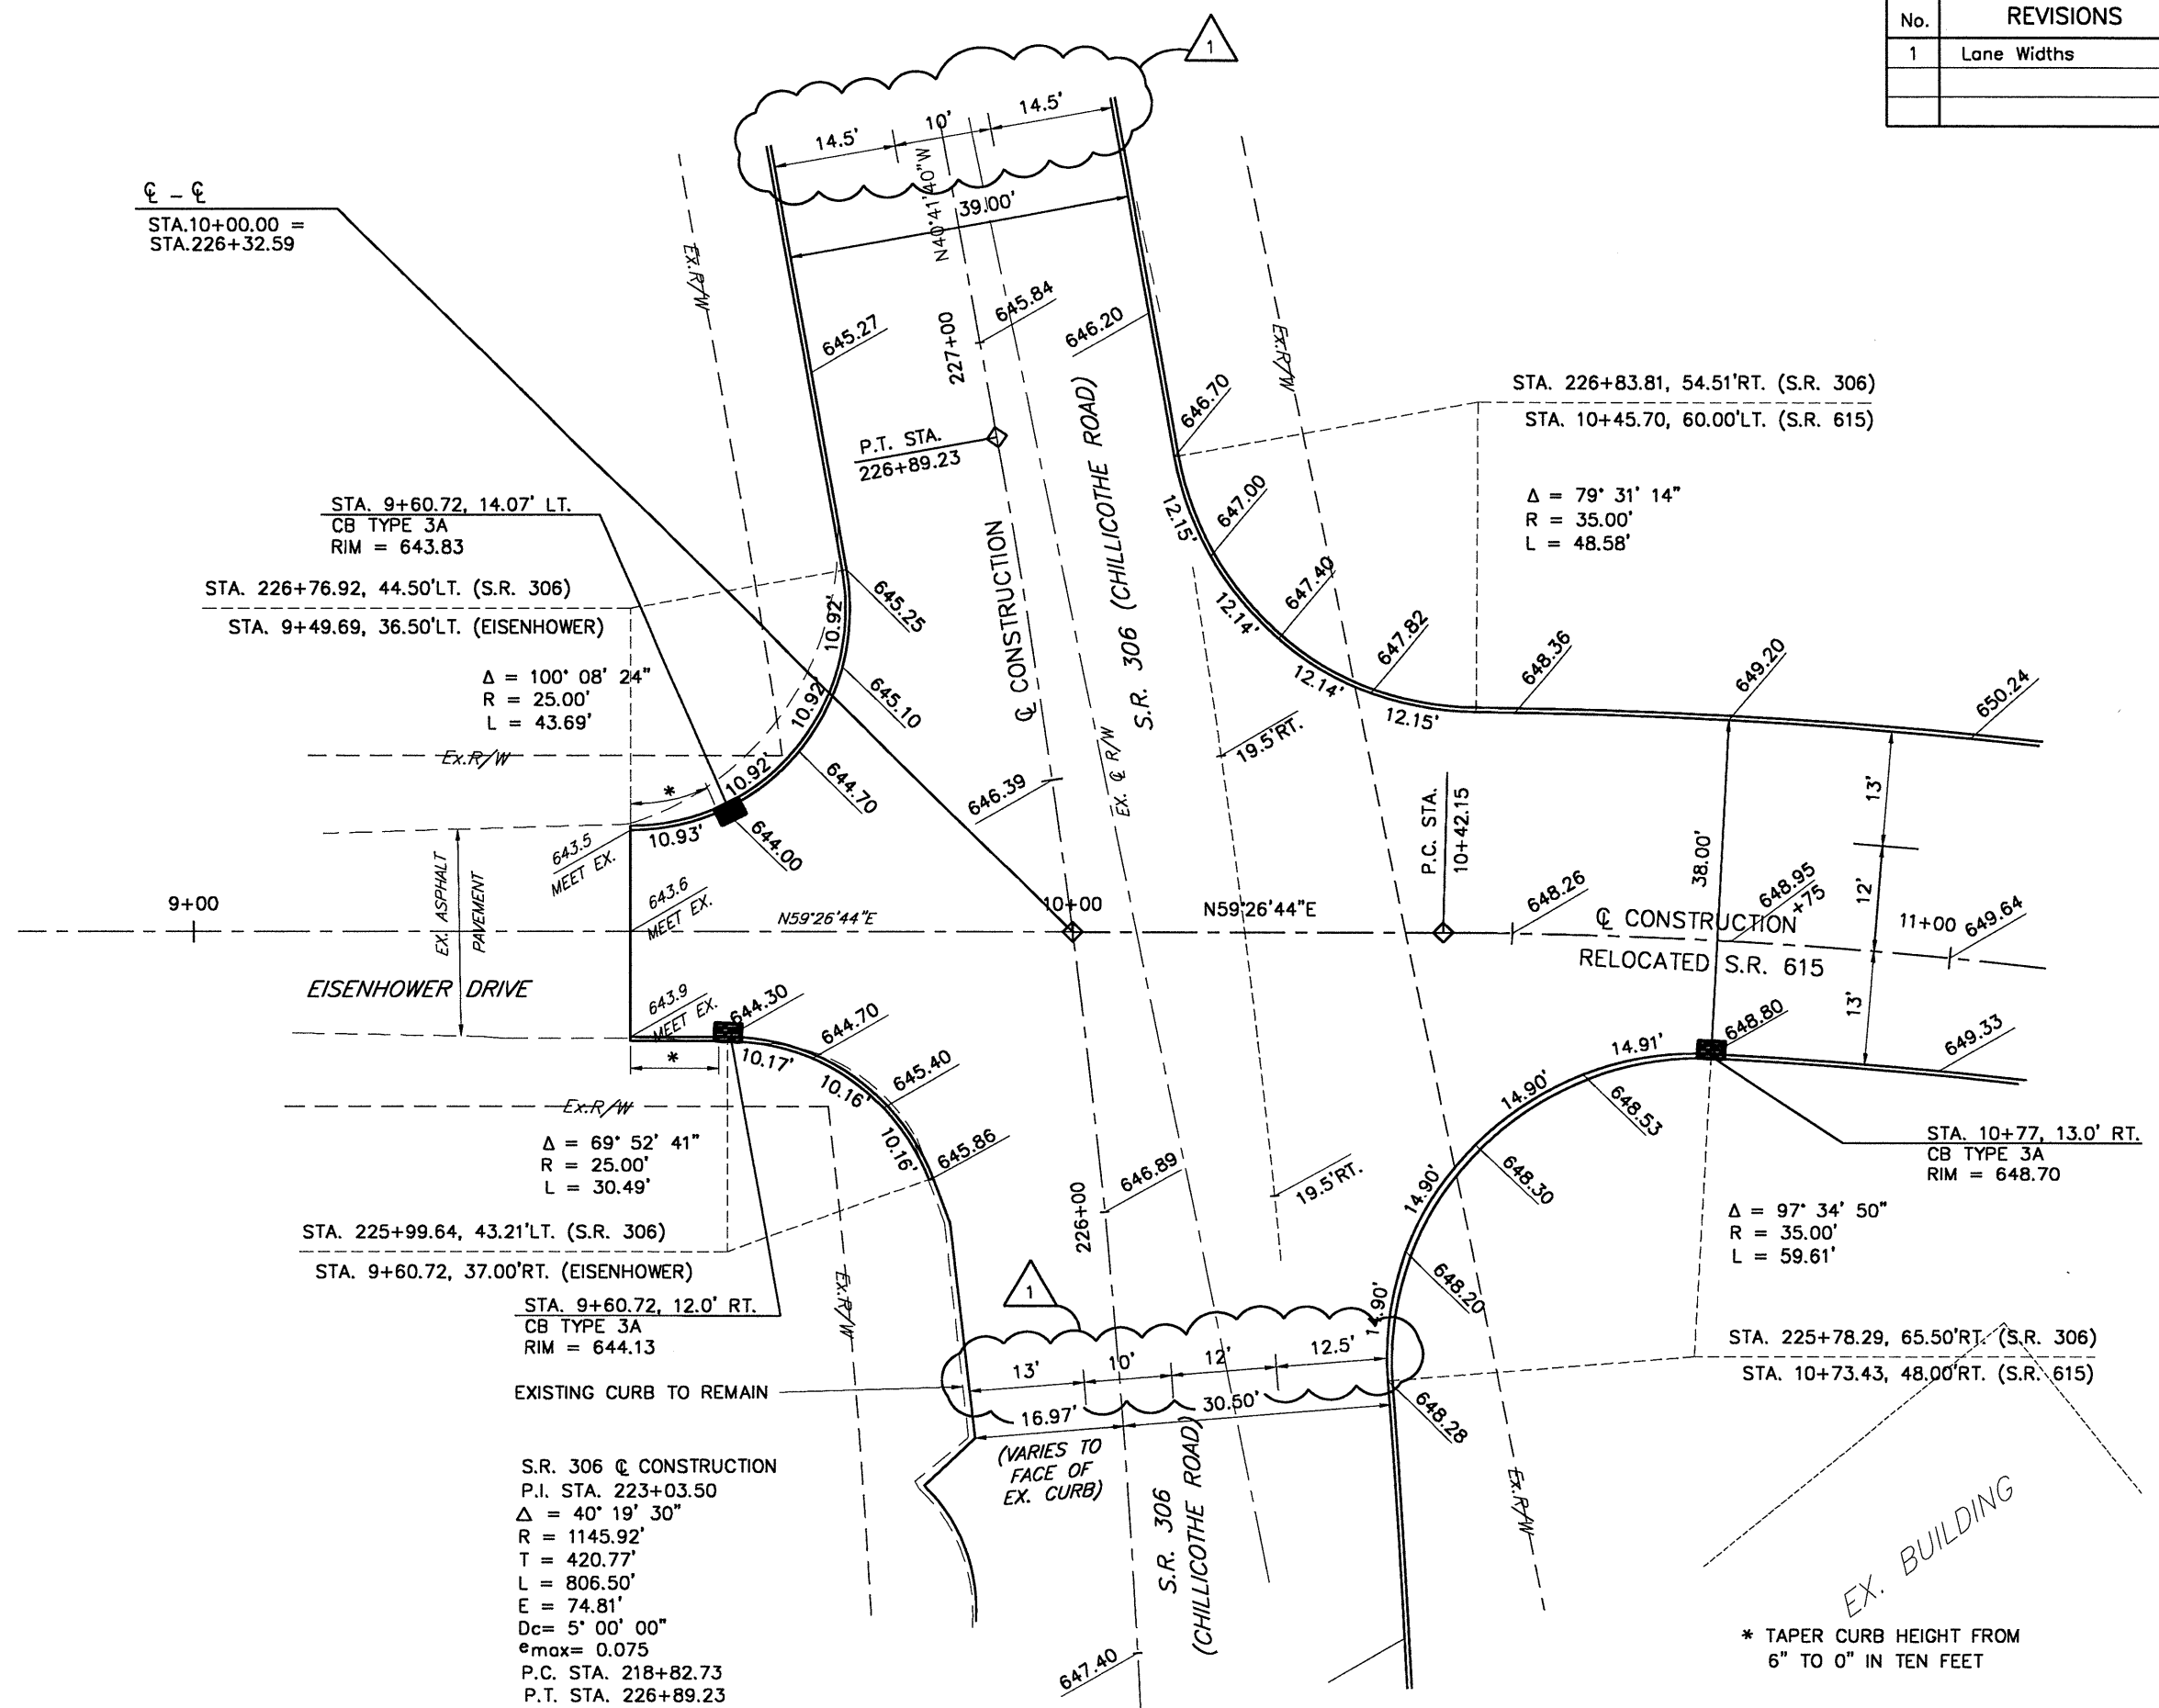

* TAPER CURB HEIGHT FROM 6" TO 0" IN TEN FEET

ELEVATIONS SHOWN DENOTE PAVEMENT ELEVATIONS OR GUTTER ELEVATIONS AT FACE OF CURB

H:/CT/97260/INTDETS.DWG