
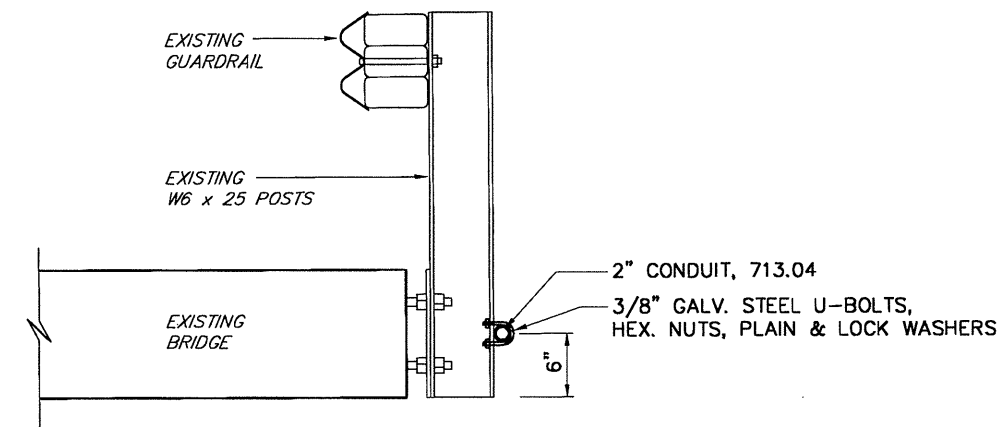


DATE: 1-04-00 - H:\ct\97260\TRAFFIC\97260T01.dwg

LOOP	SIZE	TURNS	MODE	DELAY	PHASE	REMARK	DELAY INHIBITED	LOCATION 1st FRONT CORNER	LOCATION 2nd FRONT CORNER
L-7	6X6	3	PRESENCE	2.0		STANDARD		231+62, 8.3'LT.	231+62, 14.3'LT.

SCALE IN FEET

LOOP DETECTOR CHART

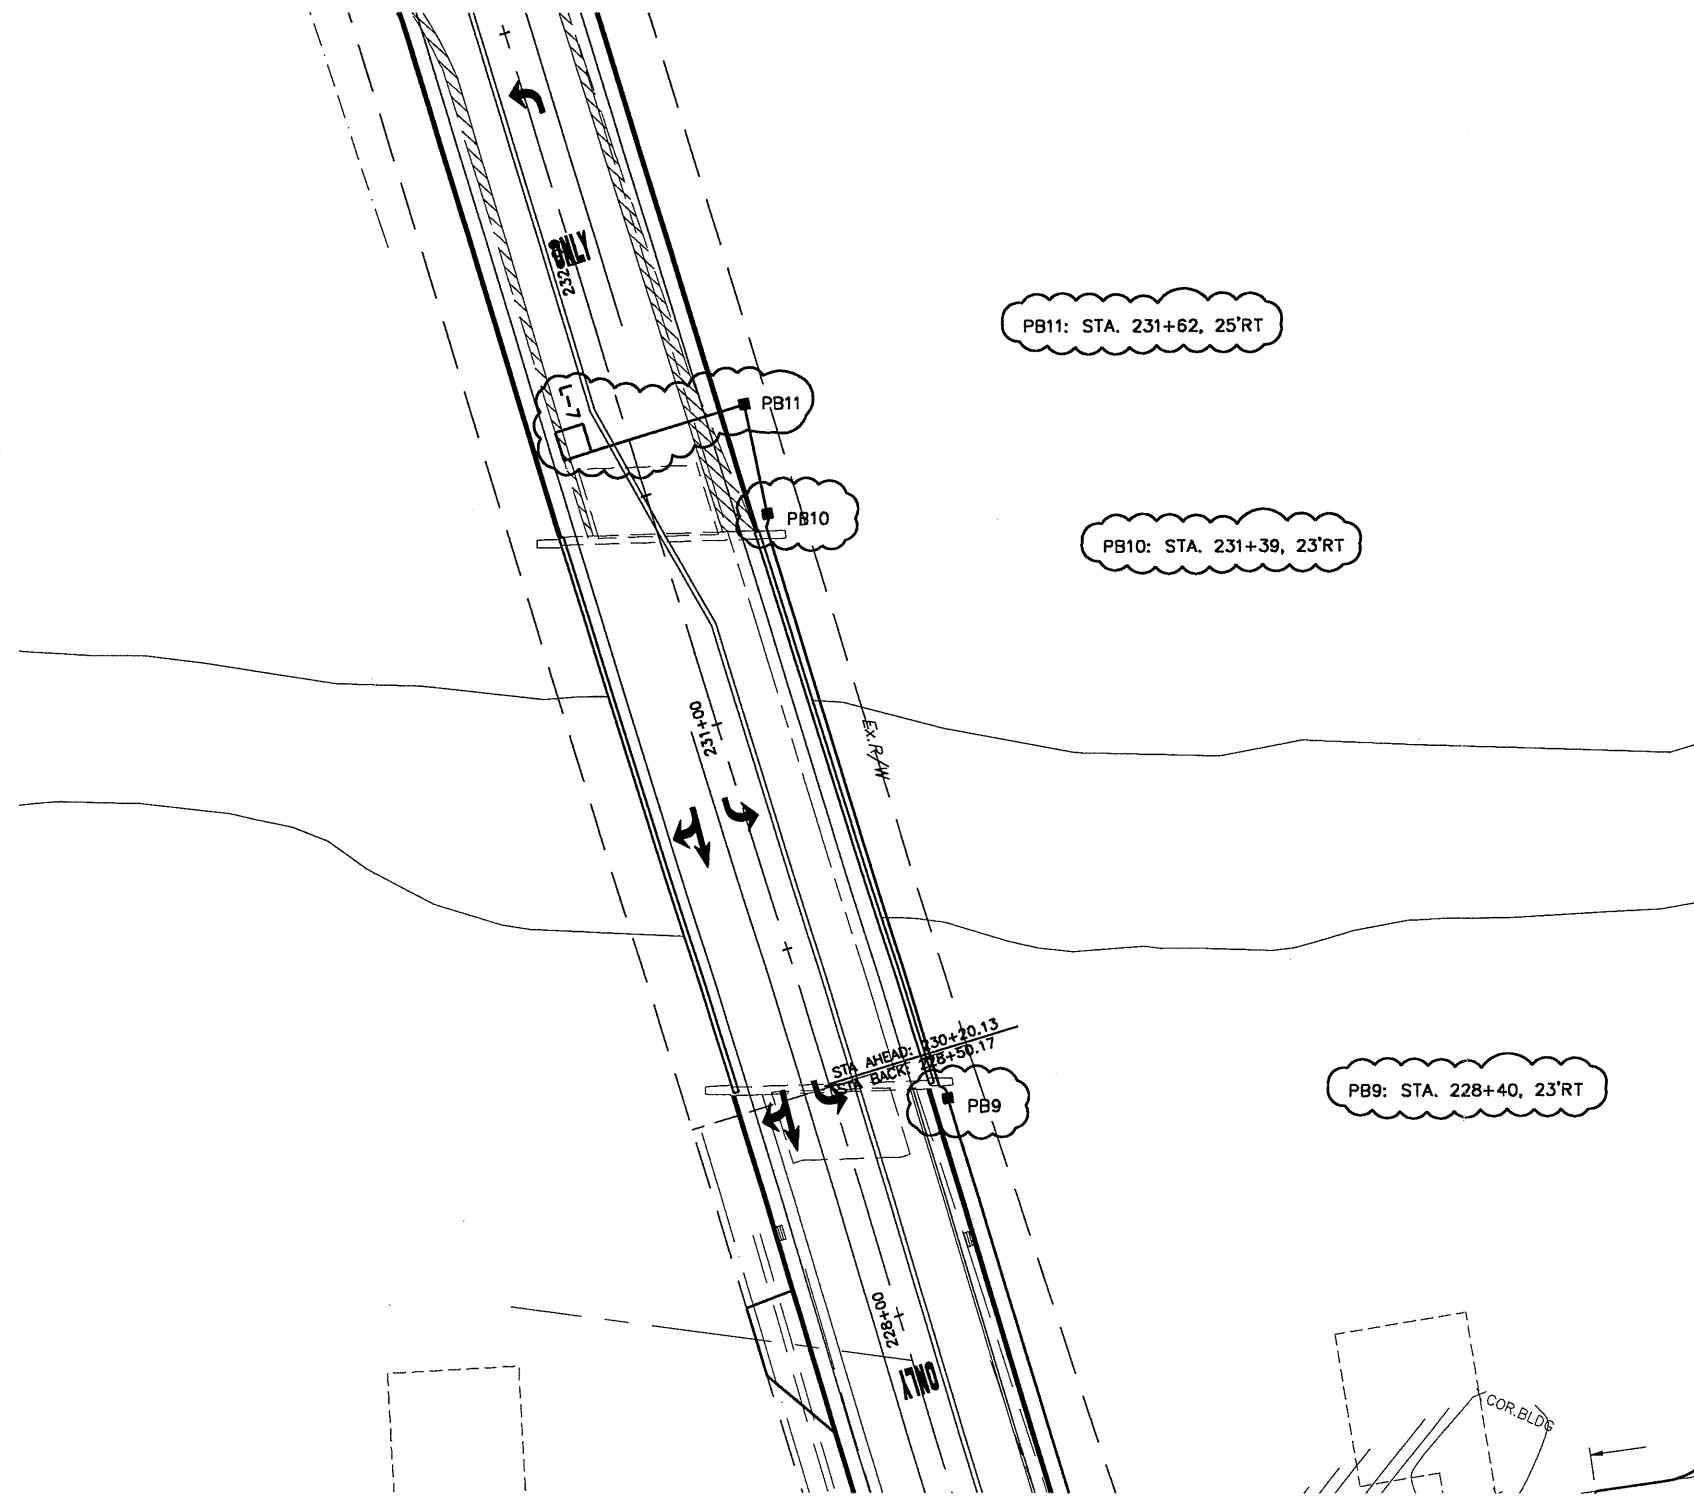

CONDUIT ATTACHMENT ON S.R. 306 STRUCTURE

NOTE: CONNECT CONDUIT TO EXISTING GUARDRAIL POSTS AT 12'-6" SPACING.  
 ALL HARDWARE, CONNECTIONS AND LABOR COSTS TO BE INCLUDED WITH ITEM 625, CONDUIT 2", 713.04

5/3/00  
**PLAN MODIFICATIONS:**  
 1) REVISE L-7 LOOP DETECTOR LOCATION.

TRAFFIC SIGNAL PLAN  
 S.R. 306 / S.R. 615 INTERSECTION

LAK - 615 - 0.00

No.	REVISIONS	By	Date
1	Sheet Added To Plan	RLB	5/3/00

T3A  
T16