


PAVEMENT MARKING LEGEND

- ① ITEM 642 - CENTER LINE, YELLOW, DOUBLE, SOLID
- ② ITEM 642 - EDGE LINE, WHITE
- ③ ITEM 642 - CHANNELIZING LINE
- ④ ITEM 642 - STOP LINE
- ⑤ ITEM 642 - TRANSVERSE LINE
- ⑥ ITEM 642 - LANE ARROW
- ⑦ ITEM 642 - WORD ON PAVEMENT
- ⑧ ITEM 642 - ISLAND MARKING

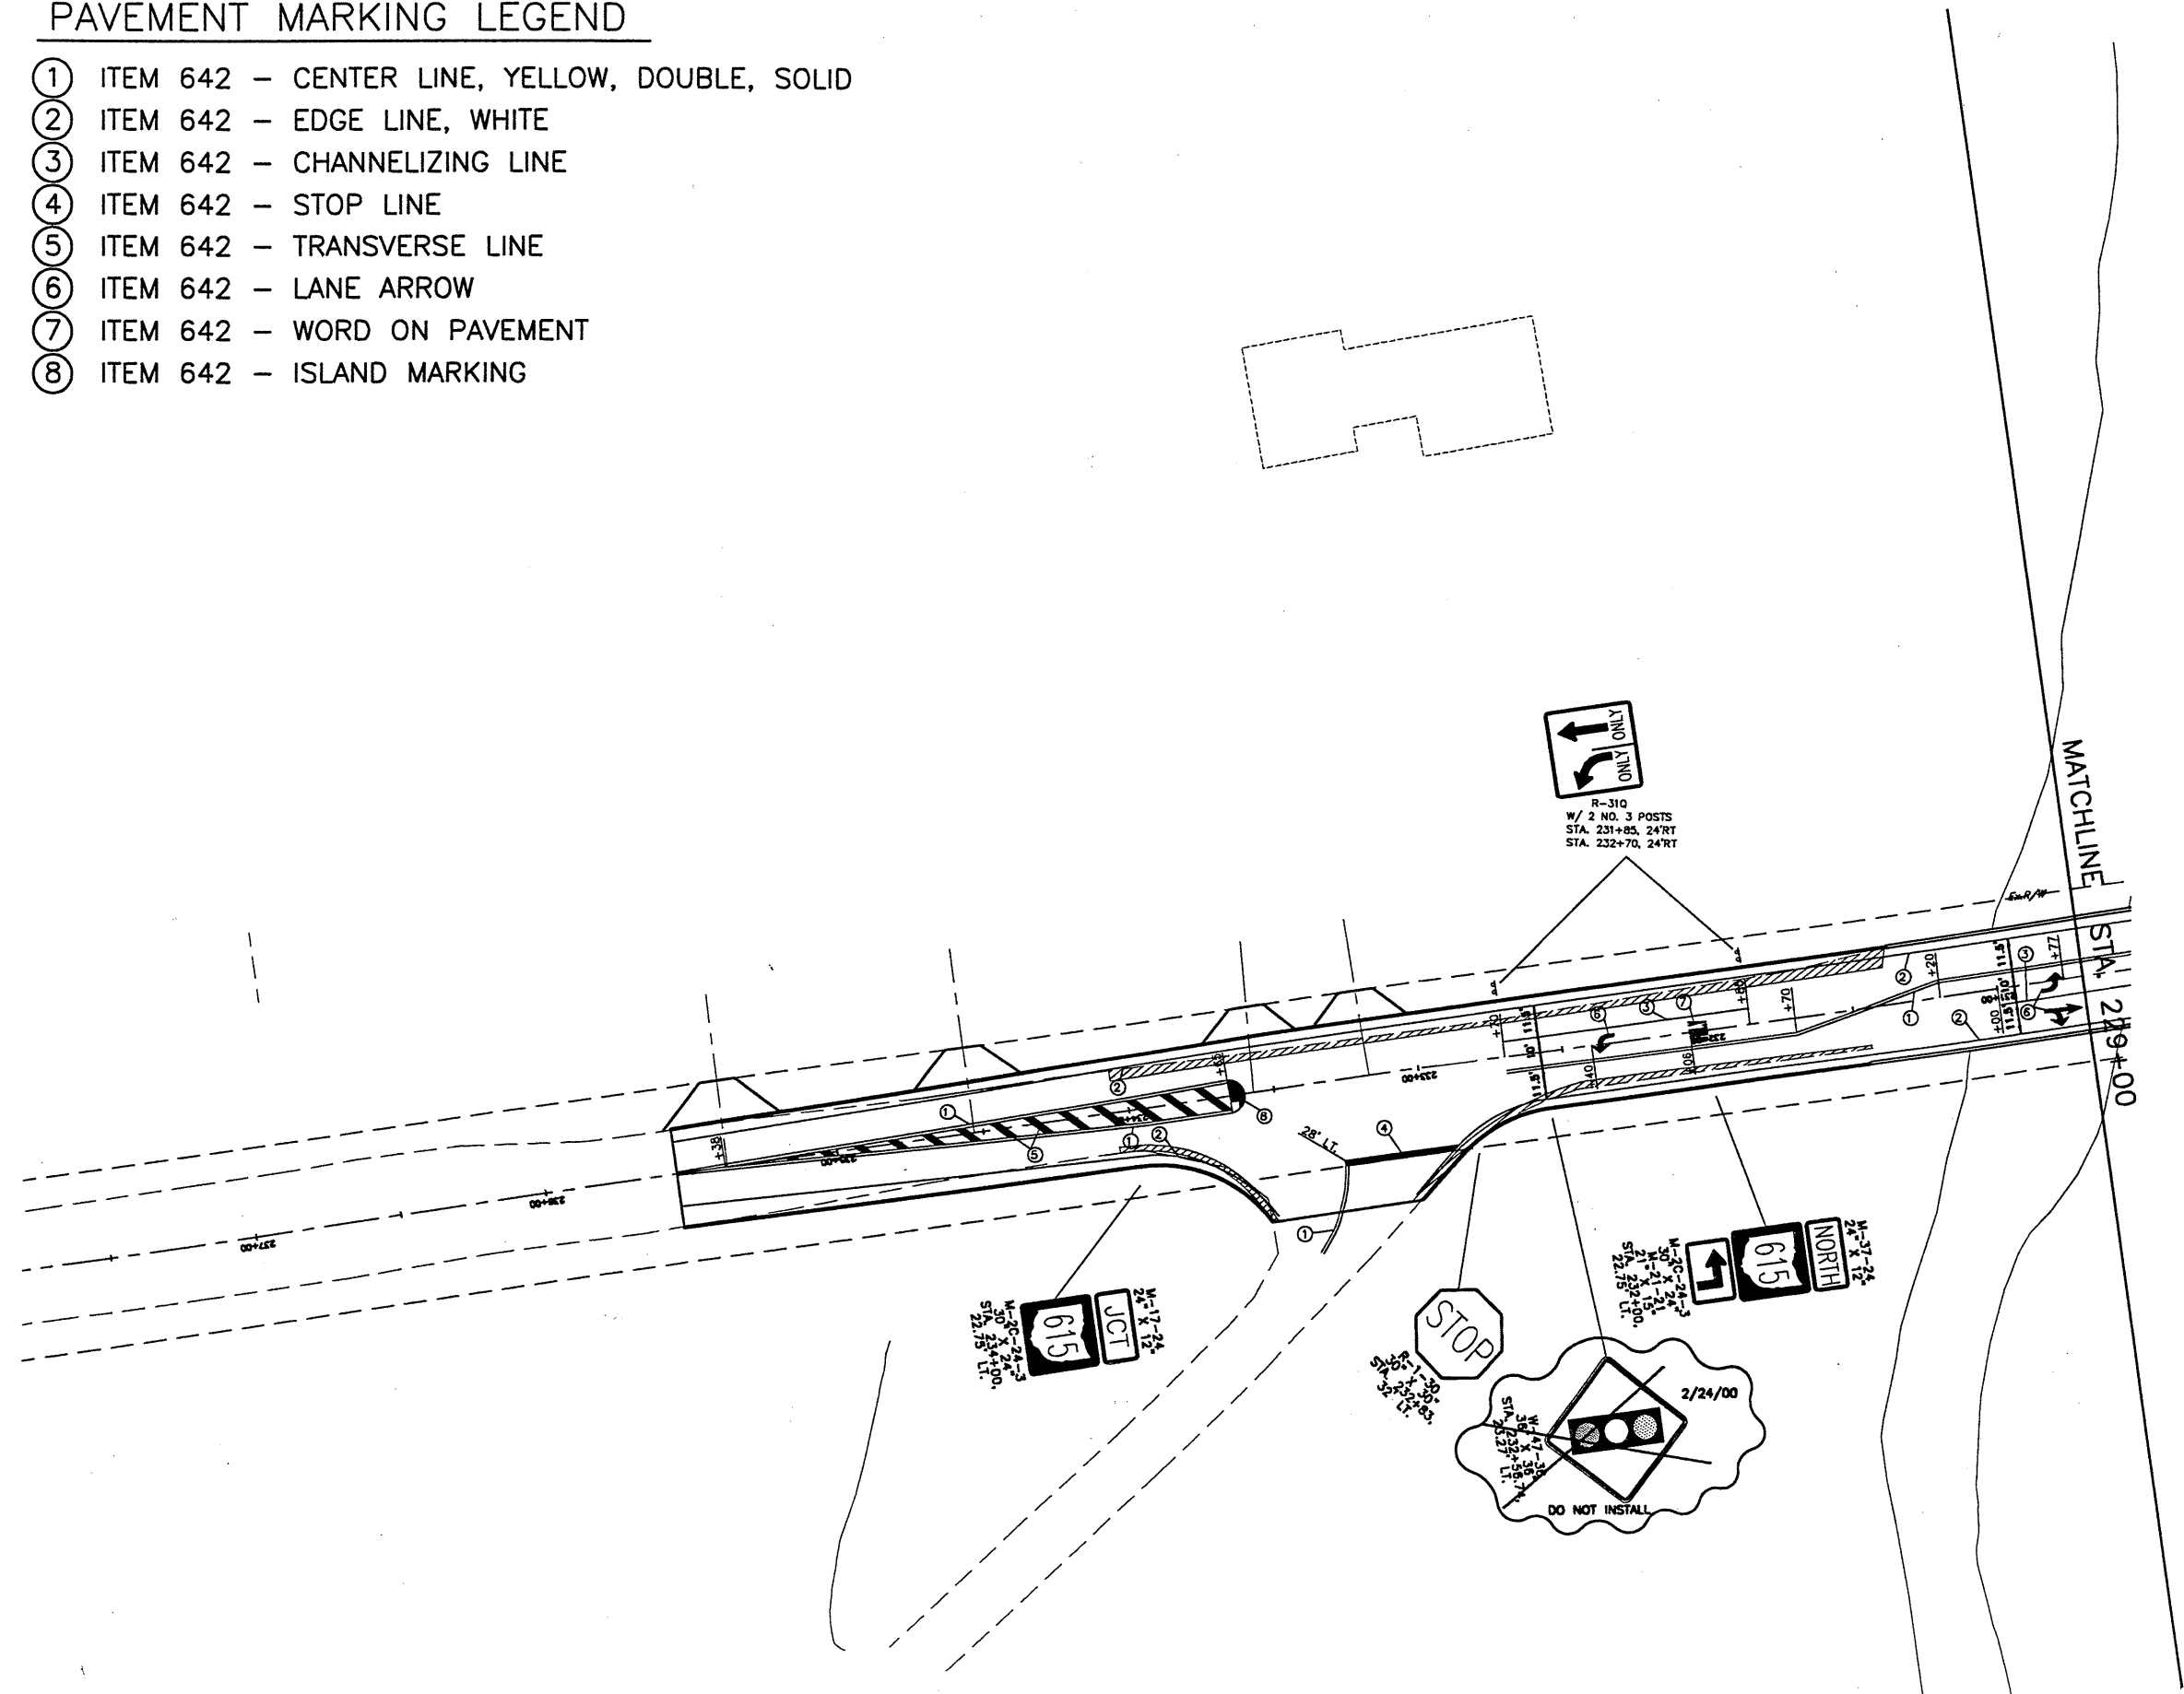

DATE: 1-04-00 - TIME: 21:56 - H:\ct\97260\sdk\97260T05.dwg

CALCULATED
 A.E.P.
 CHECKED
 I.M.H.

PAVEMENT MARKING PLAN
 S.R. 306

LAK - 615 - 0.00