


DATE: 1-04-00 - TIME: 21:56 - H:\ct\97260\sdsk\97260T05.dwg

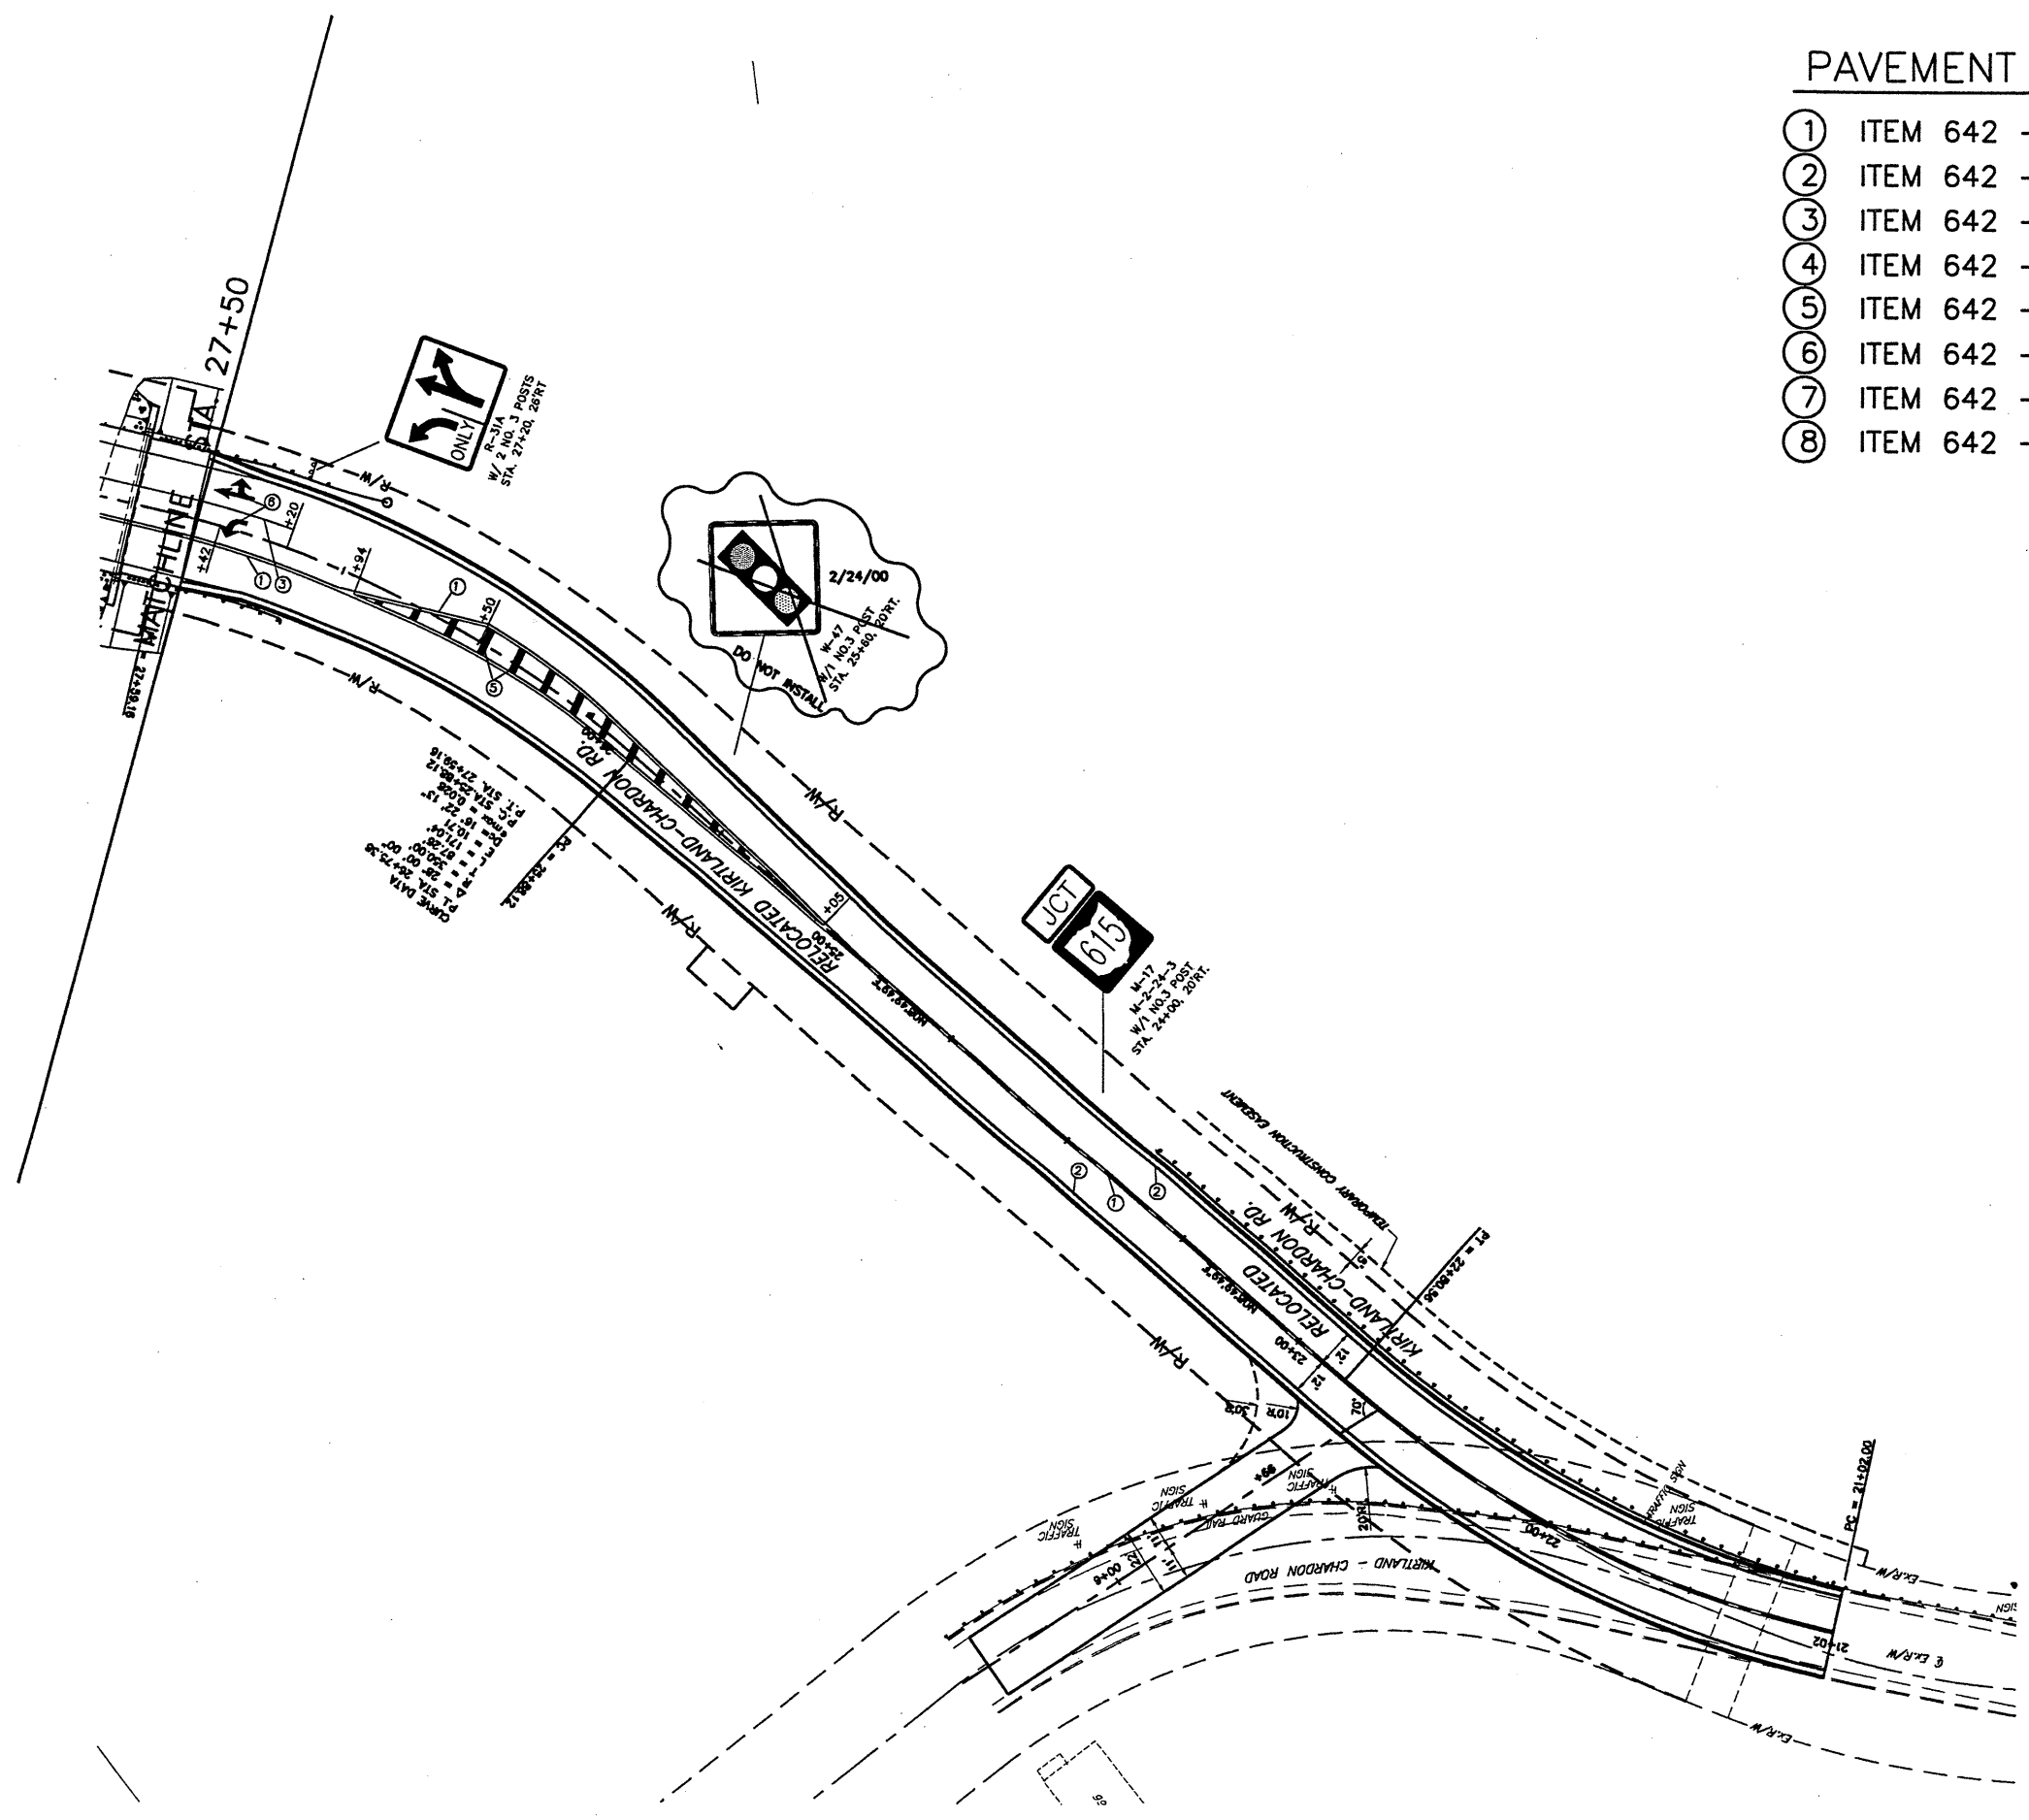

PAVEMENT MARKING LEGEND

- ① ITEM 642 - CENTER LINE, YELLOW, DOUBLE, SOLID
- ② ITEM 642 - EDGE LINE, WHITE
- ③ ITEM 642 - CHANNELIZING LINE
- ④ ITEM 642 - STOP LINE
- ⑤ ITEM 642 - TRANSVERSE LINE
- ⑥ ITEM 642 - LANE ARROW
- ⑦ ITEM 642 - WORD ON PAVEMENT
- ⑧ ITEM 642 - ISLAND MARKING

	 SCALE IN FEET
CALCULATED A.L.P.	CHECKED I.M.H.
PAVEMENT MARKING PLAN GARFIELD / CHILLICOthe / S.R. 615 INTERSECTION	
LAK - 615 - 0.00	