


NOTES:
 • EXISTING 20" WATER MAIN SHOWN FROM RECORDS. CONTRACTOR TO CONTACT UTILITY COMPANY FOR ACTUAL FIELD LOCATIONS.
 • PROPOSED MANHOLE RIM ELEVATIONS SHALL BE ADJUSTED TO MEET FIELD CONDITIONS.

CHANGE ORDER
 PROJ 184-01 1/8
 9-5-2001

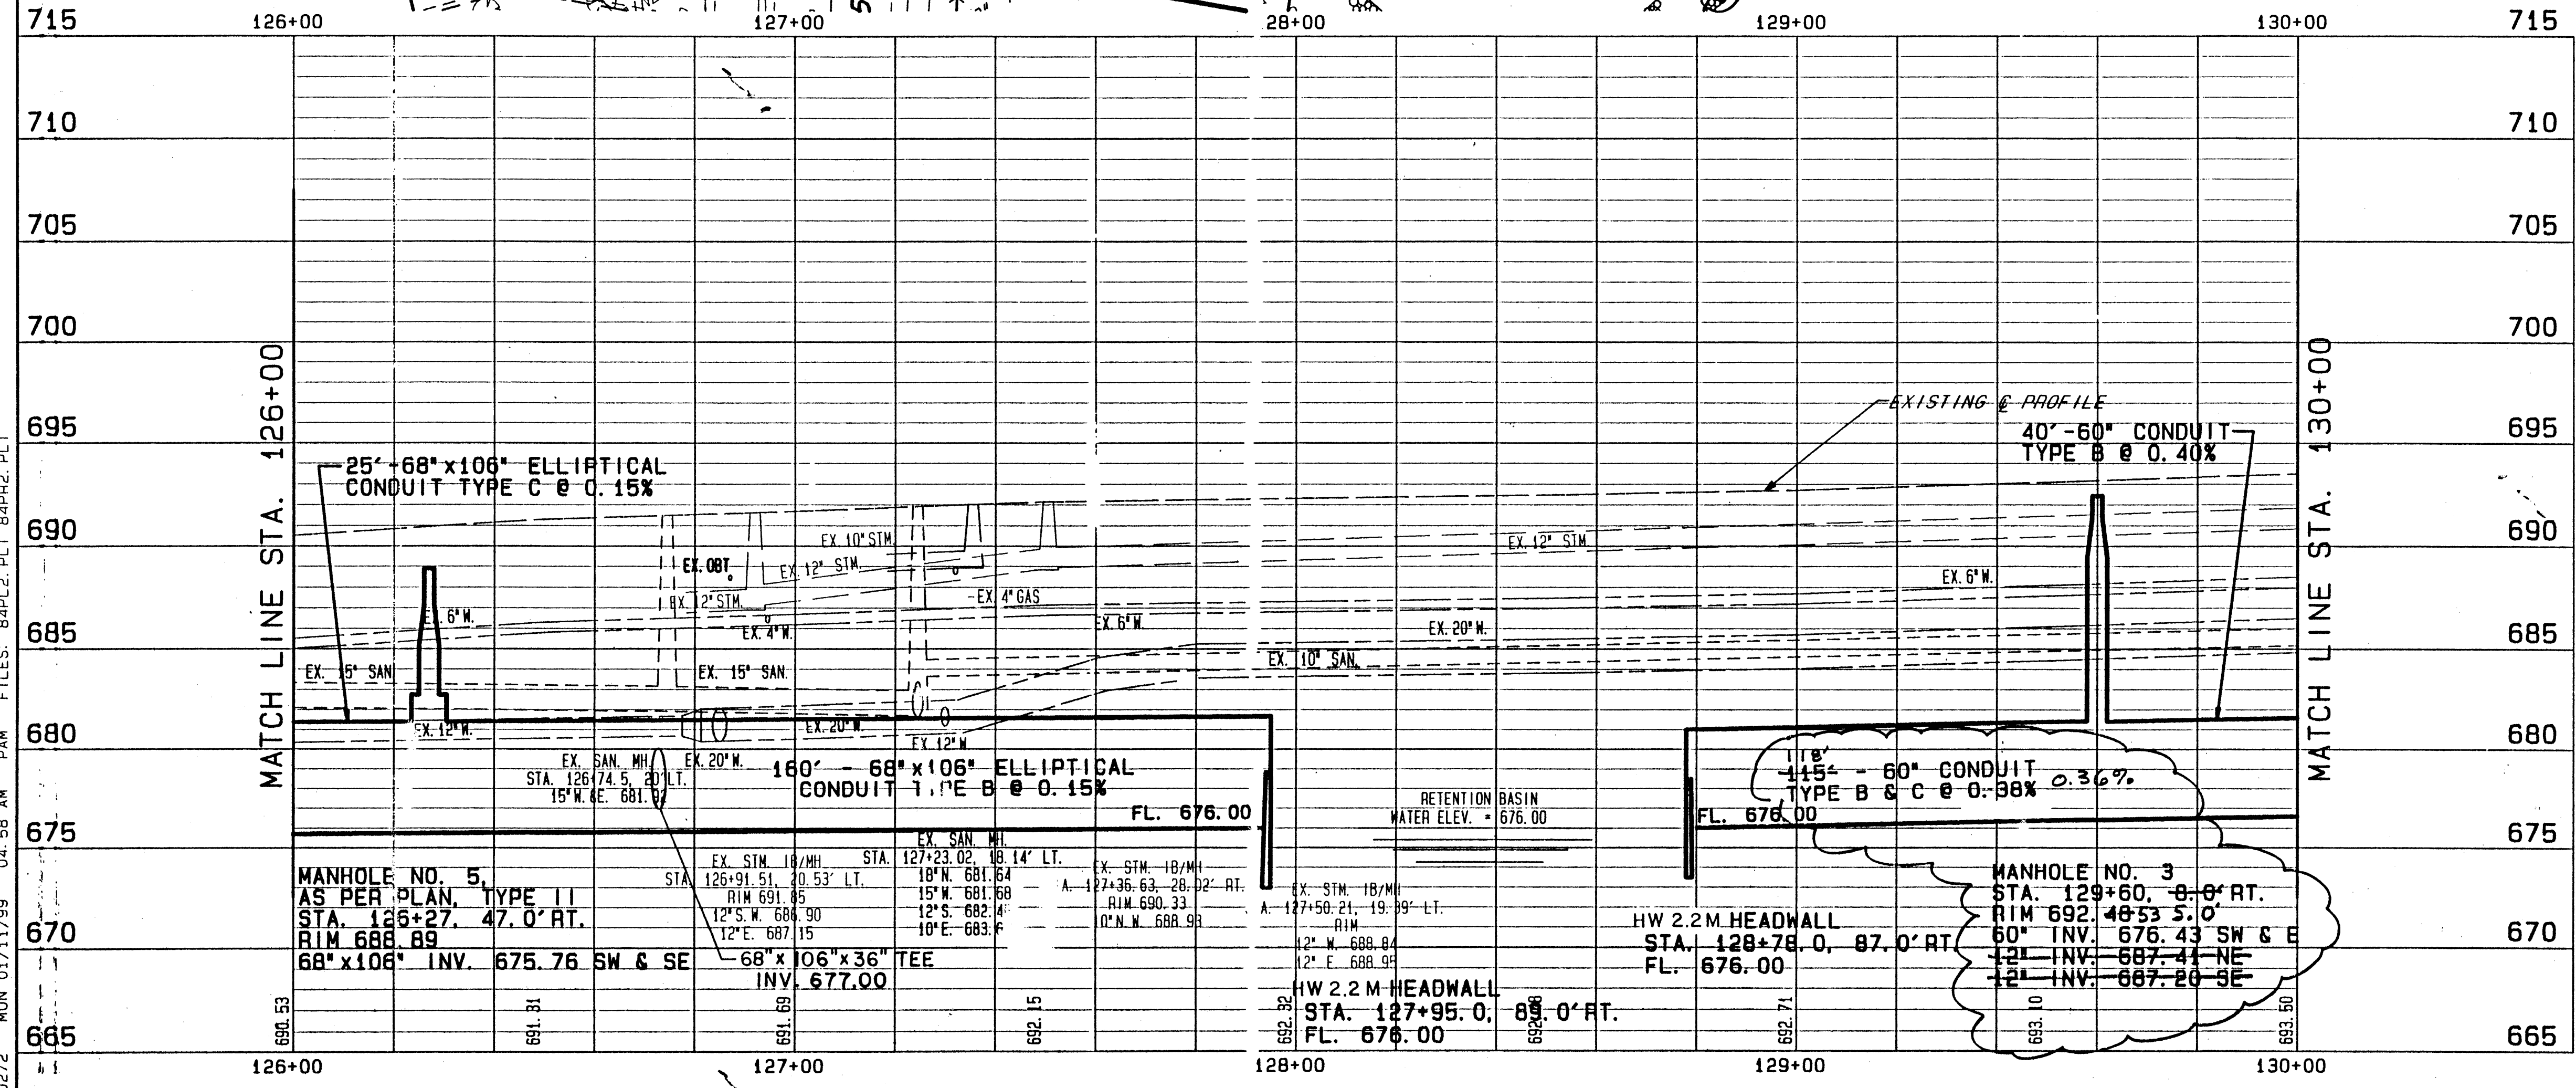

QUANTITIES HAVE BEEN CARRIED TO SUB-SUMMARY SHEETS 42-45.

NO.	DESCRIPTION	UNIT	QTY	UNIT PRICE	TOTAL
602	CONCRETE	C.Y.	2.69		4.62
604	MANHOLE NO. 5 AS PER PLAN, TYPE II	EACH	1		1
604	MANHOLE NO. 3	EACH	1		1
603	36" CONDUIT, TYPE B, AS PER PLAN 108.2	L.F.	16		16
603	68" X 106" CONDUIT, TYPE B 706.04 W/ JOINTS AS PER 706.10	L.F.	160		160
603	68" X 106" CONDUIT, TYPE C 706.04 W/ JOINTS AS PER 706.10	L.F.	25		25
603	60" CONDUIT, TYPE B AS PER PLAN (A) 706.02, 1500 D-LOAD	L.F.	40		40
				TOTALS	158

PRINTED
 AUG 22 2001
 CT CONSULTANTS, INC.