

TOWNSHIP 10, RANGE 9
CONNECTICUT WESTERN RESERVE
CITY OF MENTOR



FED. RD. DIVISION	STATE	PROJECT
2	OHIO	US-1530 (I)

178
181
25
28

LAKE COUNTY
LAK-615-3.26

TOTAL AREA (NON-OPERATING PROPERTY #1) = 25,742 Sq. Ft.
P.R.O. = 9376 Sq. Ft.
PARCEL 107A = 317 Sq. Ft.
RESIDUE = 16049 Sq. Ft.
107 AER-OVERLAP OF RESIDUE = 4896 Sq. Ft.
107 U-OVERLAP OF RESIDUE = 153 Sq. Ft.
107 T-2-OVERLAP OF RESIDUE = 1277 Sq. Ft.

NON-OPERATING PROPERTY #1

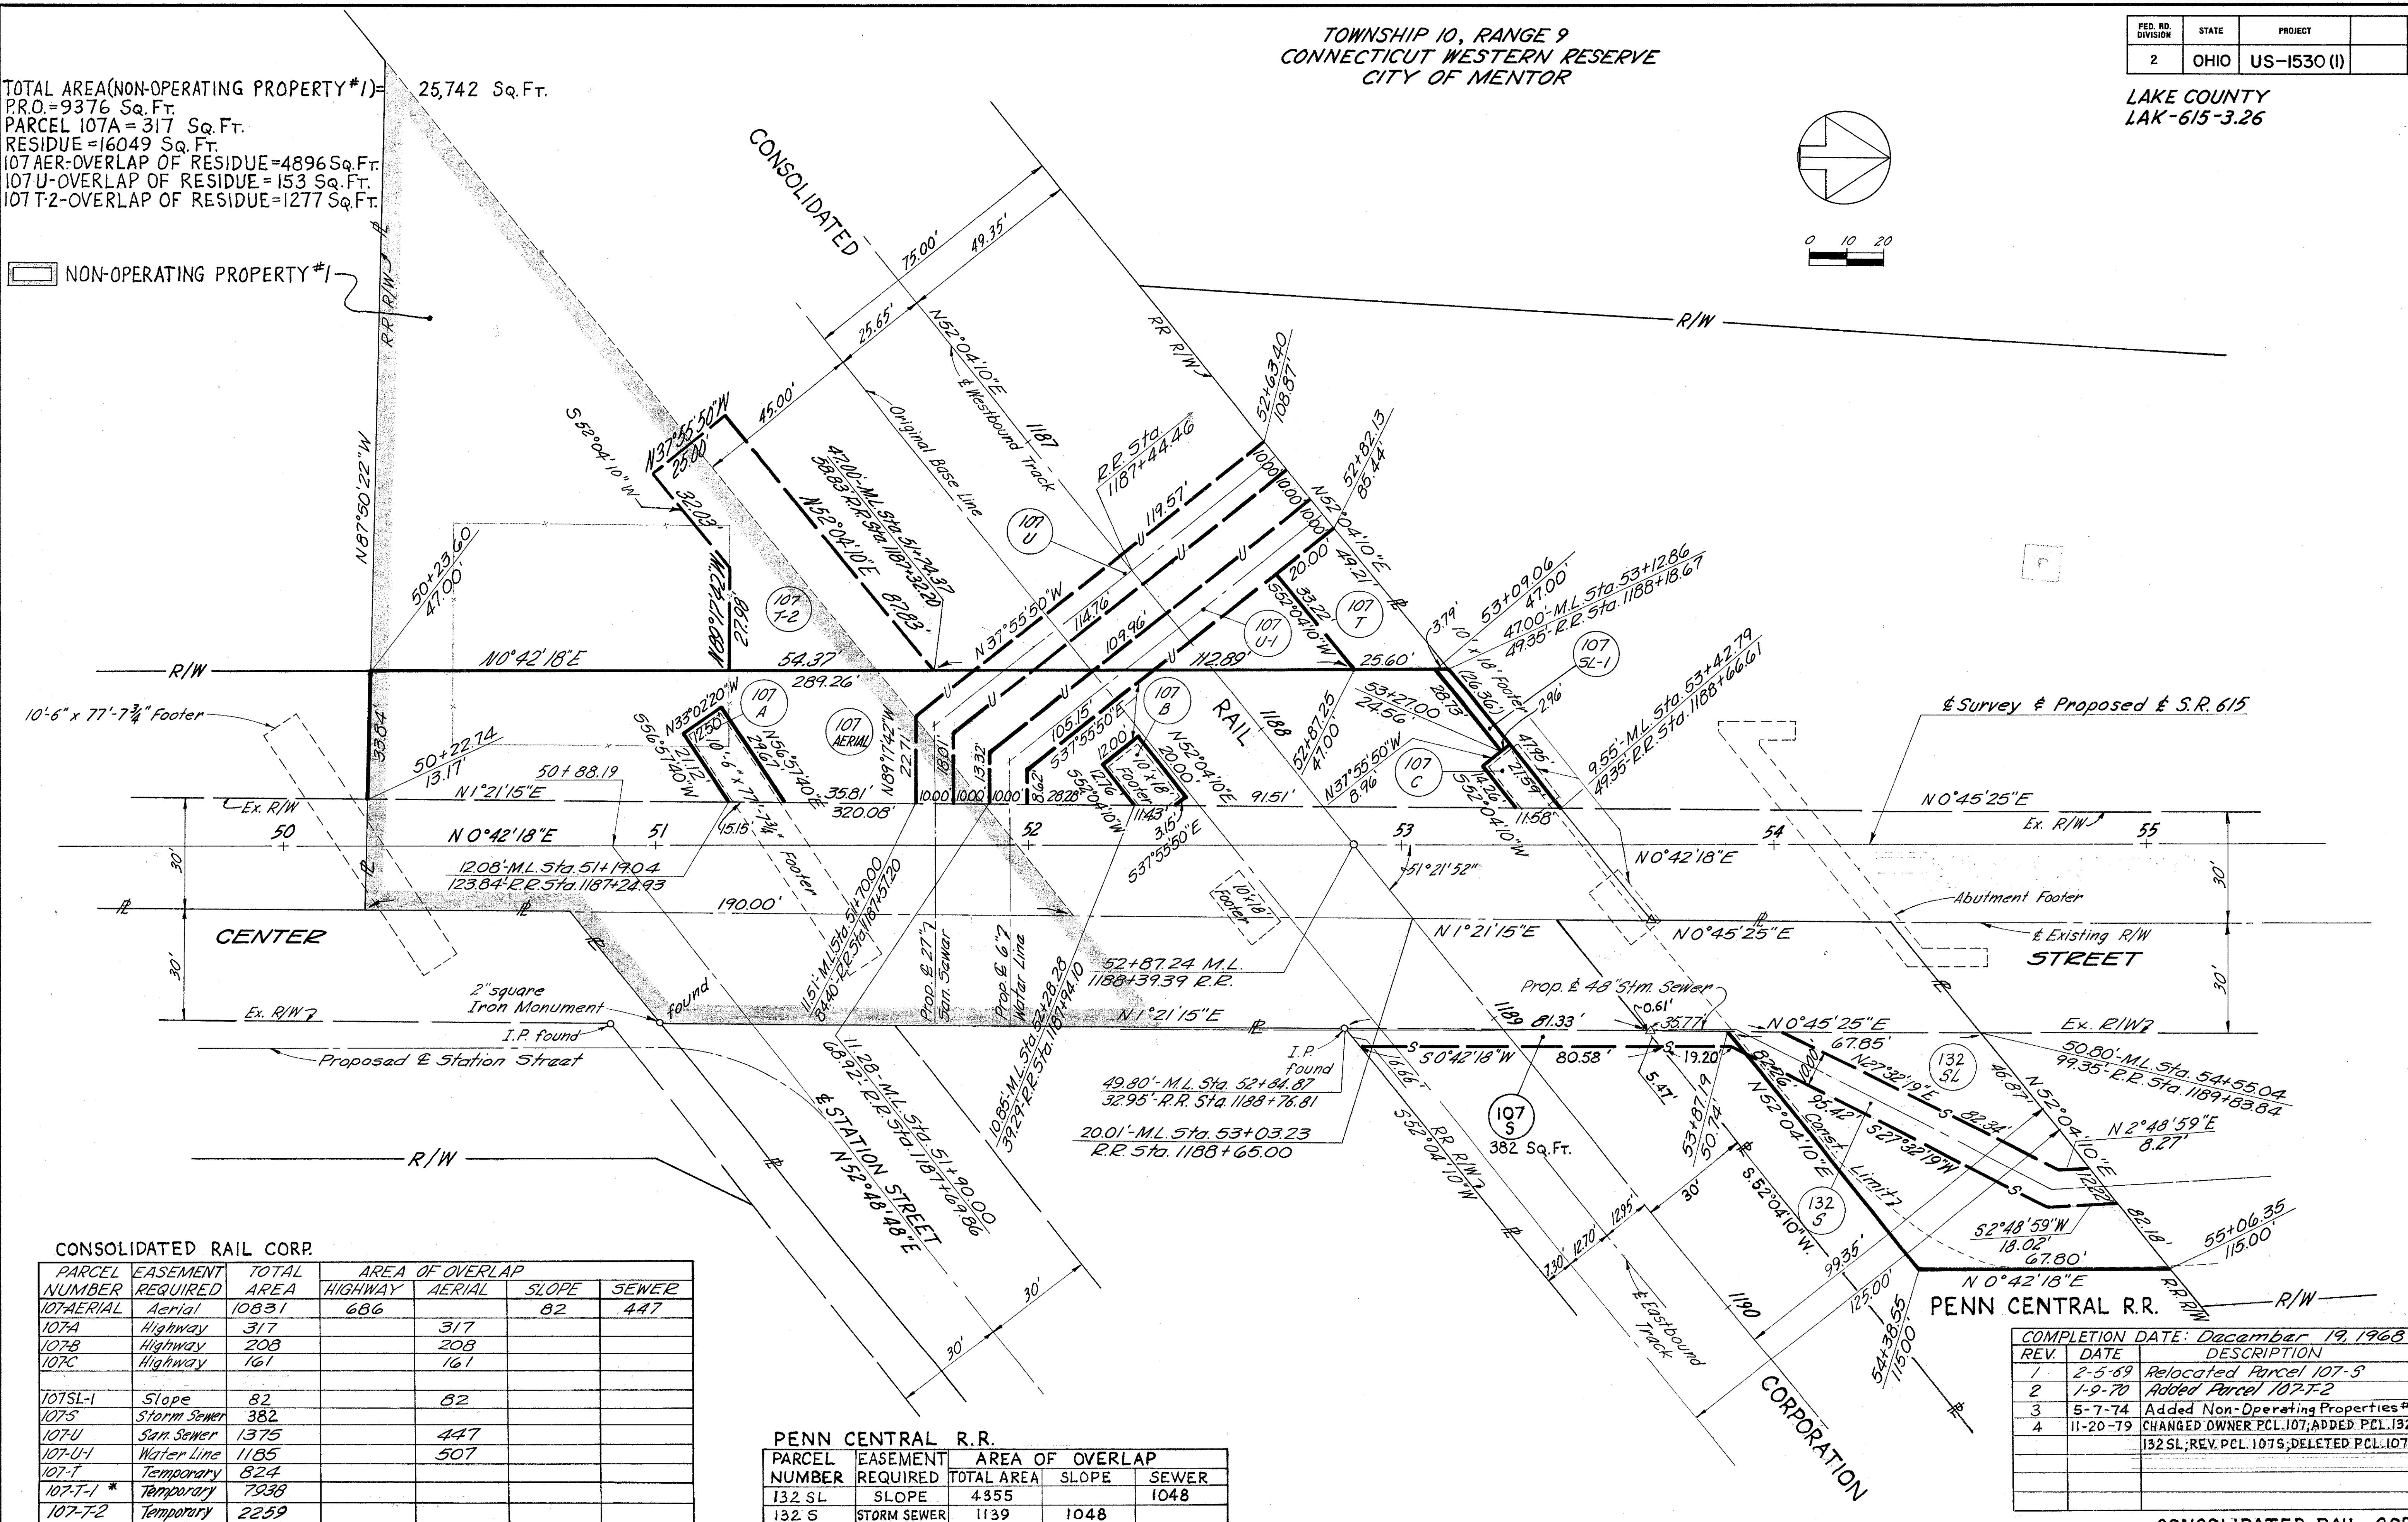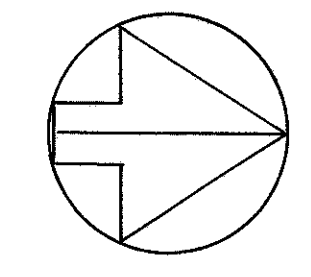

CONSOLIDATED RAIL CORP.

PARCEL NUMBER	EASEMENT REQUIRED	TOTAL AREA	AREA OF OVERLAP			
			HIGHWAY	AERIAL	SLOPE	SEWER
107-AERIAL	Aerial	10831	686		82	447
107A	Highway	317		317		
107B	Highway	208		208		
107C	Highway	161		161		
107SL-1	Slope	82		82		
107S	Storm Sewer	382				382
107U	San Sewer	1375				447
107-U-1	Water Line	1185				507
107-T	Temporary	824				
107-T-1 *	Temporary	7238				
107-T-2	Temporary	2259				

PENN CENTRAL R.R.

PARCEL NUMBER	EASEMENT REQUIRED	TOTAL AREA	AREA OF OVERLAP	
			SLOPE	SEWER
132 SL	SLOPE	4355		1048
132 S	STORM SEWER	1139	1048	

COMPLETION DATE: December 19, 1968

REV.	DATE	DESCRIPTION
1	2-5-69	Relocated Parcel 107-S
2	1-9-70	Added Parcel 107-T-2
3	5-7-74	Added Non-Operating Properties #1 & #2
4	11-20-79	CHANGED OWNER PCL. 107; ADDED PCL. 132 S & #132 SL; REV. PCL. 107S; DELETED PCL. 107SL

* See Sheet 26

AREA IN SQUARE FEET

RIGHT OF WAY CONSOLIDATED RAIL CORP. AND PENN CENTRAL RAILROAD