




JUNCTION CHAMBER PLAN  
STA. 4+443.7, 35m LT.

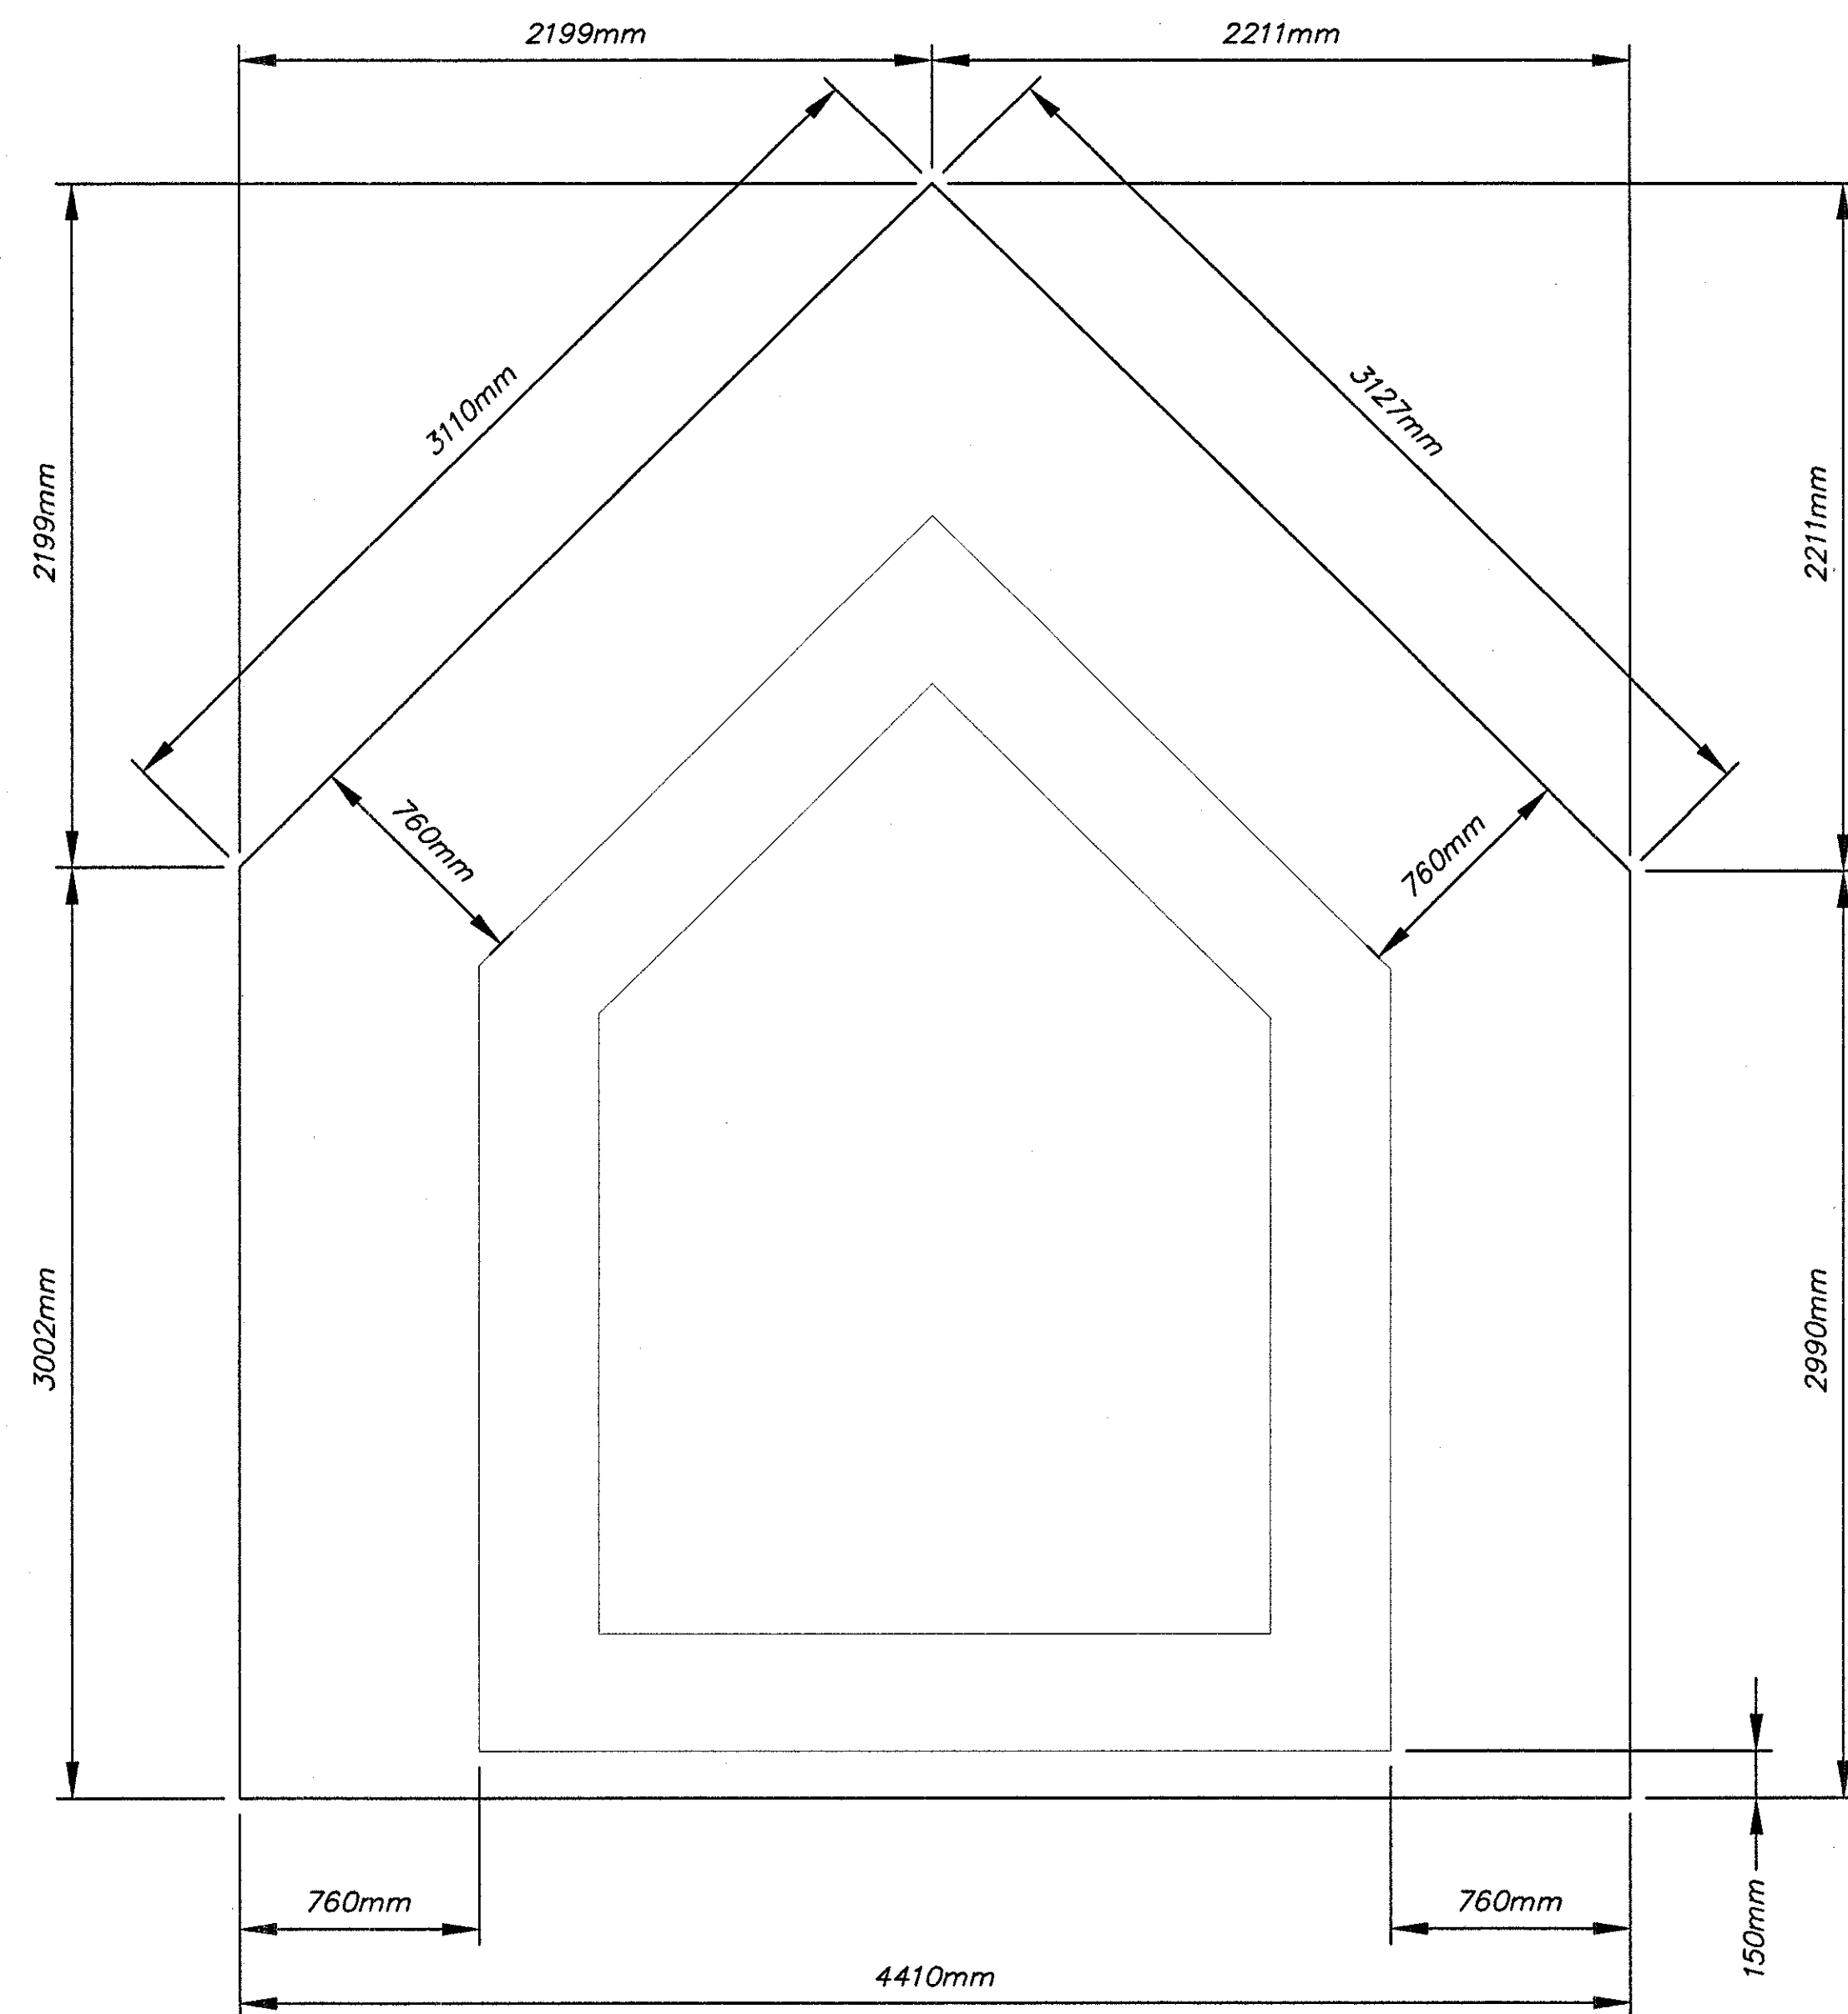

BOTTOM SLAB (LAYOUT)

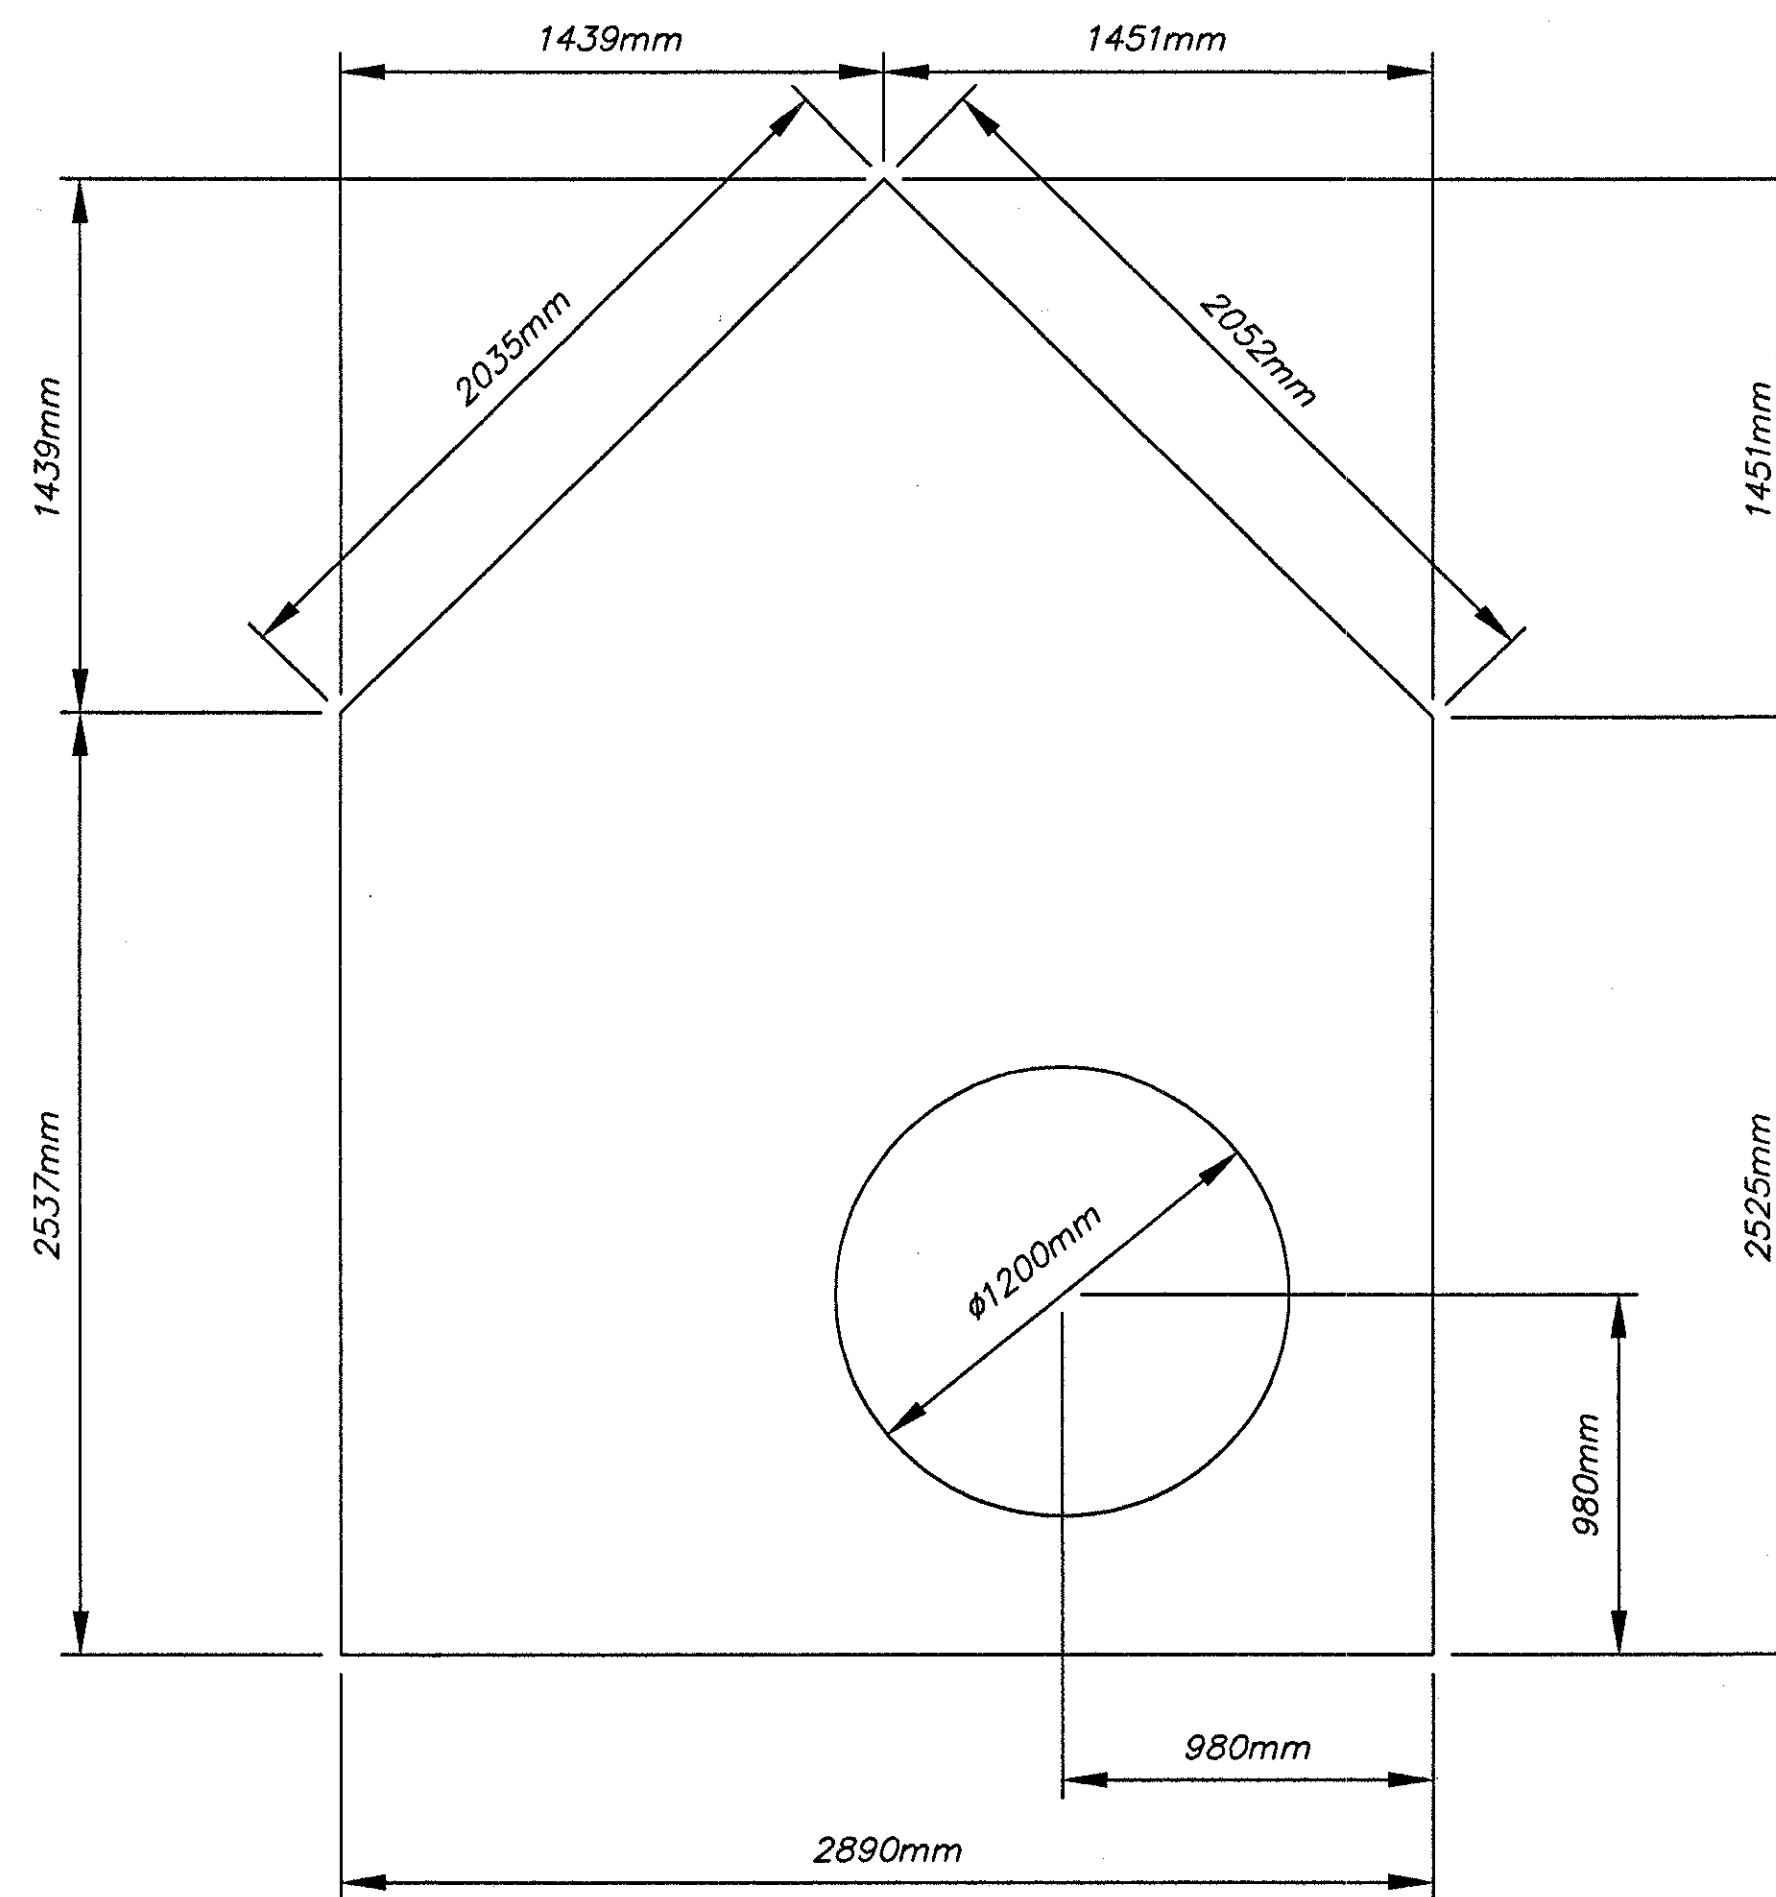

TOP SLAB (LAYOUT)

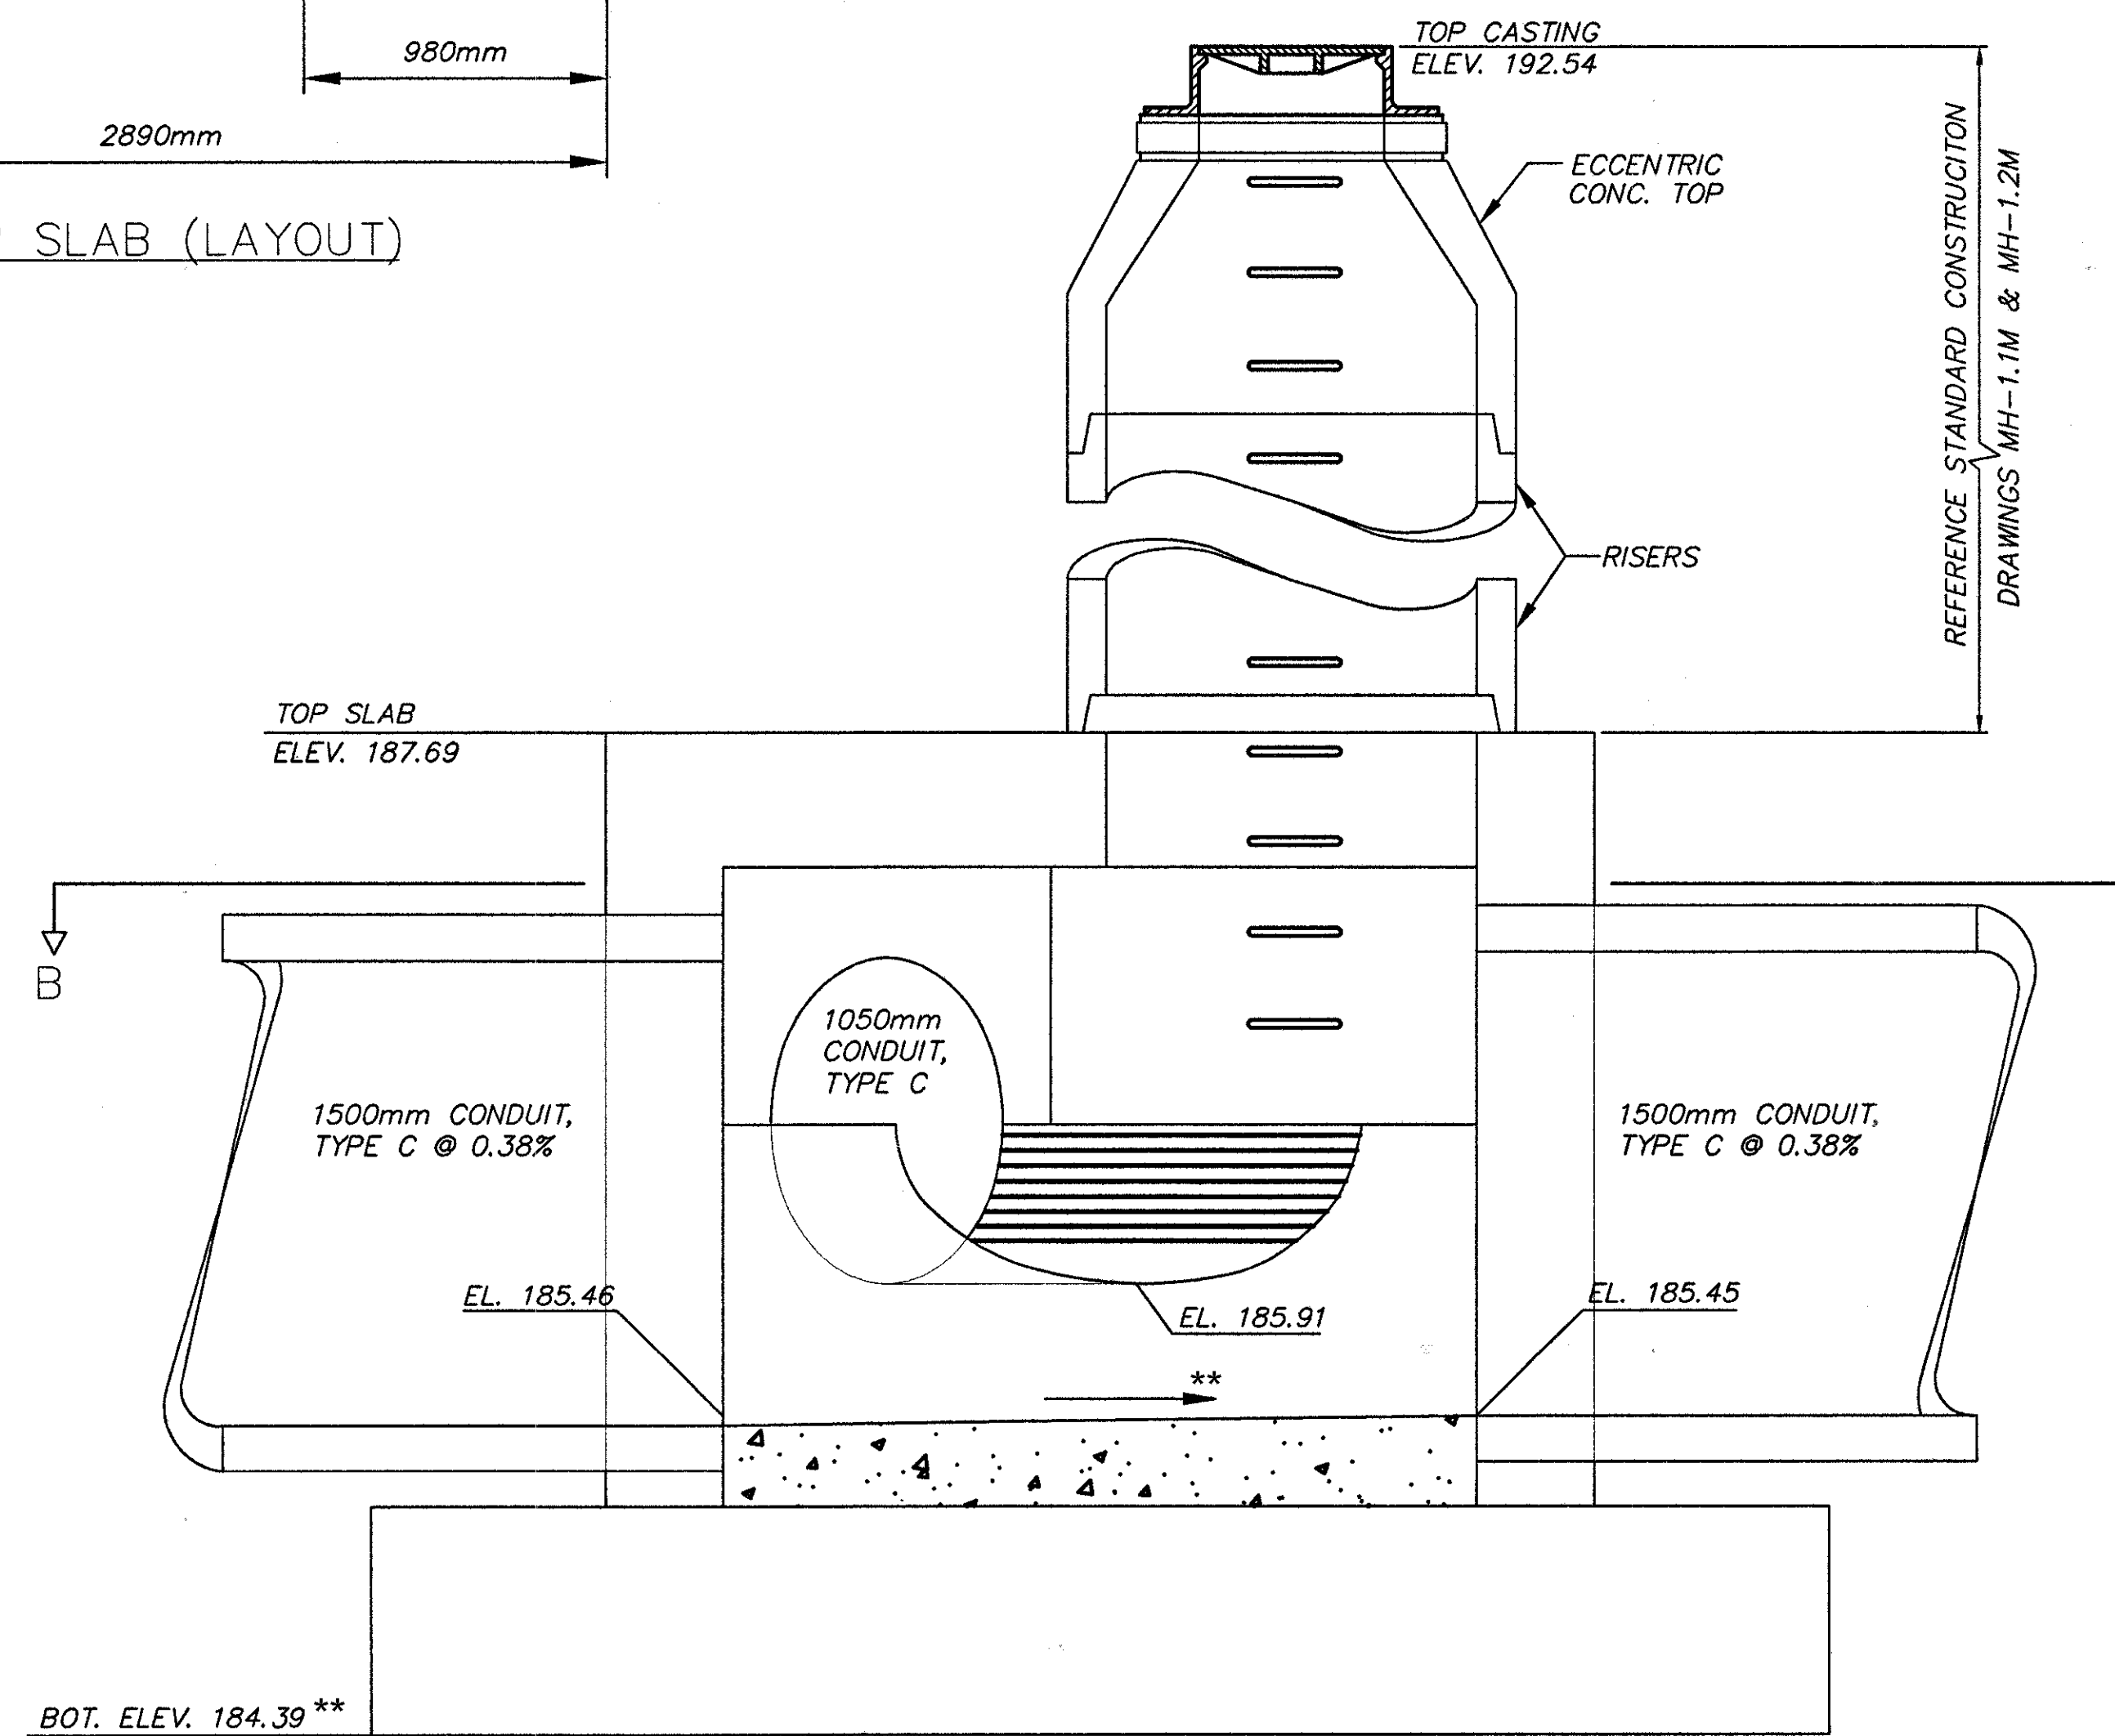

SECTION A-A

\*\*Revised 08/06/02

AS SHOWN  
HORIZONTAL  
SCALE IN METERS

DRAINAGE DETAILS  
JUNCTION CHAMBER

LAK-640-3.444

185  
214