


MICROFILMED
JUL 1 1988

TYPICAL SECTIONS

TYPE 404

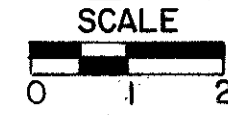


FHWA REGION	STATE	PROJECT
5	OHIO	

8
31

LAKE COUNTY
LAK-84-27.17

PROPOSED PAVEMENT


- ① 404 ASPHALT CONCRETE, AC-20
- ② 403 ASPHALT CONCRETE, AC-20
- ③ 305 7" CONCRETE BASE
- ④ 310 SUBBASE, TYPE II, AS PER PLAN
- ⑤ 304 AGGREGATE BASE, AS PER PLAN
- ⑦ 606 6" SHALLOW PIPE UNDERDRAIN, AS PER PLAN
- ⑧ 407 TACK COAT, AS PER PLAN
- ⑨ 609 ASPHALT CONCRETE CURB, AC-20, STANDARD TYPE I
- ⑩ 609 CURB, STANDARD TYPE 6
- ⑪ SPECIAL PAVEMENT PLANING BITUMINOUS, WITHOUT HEATING (SEE PROPOSAL NOTE)
- ⑫ 301 BITUMINOUS AGGREGATE BASE, AC-20
- ⑬ 606 GUARDRAIL, TYPE 5
- ⑭ 203 SUBGRADE COMPACTION
- ⑥ NOT USED

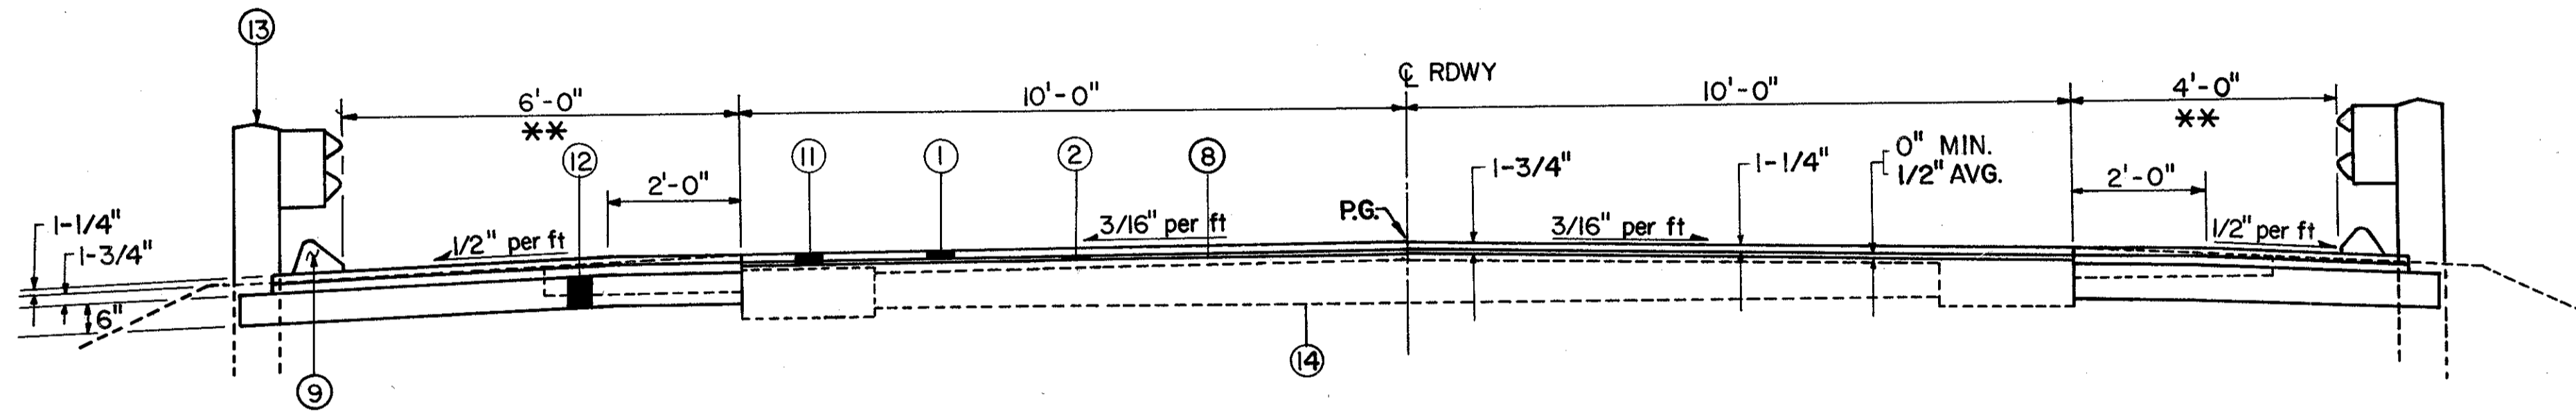

MODIFIED EXISTING SECTION

STA. 100+34.00 LT. TO STA. 101+21.00 LT.
STA. 100+34.00 RT. TO STA. 102+31.00 RT.

** DOES NOT MEET STANDARD GRADED SHOULDER WIDTH (10 FEET)

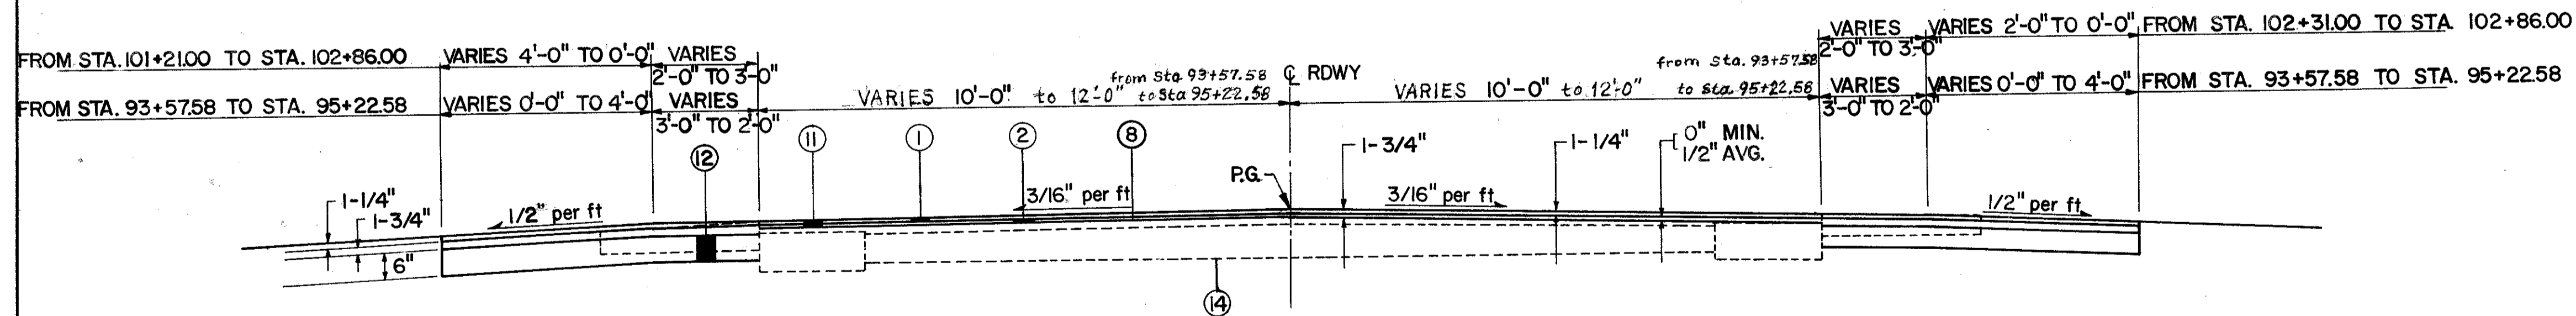

MODIFIED EXISTING SECTION

STA. 93+57.58 TO STA. 95+22.58
STA. 101+21.00 LT. TO STA. 102+86.00 LT.
STA. 102+31.00 RT. TO STA. 102+86.00 RT.