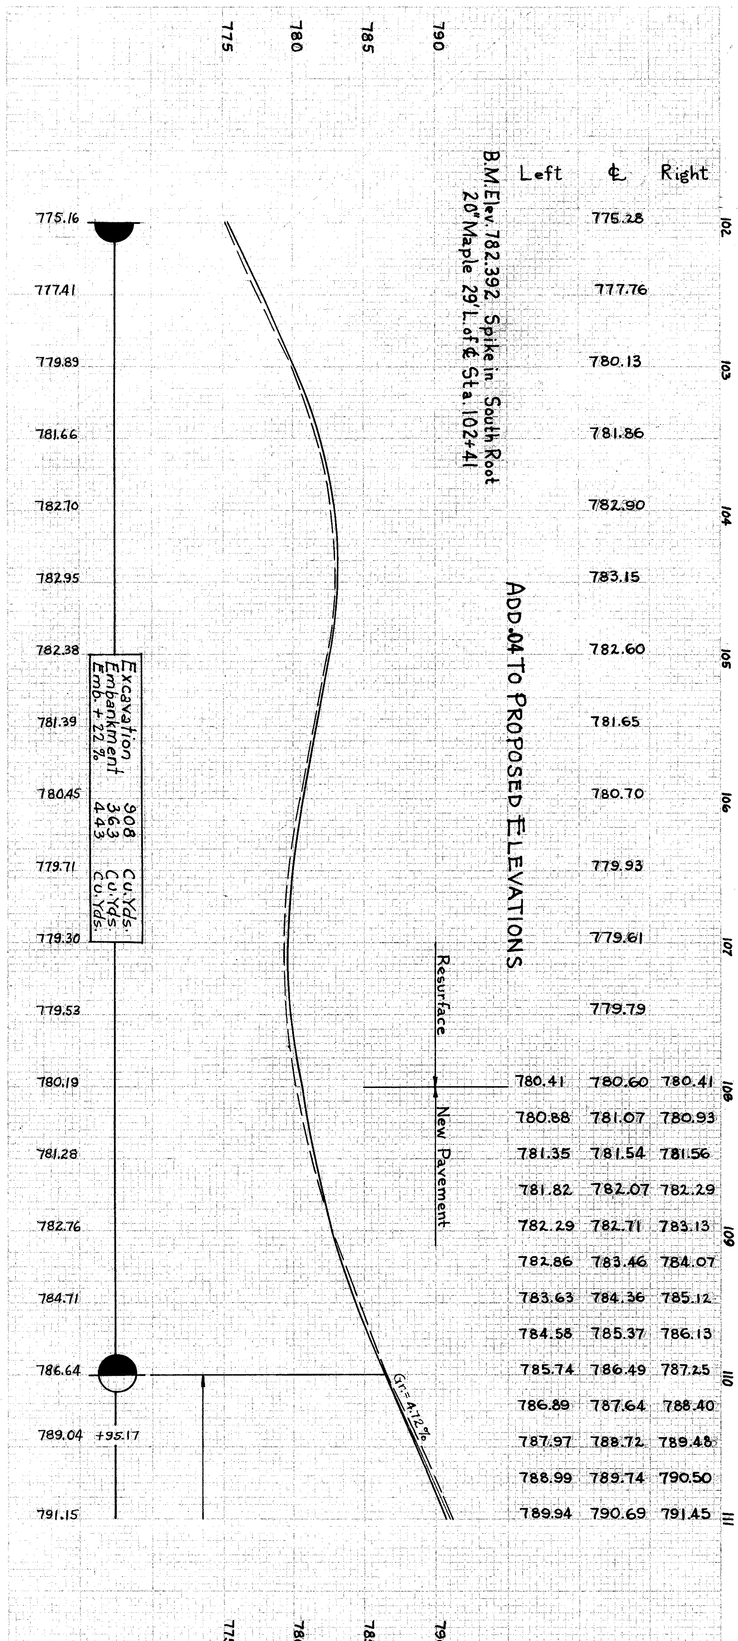

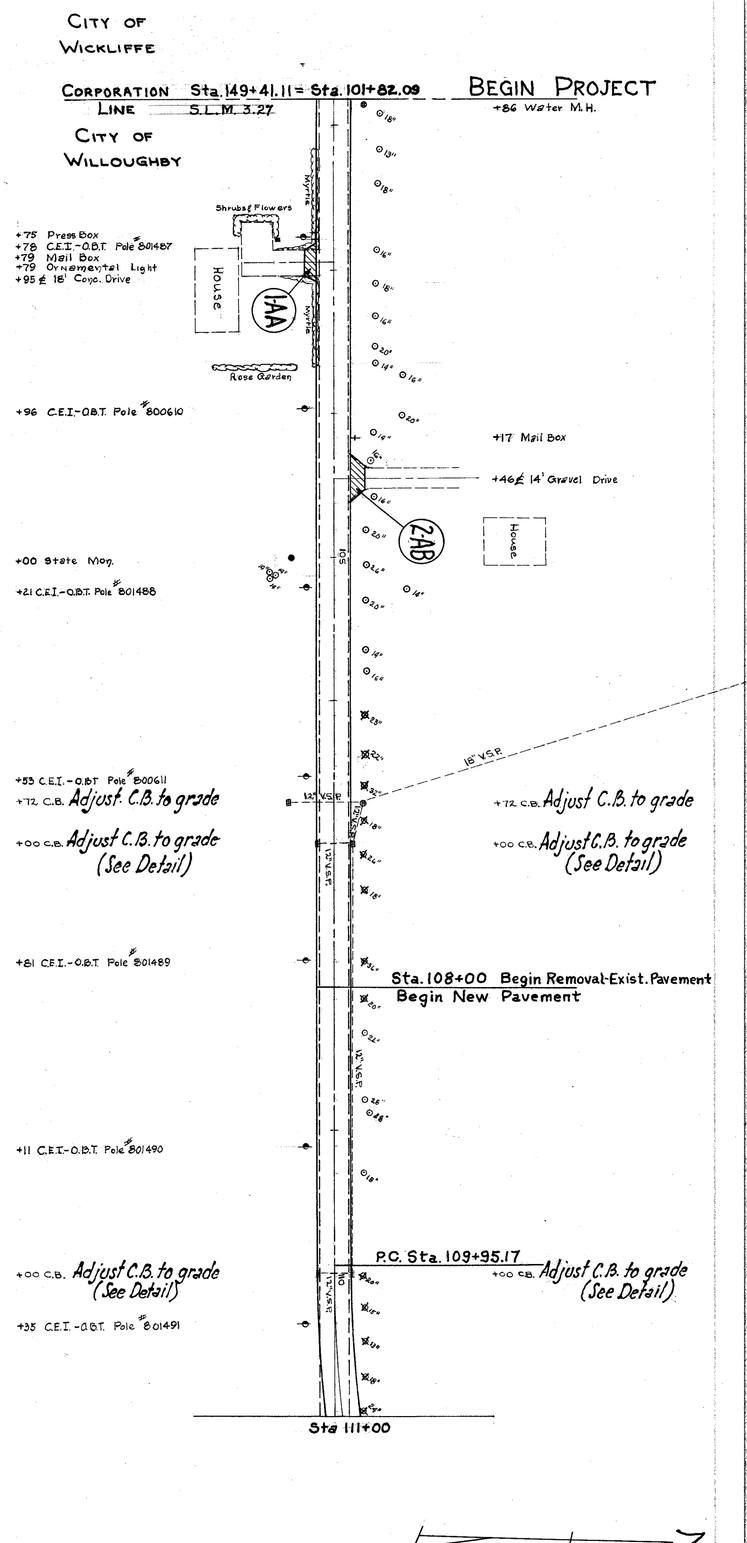

ESTIMATED QUANTITIES

REF. NO.	STATION TO STATION	SIDE	5" Crushed Aggreg. Base Course Sq.Yds.	2" Asph. Conc. Surface Course Sq.Yds.	7" Plain Conc. Pavement T-70 Sq.Yds.	Excavation Cu.Yds.	Removal & Disp. of Exist. Pavement Sq.Yds.	Adjust C.B. to grade (See Detail) Each	Adjust to Grade Water M.H.'s Each	Adjust to Grade Catch Basin Each	SEE SHEET NO.
	DRIVES										
	1-AA	R			19	4					
	2-AB	L	27	27		5					
	MANHOLES								1		
	PAVEMENT REMOVAL 108+00 to 111+00						733				
	CATCHBASINS							4		2	
	TOTALS		27	27	19	9	733	4	1	2	

PLAN & PROFILE STA. 101+82.09 TO STA. 111+00

LAK. 84 (3.27-7.81)
LAKE COUNTY

FED. RD. DIVISION	STATE	PROJECT	TYPE
2	OHIO		

9
83