LAK. 84 (3.27-7.81)
LAKE COUNTY

Excavation	364	Cu.Yds.
Embankment	209	Cu.Yds.
Emb. + 22 %	255	Cu.Yds.

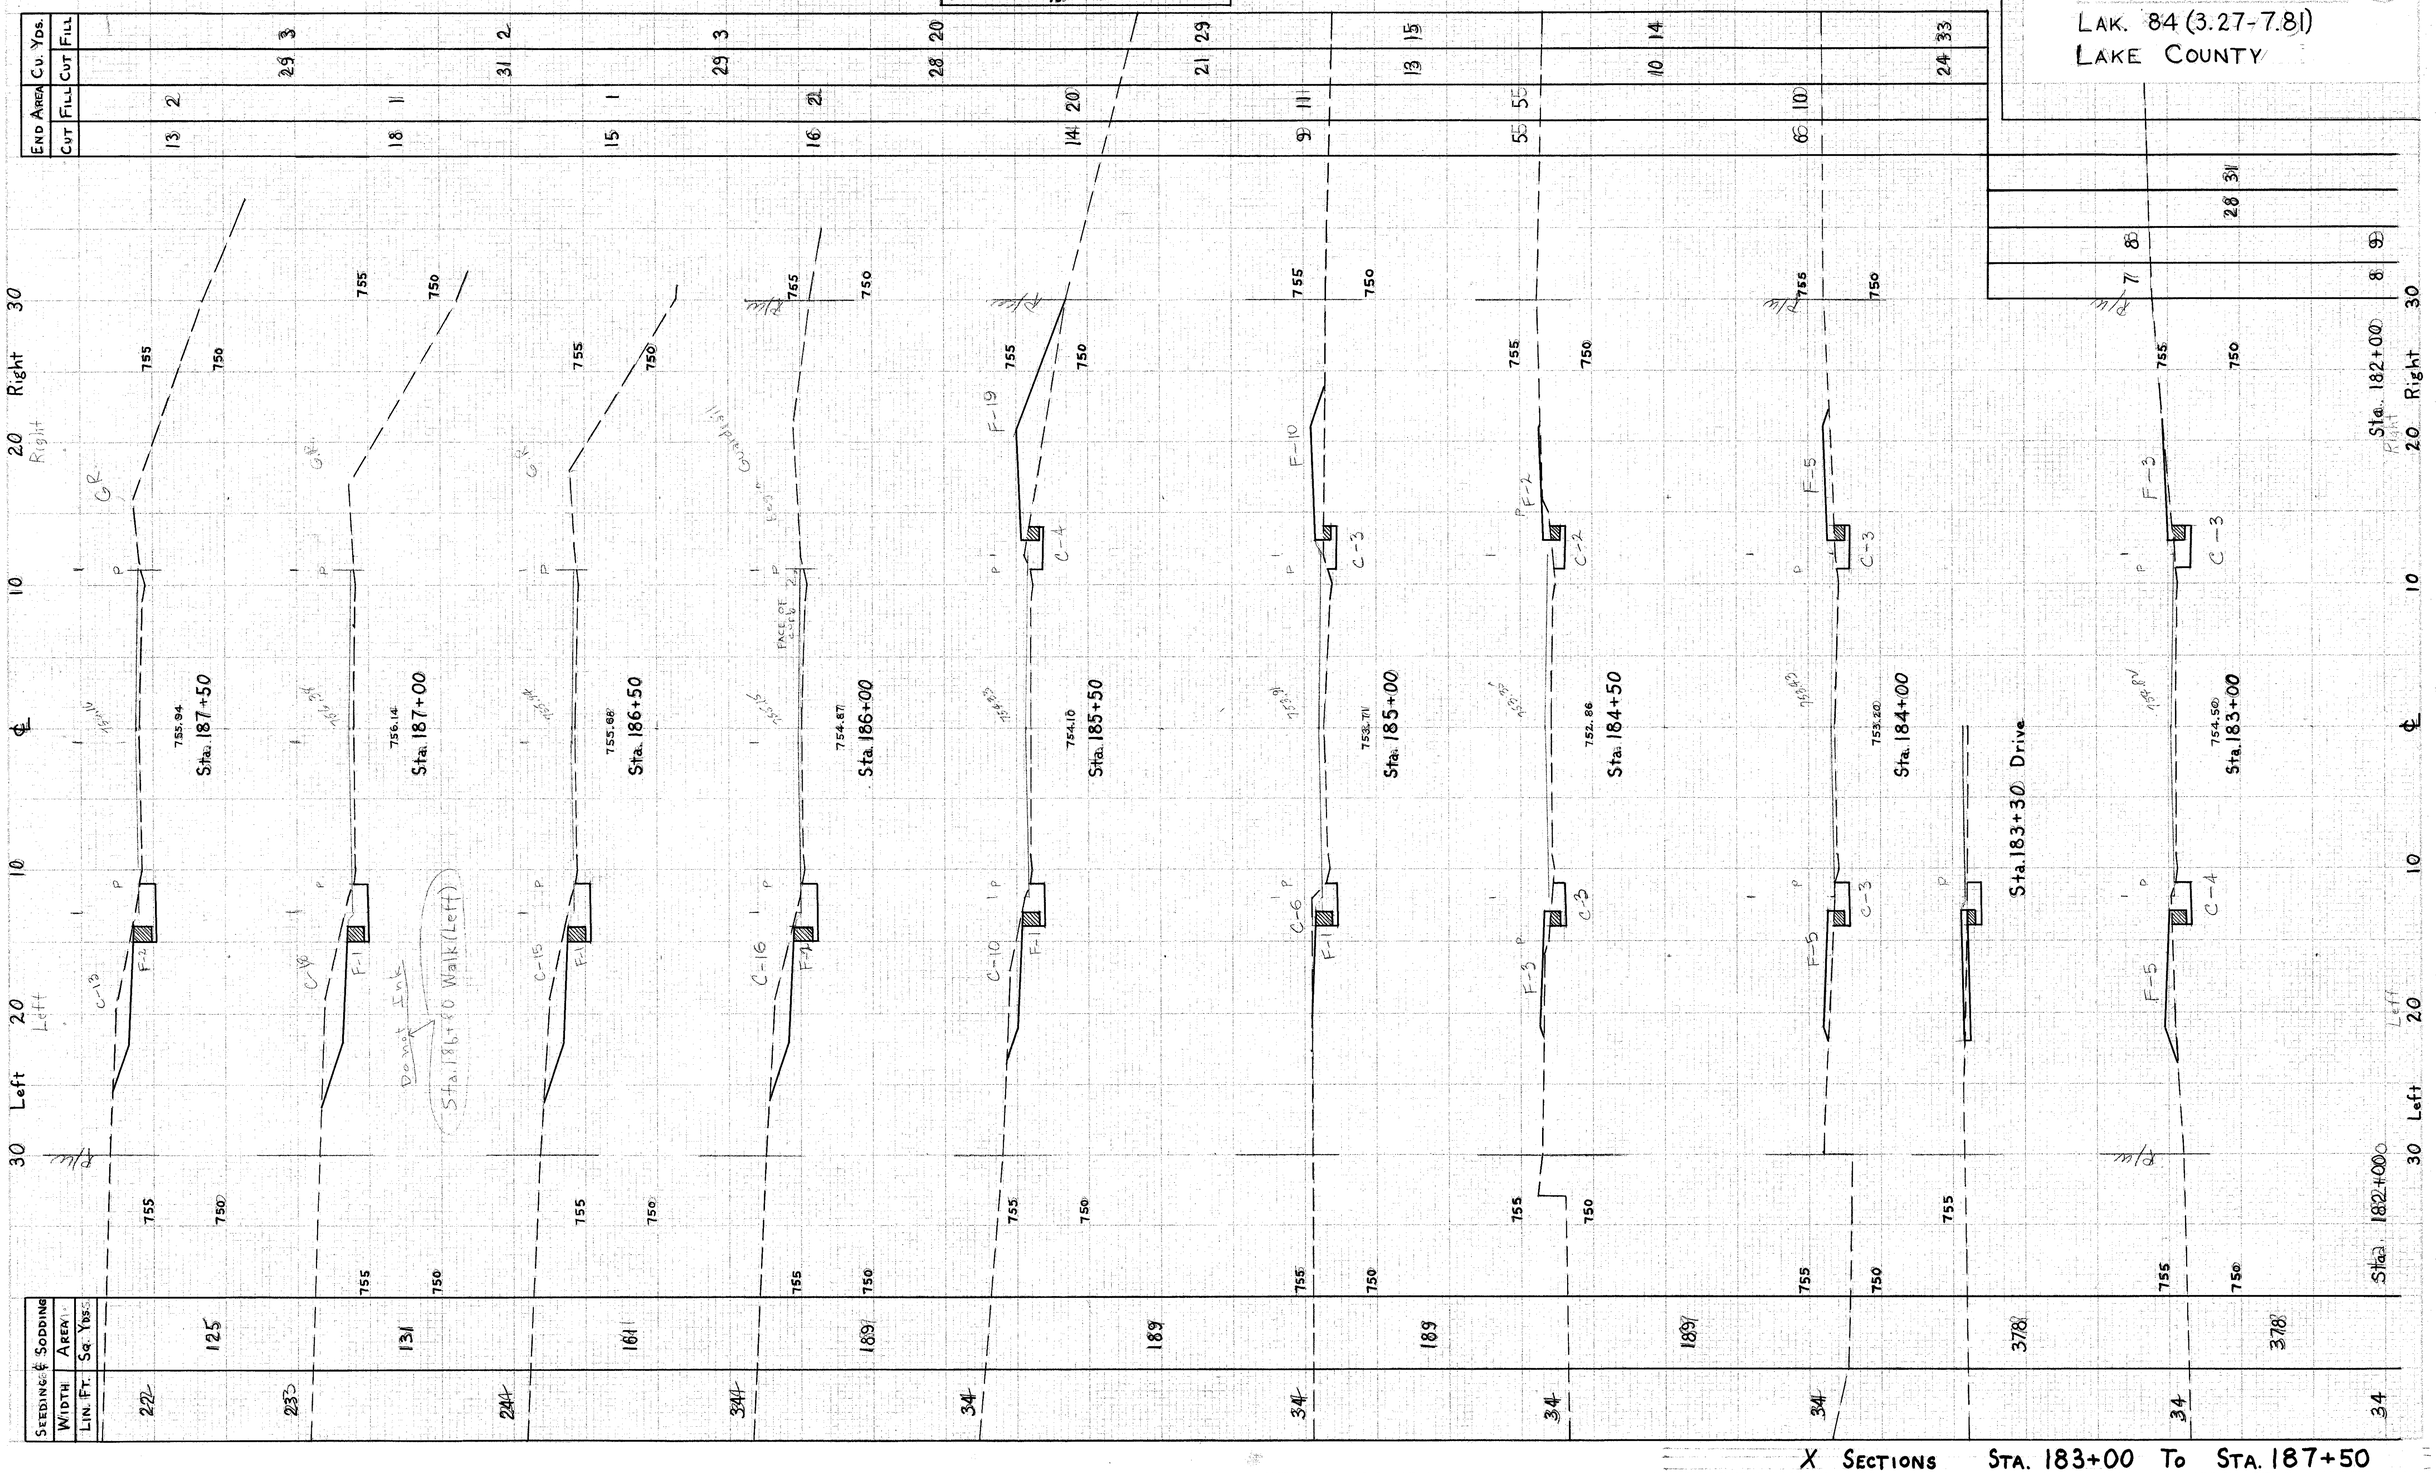

X SECTIONS STA. 183+00 TO STA. 187+50