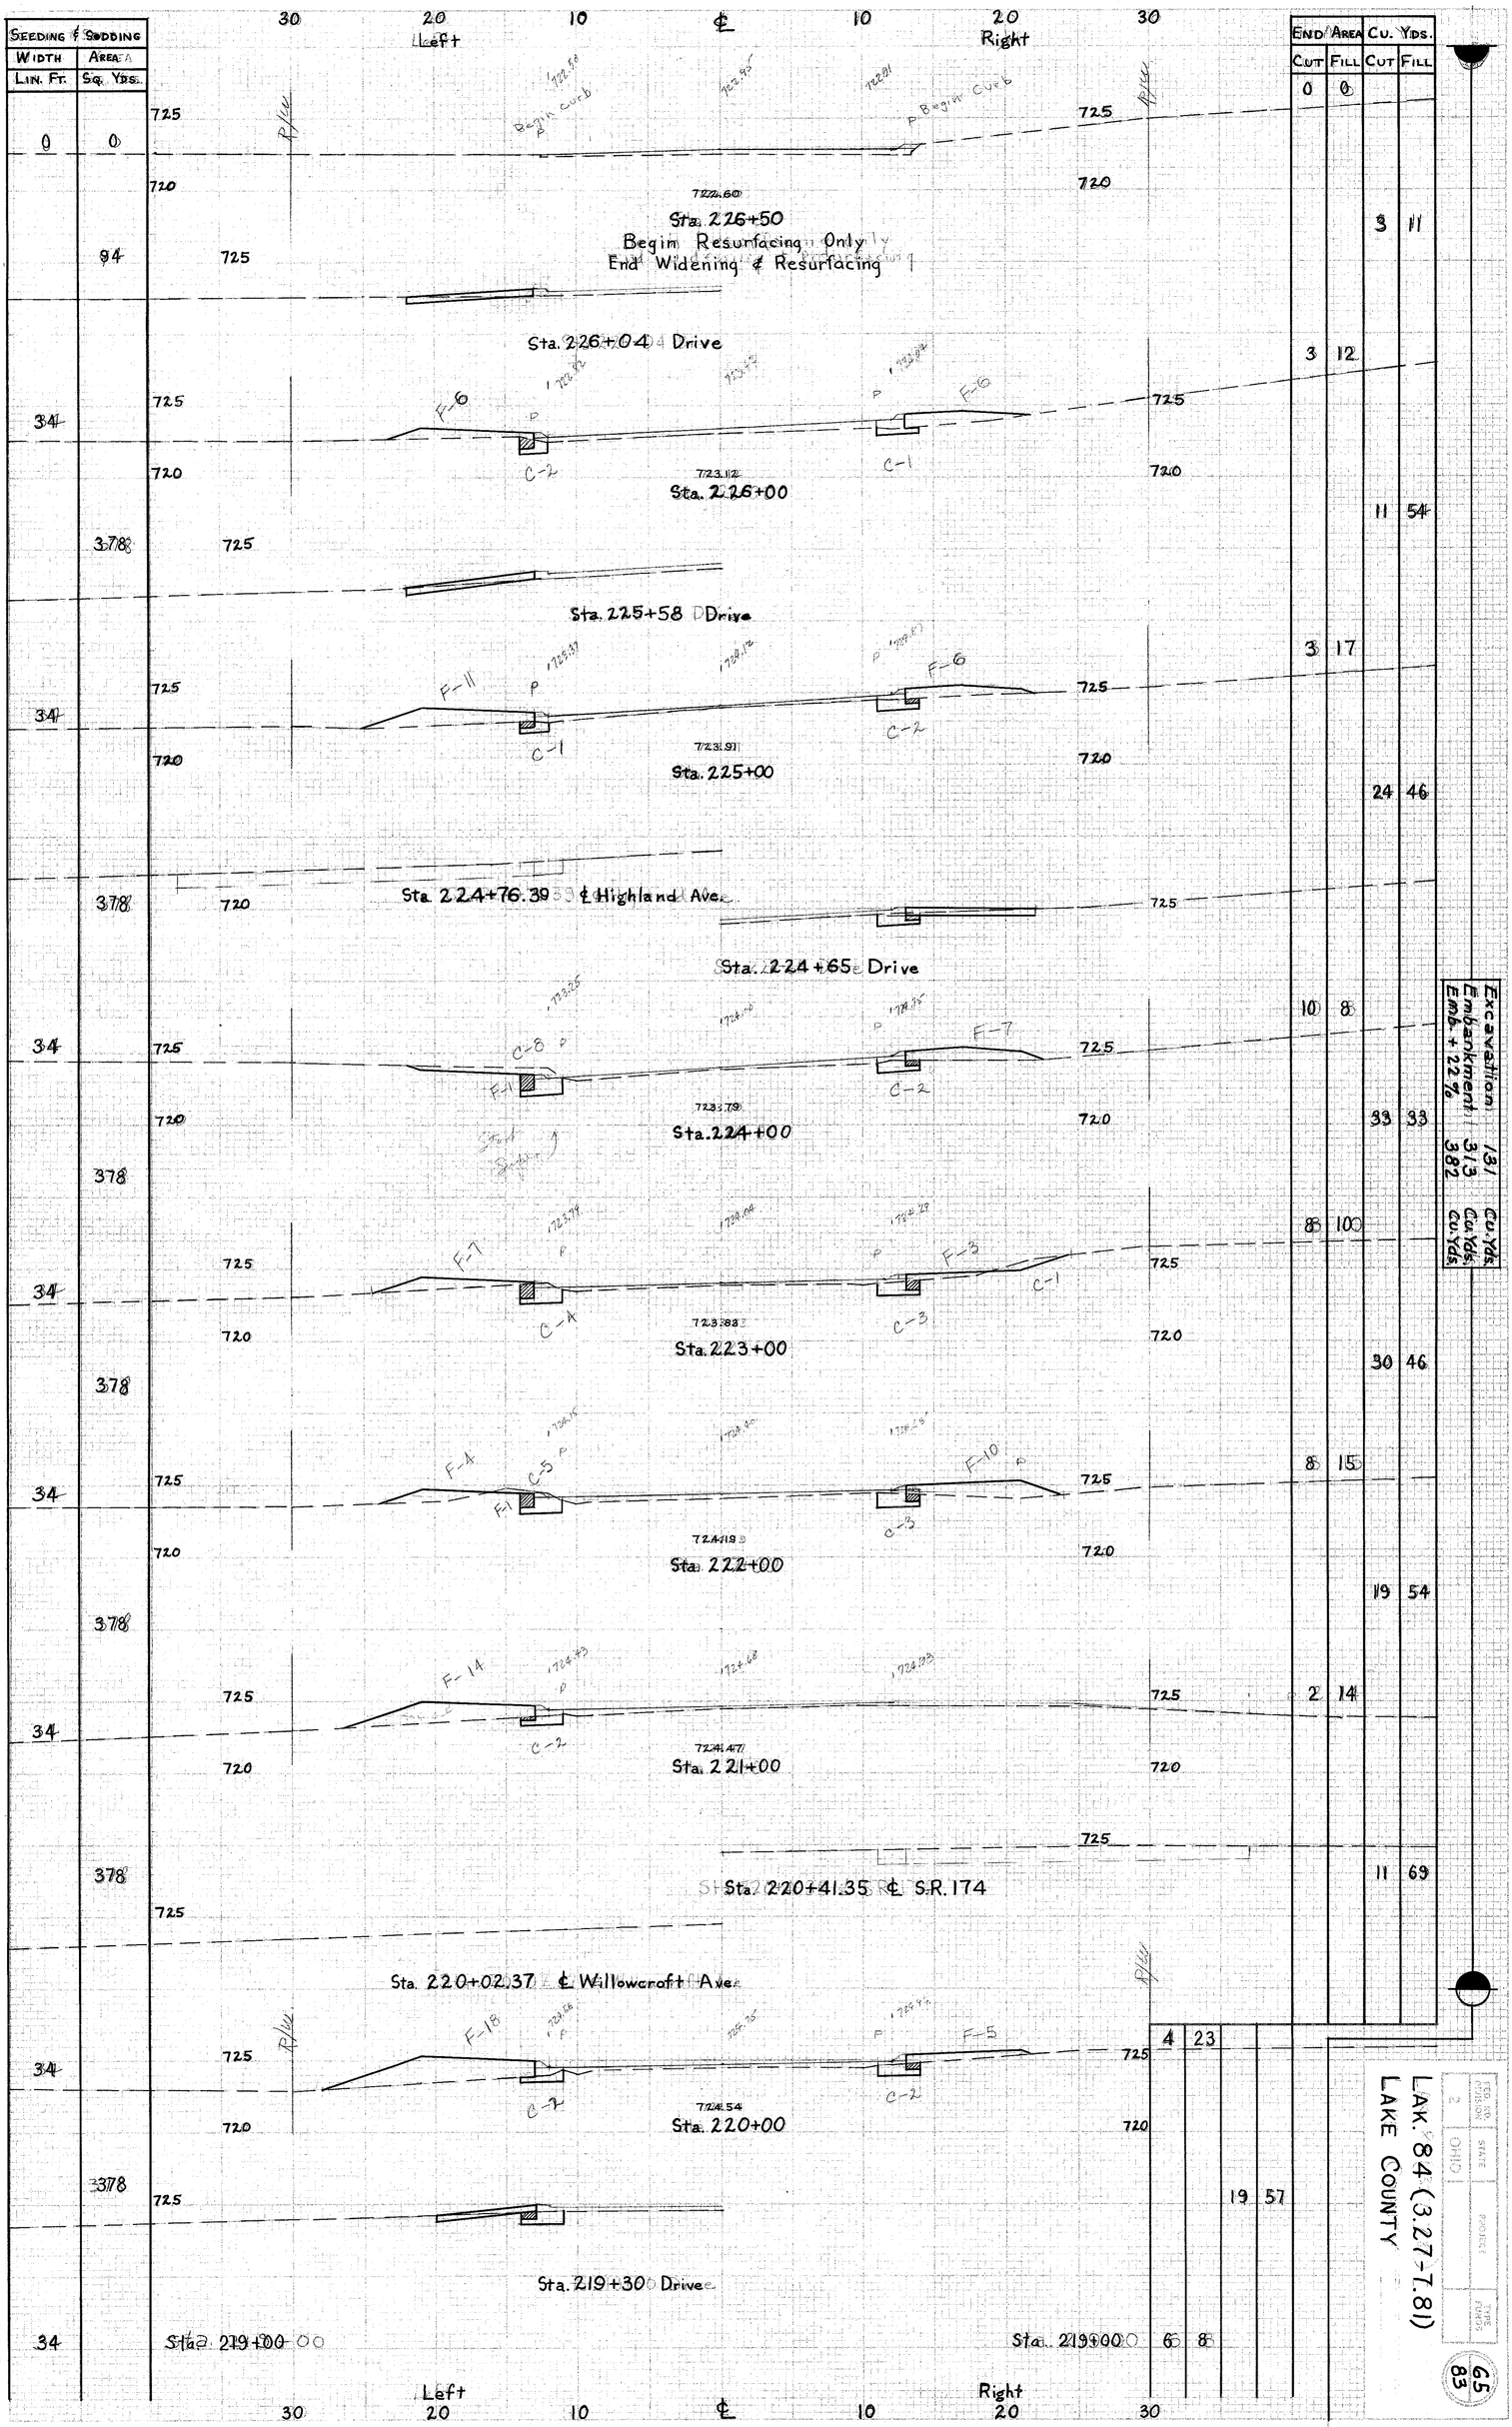
Seeding & Sodding
Width Lin. Ft.
Area Sq. Yds.
30 20 10 ℄ 10 20 30
Left
Right
End Area Cu. Yds.
Cut Fill Cut Fill
0 0
725
720
Begin Curb
722.60
Sta. 226+50
Begin Resurfacing Only
End Widening & Resurfacing
94
3 11
Sta. 226+04 Drive
3 12
F-6
C-2
C-1
723.12
Sta. 226+00
378
11 54
Sta. 225+58 Drive
3 17
F-11
F-6
C-1
C-2
723.91
Sta. 225+00
24 46
Sta. 224+76.39 ℄ Highland Ave.
Sta. 224+65 Drive
10 8
F-8
F-7
C-2
723.79
Sta. 224+00
33 33
8 10
F-7
F-3
C-4
C-3
C-1
723.88
Sta. 223+00
30 46
F-4
C-5
F-10
C-3
724.19
Sta. 222+00
8 15
19 54
F-14
C-2
724.47
Sta. 221+00
2 14
Sta. 220+41.35 ℄ S.R. 174
11 69
Sta. 220+02.37 ℄ Willowcroft Ave.
F-18
F-5
C-1
C-2
724.54
Sta. 220+00
4 23
Sta. 219+30 Drive
19 57
Sta. 219+00.00
Sta. 219+00.00
6 8
Excavation 131 Cu. Yds.
Embankment 313 Cu. Yds.
Emb. + 22% 382 Cu. Yds.
X Sections Sta. 219+30 To Sta. 226+50
LAK. 84 (3.27-7.81)
LAKE COUNTY
FED. ROAD PROJECT NO.
STATE
PROJECT
TYPE WORK
OHIO
65
83