


LAK. 84 (3.27-7.81)
LAKE COUNTY

68
83

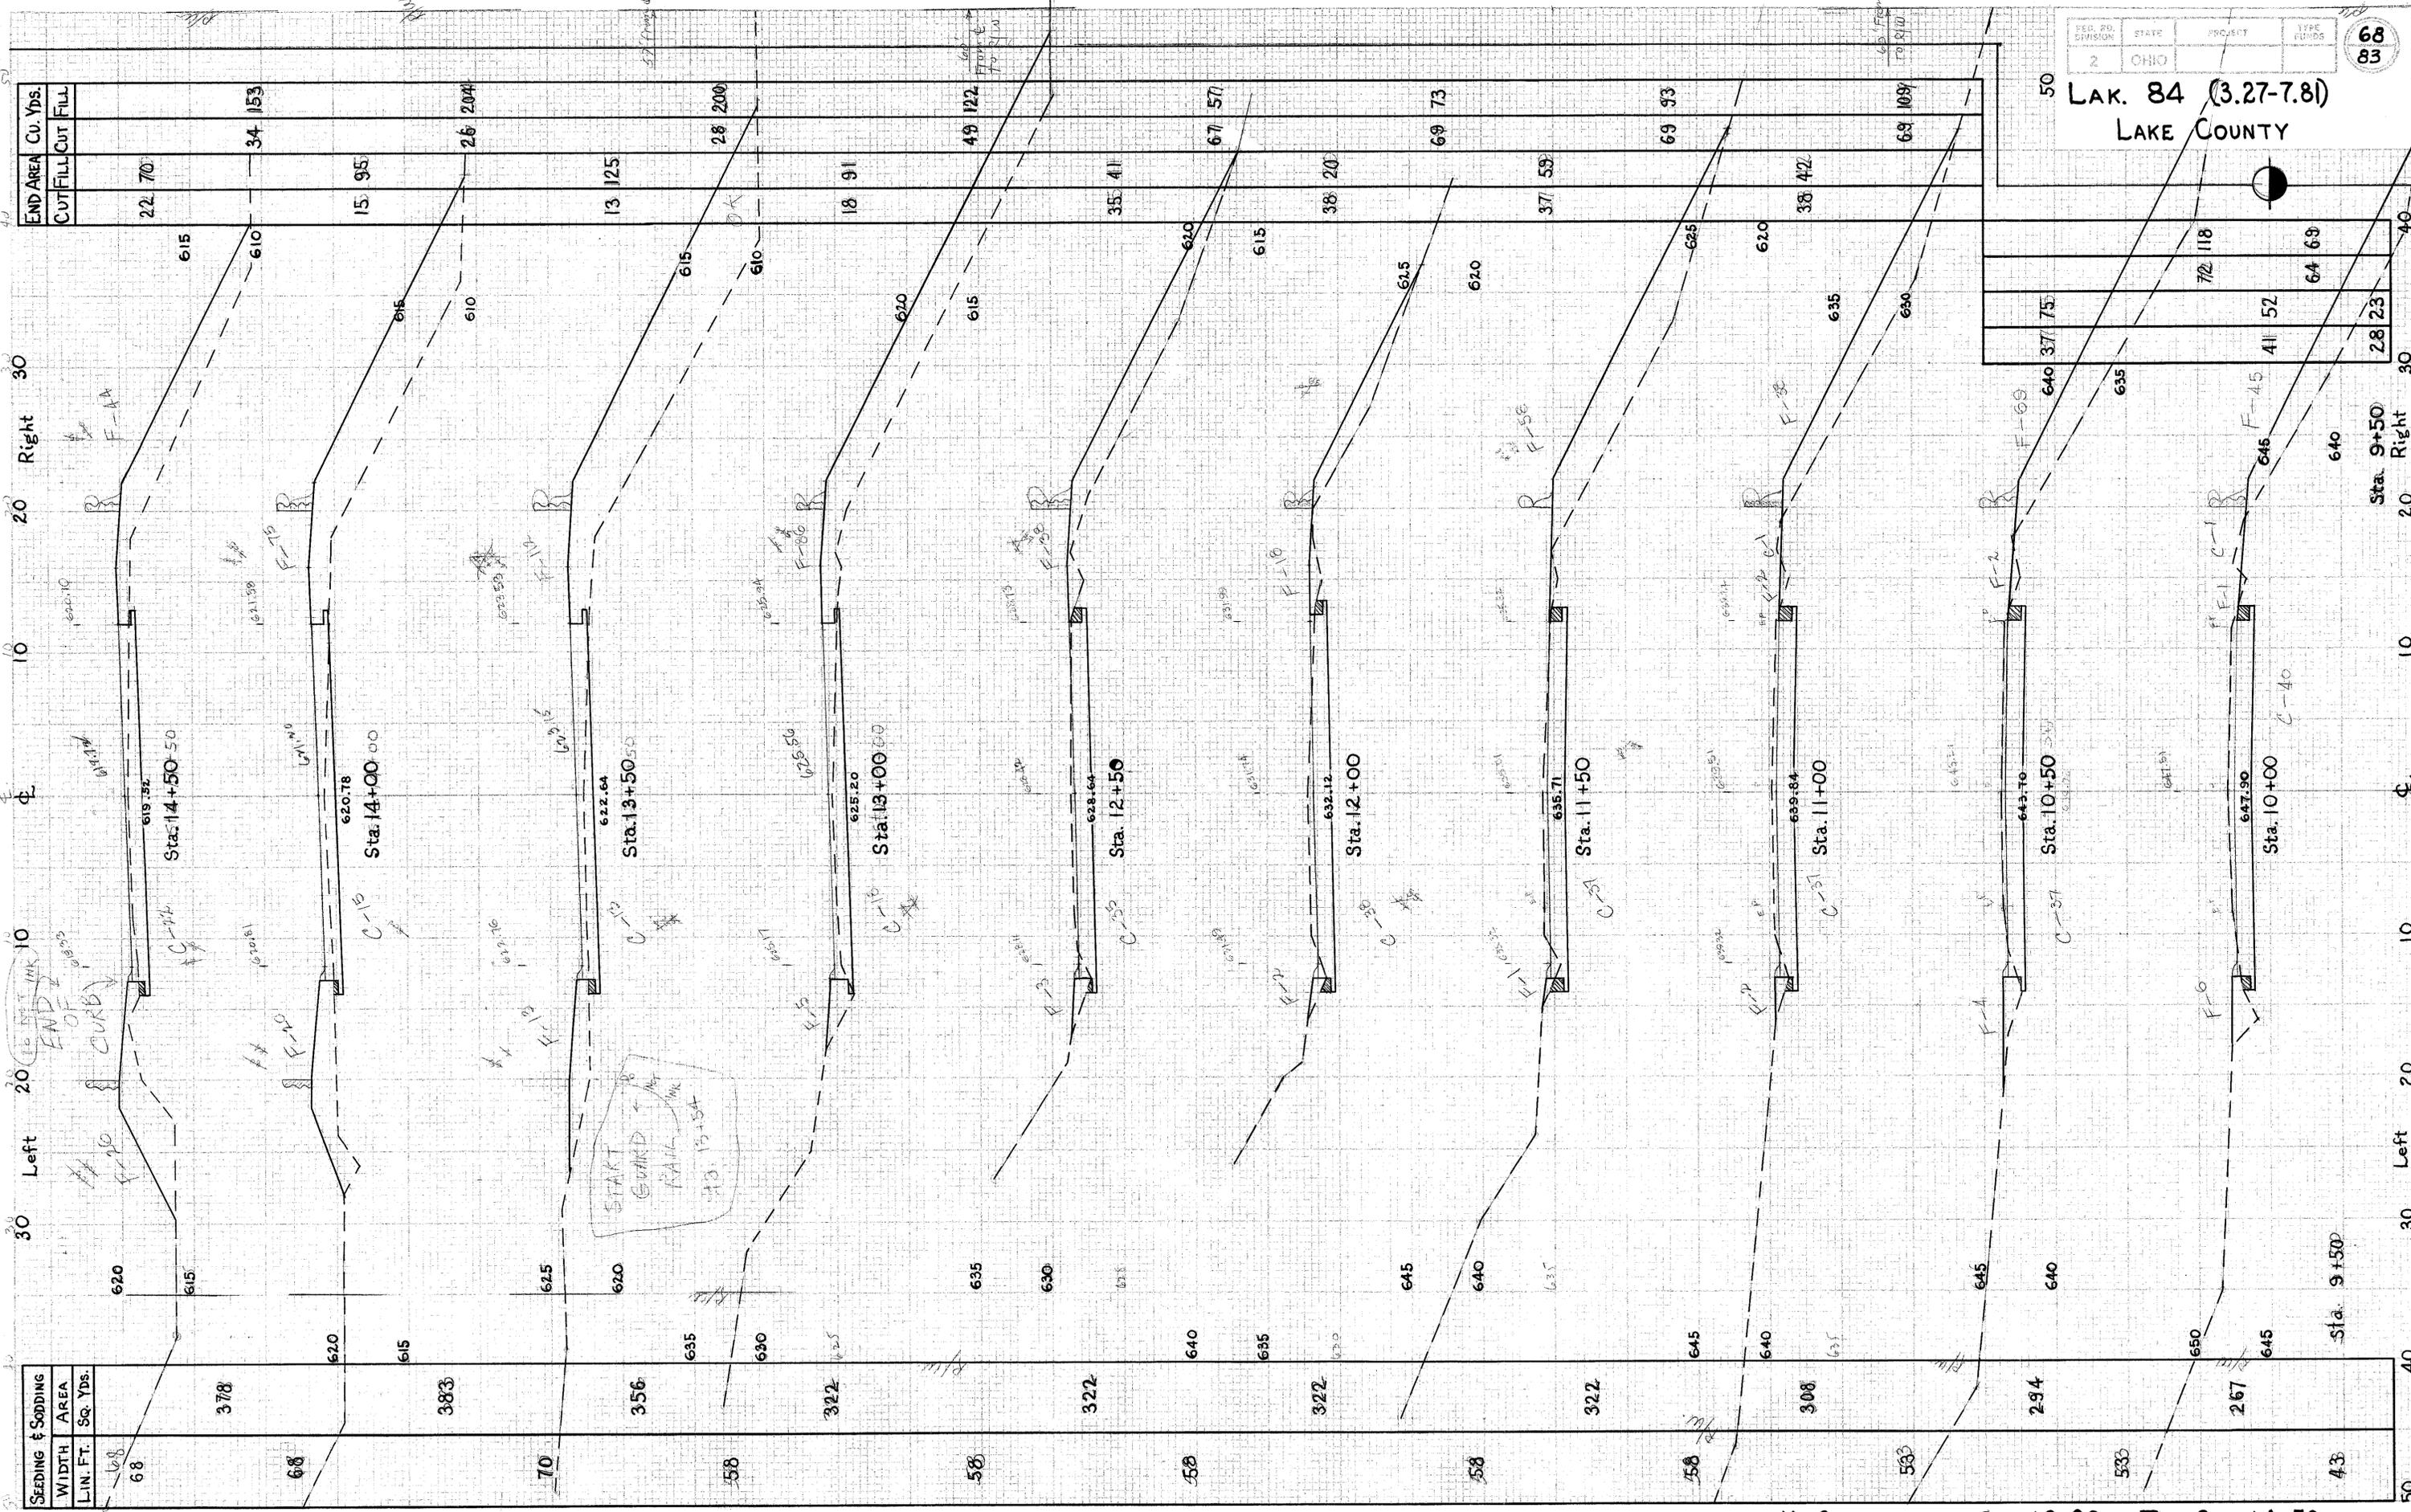

END AREA	Cu. Yds.
CUT	FILL
22	70
34	153
15	95
26	204
13	125
28	200
18	91
49	122
67	571
69	73
69	93
69	109

SEEDING & SODDING	WIDTH AREA
LIN. FT.	Sq. Yds.
68	378
68	383
70	356
58	322
58	322
58	322
58	322
58	308
58	294
58	267
48	

72	118
64	69
28	23
640	371.75
635	
41	52
64	69
28	23

X SECTIONS STA. 10+00 To STA. 14+50