


SEEDING & SODDING	
LENGTH	AREA
Lin. Ft.	Sq. Yds.
41	
38	
34	
10	
55	
10	

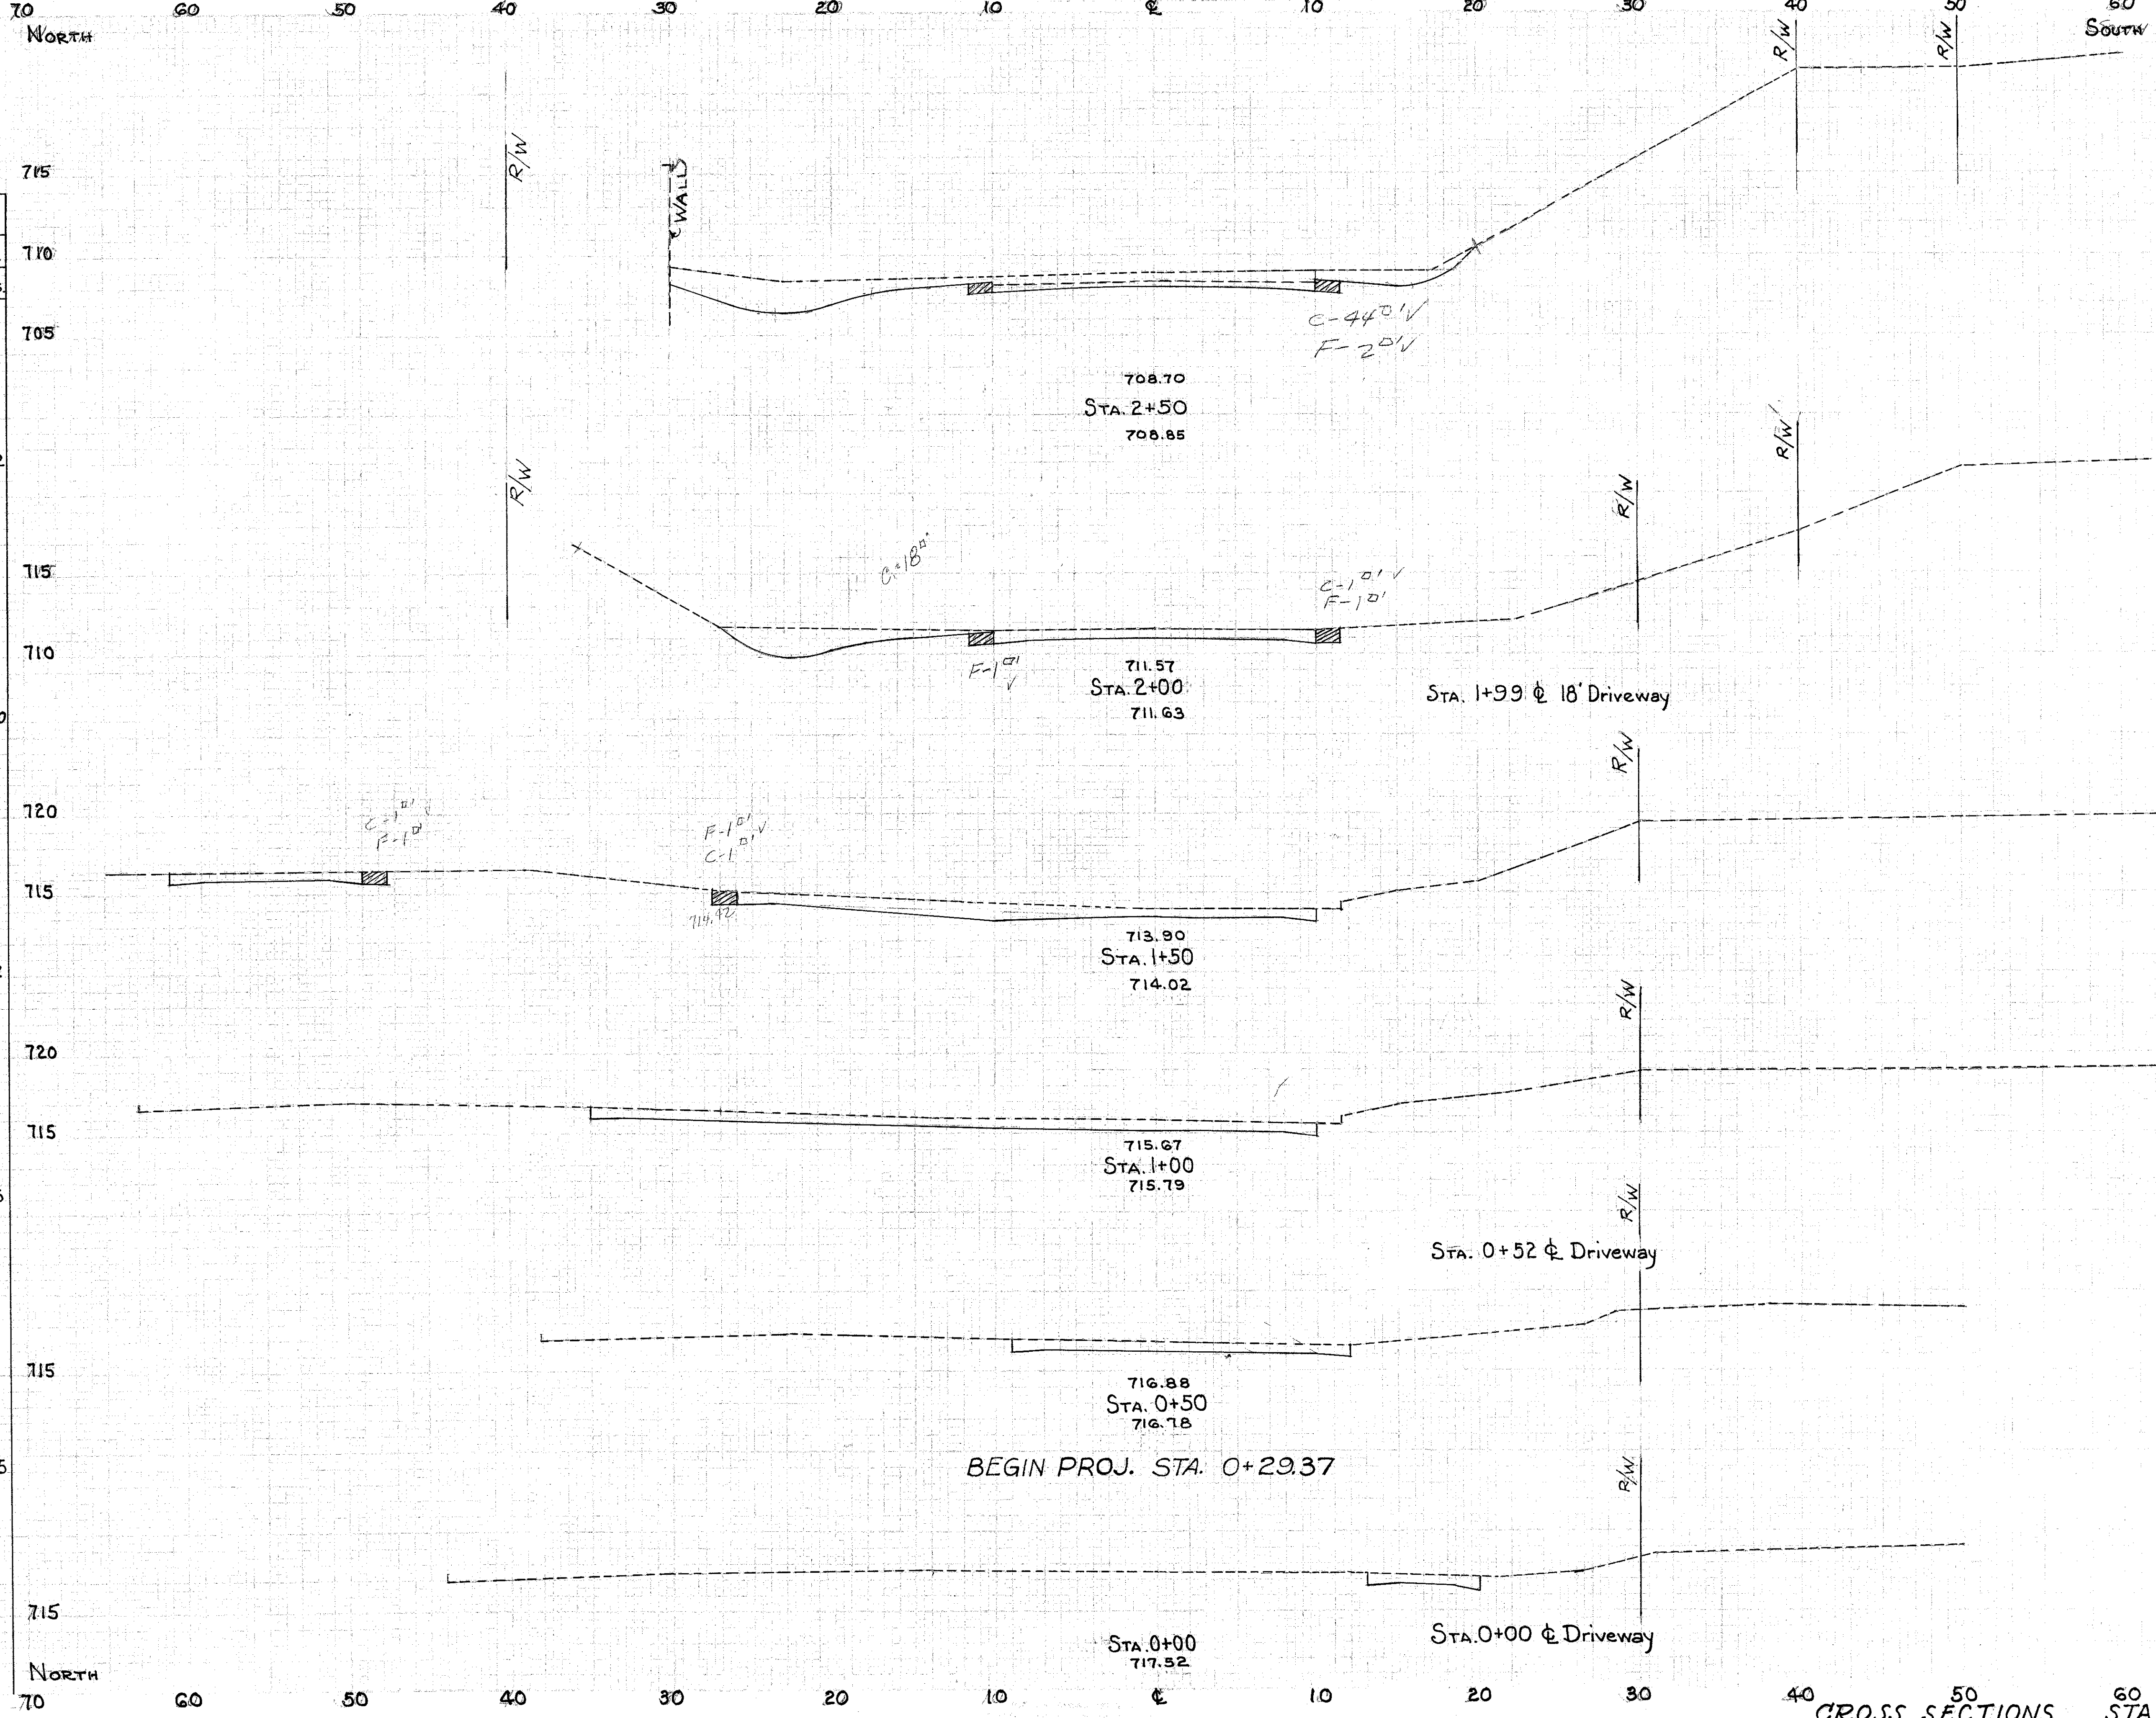

OVER BURDEN EXCAV.		EMBANKMENT	
END AREA	CU. YDS.	END AREA	CU. YDS.
44		2	
58		4	
19		2	
12		4	
2		2	
1		1	
0		0	
0		0	
0		0	
0		0	
0		0	

CROSS SECTIONS STA. 0+00 TO STA. 2+50