


SEEDING & SODDING

LENGTH AREA
 LIN. FT. SQ. YDS.

47	710
119	715
38	710
100	715
33	710
106	715
42	710

SHALE EXCAV.		OVER BURDEN EXCAV.		GRAN. BACKFILL		EMBANKMENT	
END AREA	CU. YDS.	END AREA	CU. YDS.	END AREA	CU. YDS.	END AREA	CU. YDS.

		131	185	41		149	
		0	96	0		10	
			83			2	
				68		2	
				64		2	
			59			2	
			63			2	

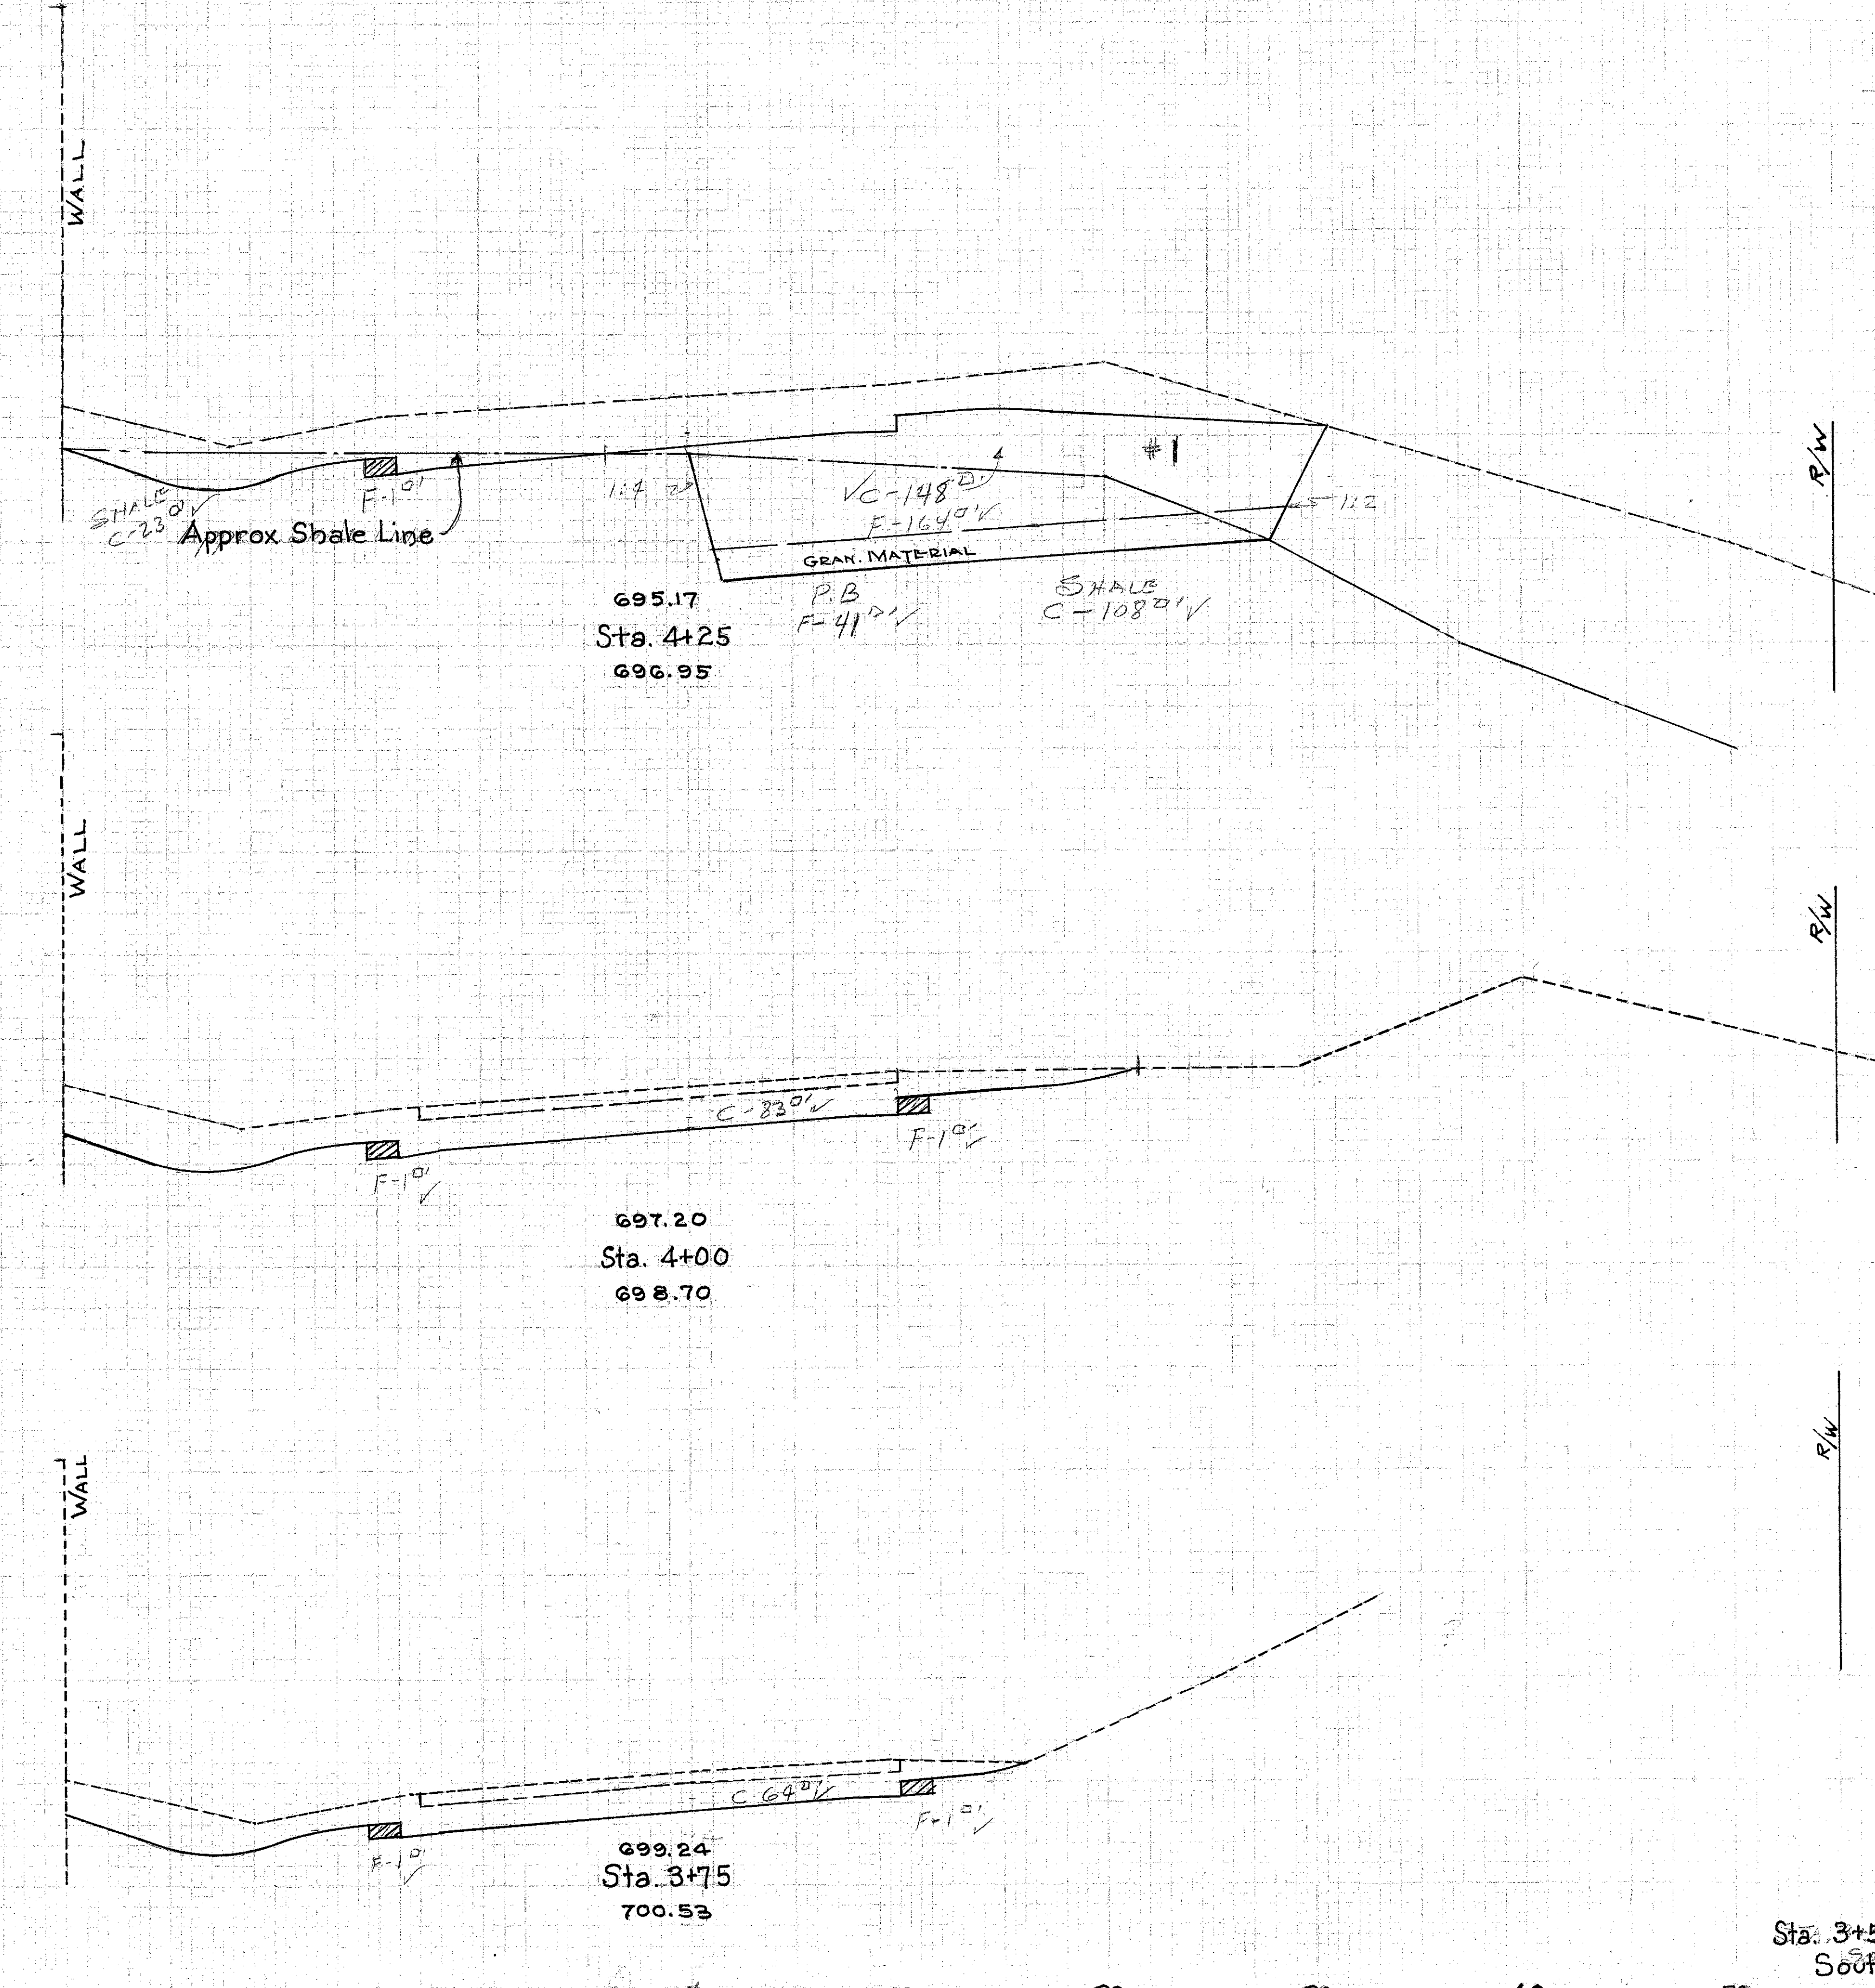

CROSS SECTIONS STA. 3+75 TO STA. 4+25