



CHANGE ORDER
MARCH 22, 1991

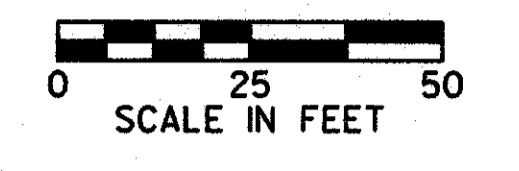

* - DESIGNATES SIGNS TO BE RELOCATED
OR REVISED BY O.D.O.T. FORCES

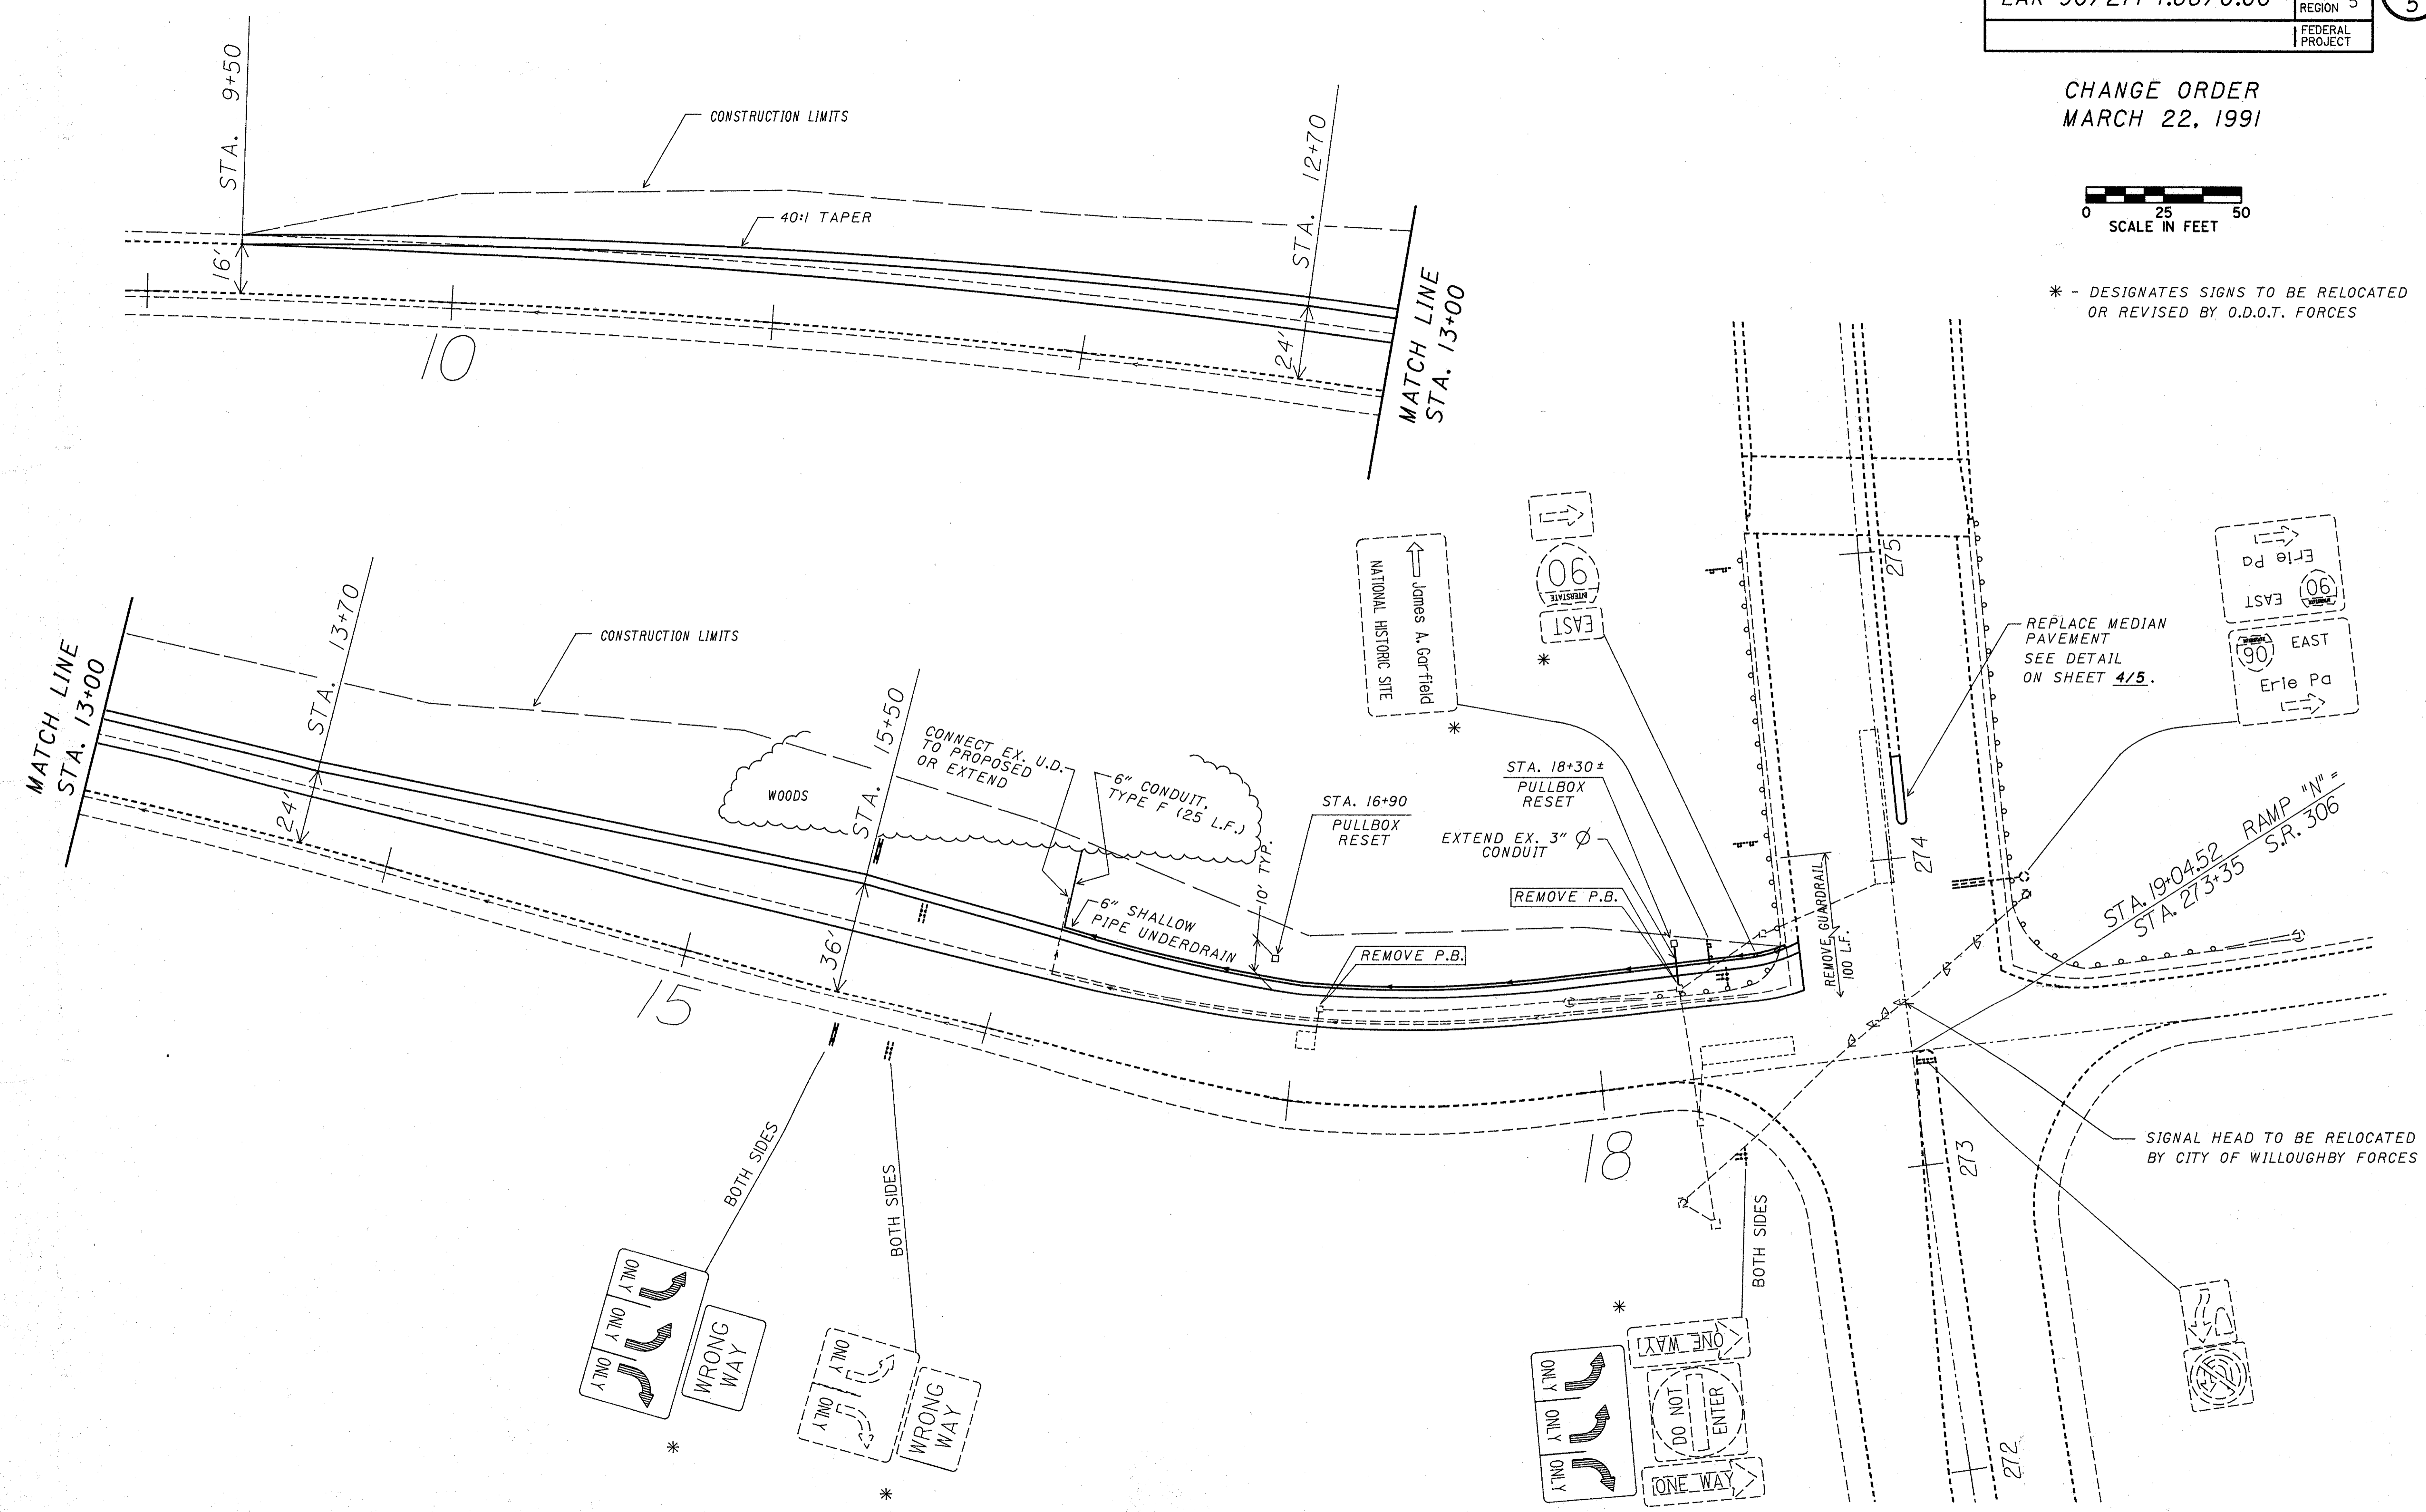

PLOT SUBMITTED BY: KONOPKA
 ZFI: L100, 35010LK90GPVI.DGN
 PLOT SUBMITTED: 22-MAR-1991 15:13