


END AREA		VOLUME		SEEDING	
CUT	FILL	CUT	FILL	END WIDTH	SQ. YDS.
13	60	48	165		
13	29				
		41	106		
					2
9	28				
		84			
39	81				
		19			
		217			
12	16				
		39	54		
		20			
		39			
		54			
		30	35		
		422			
7	6				
5	0	11	6		41

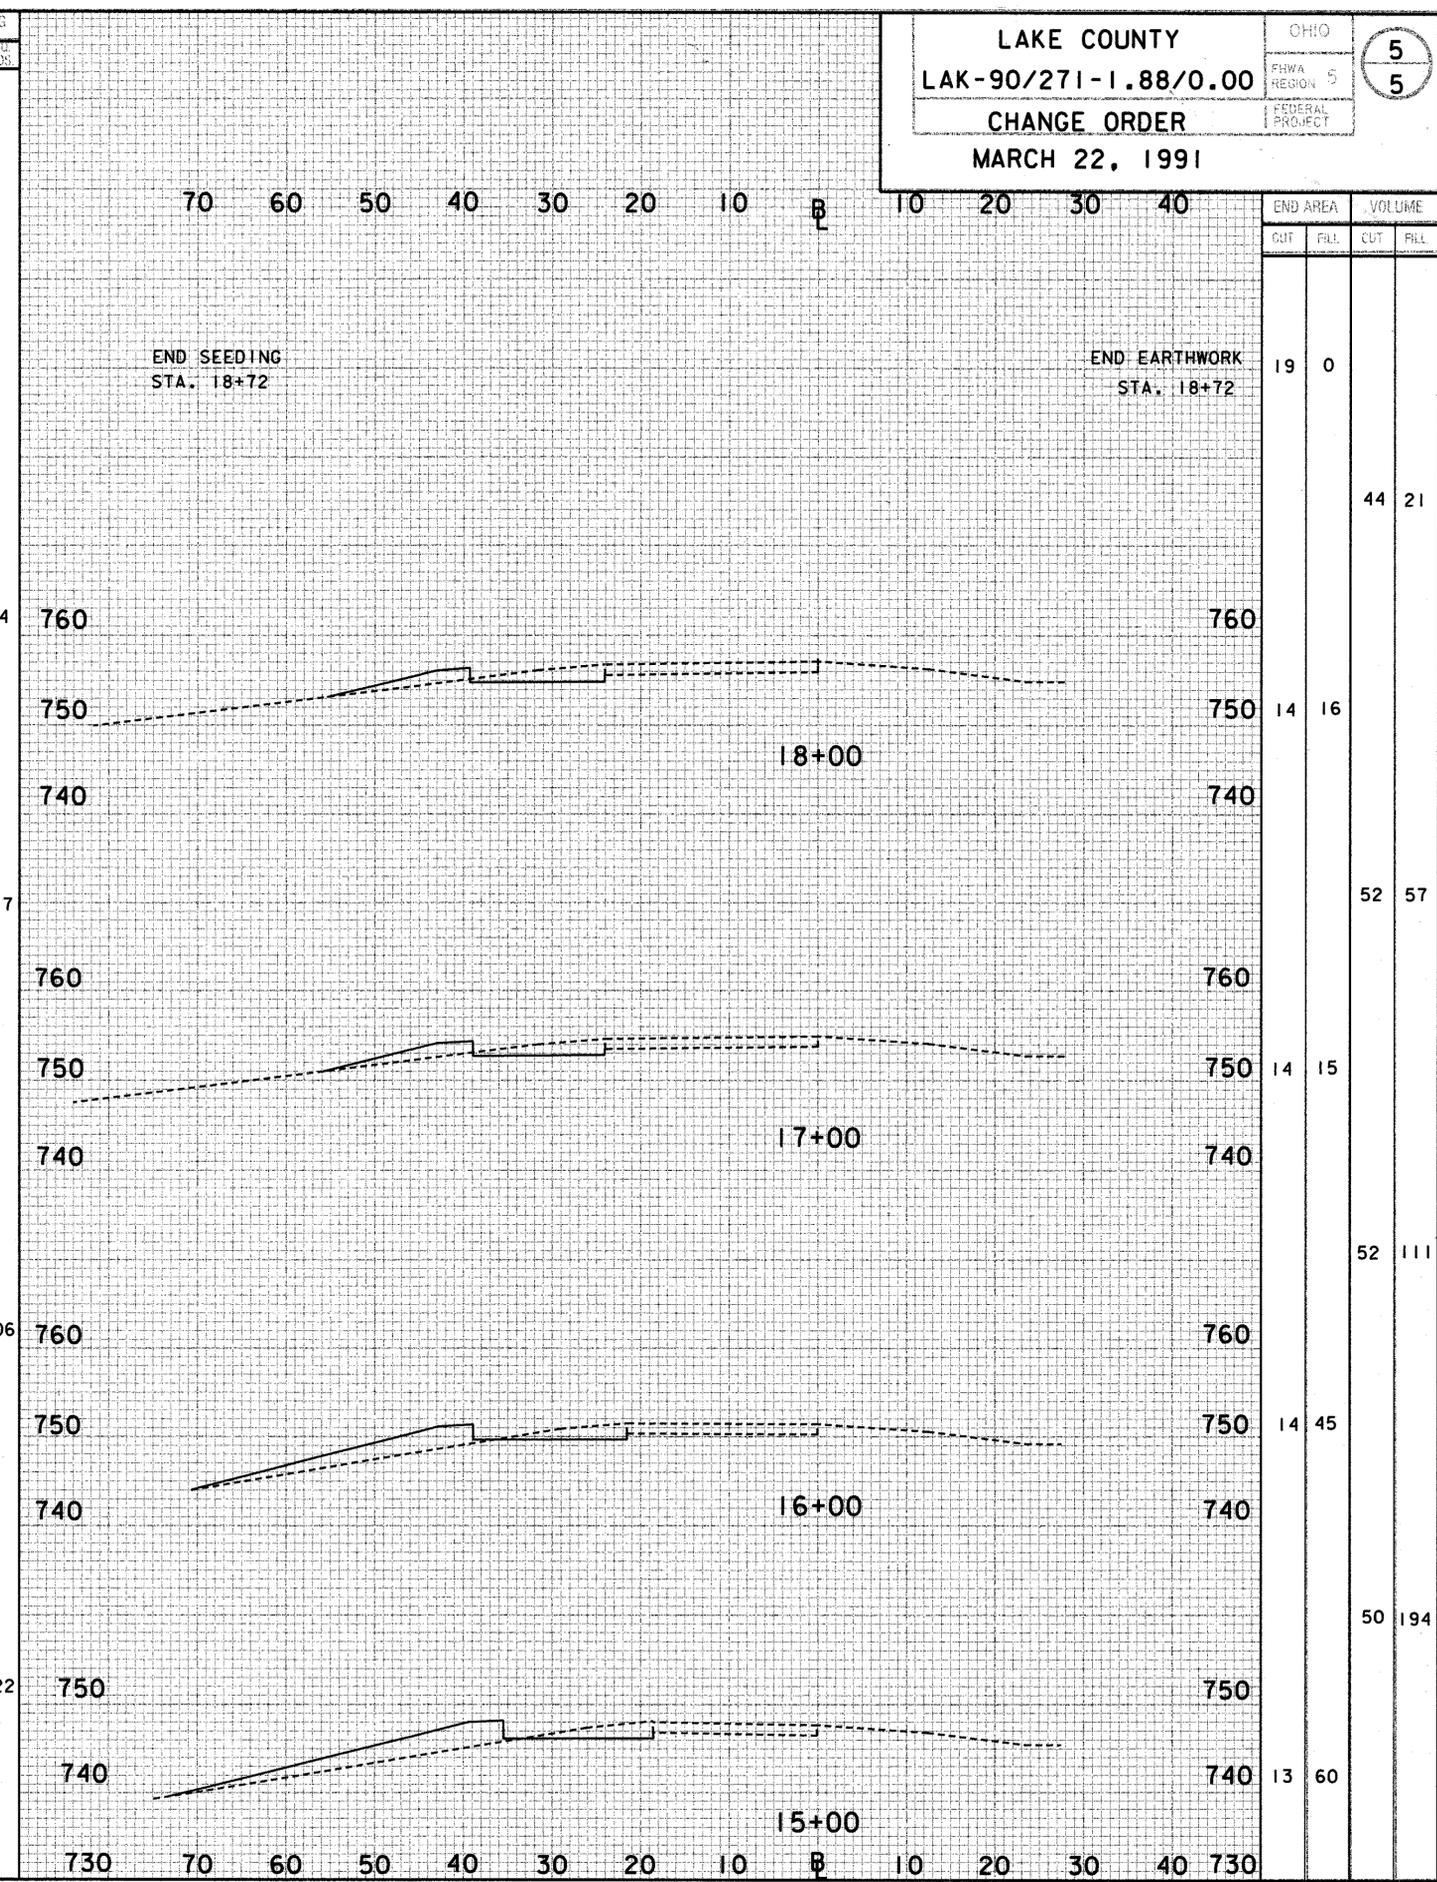

END AREA		VOLUME	
CUT	FILL	CUT	FILL
19	0		
		44	21
14	16		
		52	57
14	15		
		52	111
14	45		
		50	194
13	60		

CROSS SECTIONS, RAMP 'N' STA. 10+00 TO STA. 18+00

ZFH: E100, 350JOLK90SECT.DGN: 22-MAR-1991 13:44