


FED. RD. DIVISION	STATE	PROJECT
2	OHIO	

11
81

LAKE COUNTY
ASHTABULA COUNTY
LAK-1-12.89
ATB-1-0.00

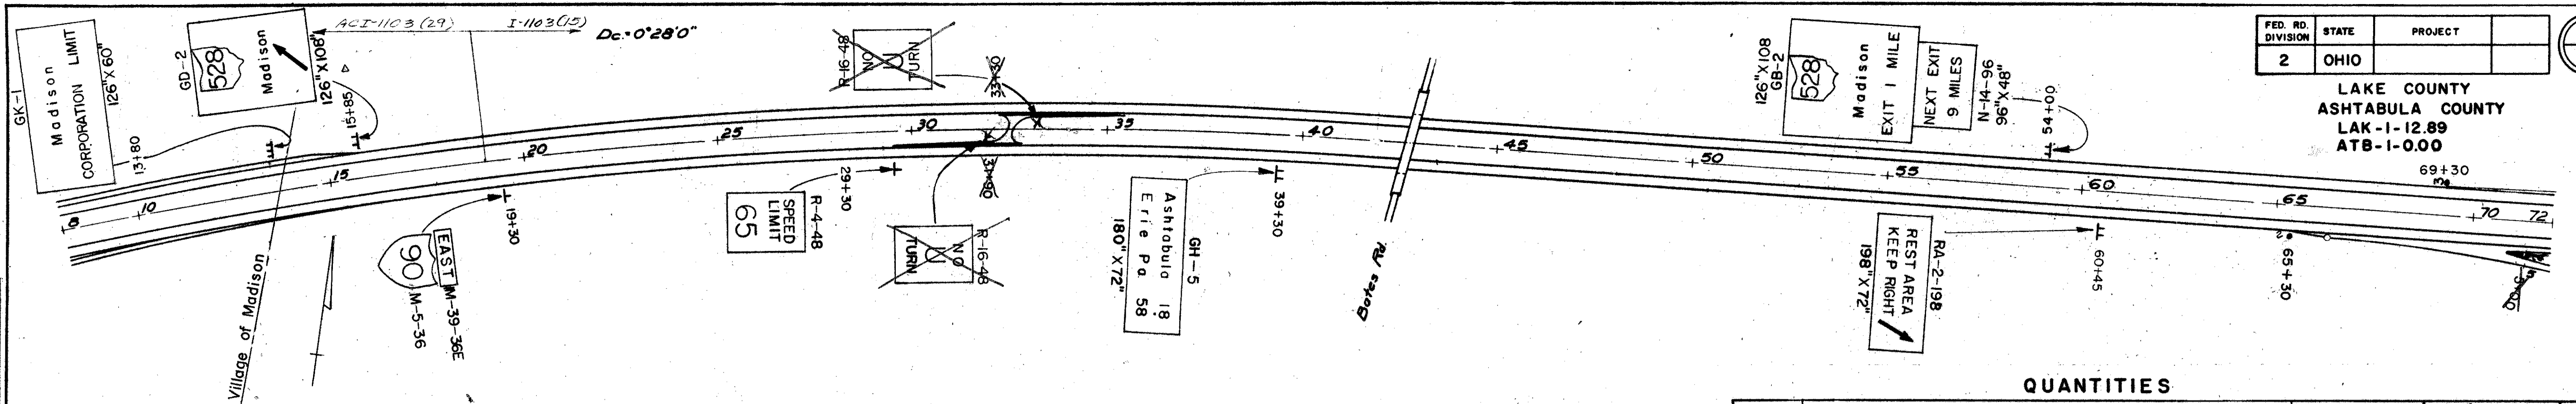


PLAN
SURVEYED BY: _____ DATE: _____
NOTE BOOK NO. _____
ALIGNED CHECKED BY: _____
RT. OF WAY CHECKED BY: _____

STATION	DELINEATOR QUANTITIES			
	POST MTD.	BRACKET MTD.		
	C-2	C-3	C-2	C-3
	EA	EA	EA	EA
13+80	2			
15+85				
39+30				
54+00				
60+45				
111+00				
118+00				
1+50				

DELINEATOR LOCATION			
RAMP	FROM	TO	POST MTD.
			C-2(*2) C-3(*3)
A	65+30	8+00	X 11
B	0+00	9+00	X 21
	3+70	100+60	X 21
C	106+90	12+00	X 12
	11+00	15+60	X 12
D	19+50	18+50	X 21
	18+00	69+30	X 21
	68+30		

STATION	CODE NUMBER AND SIZE												SUPPORTS		1.12" D.P. BRC.				
	R-69-60 60 X 48	GD-2 126 X 108	GH-5 180 X 72	GB-2 126 X 108	N-14-96 96 X 48	RA-2-198 198 X 72	GI-1 138 X 78	GI-2 90 X 78	GK-1 126 X 60	M-5-36 36 X 36	IM-39-36E 36 X 18	R-4-48 48 X 60	W-49-48 48 X 48	# BEAM	10B17	12B22	PCS.	TOT.	CONC.
	EA	EA	EA	EA	EA	EA	EA	EA	EA	EA	EA	EA	EA	FT.	FT.	FT.	EA.-FT.	FT.	CU. YDS
13+80														18.0					48
15+85																23.5			2.8
39+30																20.5			2.8
54+00																25.5			2.54
60+45																20.5			2.8
111+00																20.5			2.8
118+00																20.0			4.8
1+50																22.0			4.8

PROFILE
SURVEYED BY: _____ DATE: _____
NOTE BOOK NO. _____
GRADES CHECKED BY: _____
B. M. NOTED BY: _____
STRUCTURE NOTATIONS CHKD BY: _____

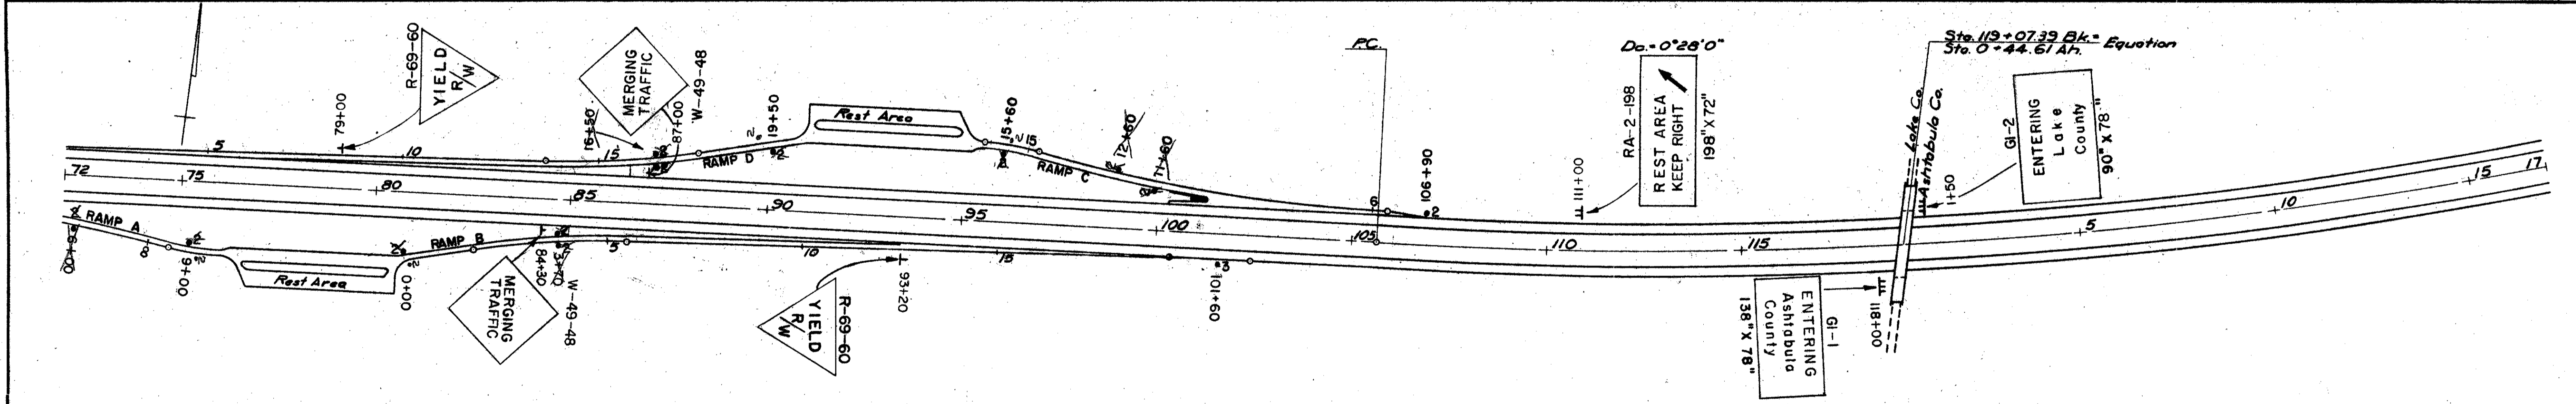

STATION	GRADES	STRUCTURE NOTATIONS
19+30		
29+30		
39+30		
79+00		
87+00		
84+30		
93+20		
TOTALS	2	1

STATION	BEAM	10B17	12B22	PCS.	TOT.	CONC.
19+30	18.0			4 @ 1.83	7.32	.16
29+30	18.5			2 @ 3.33	6.66	.16
39+30	18.5			2 @ 3.33	6.66	.16
79+00	17.5			1 @ 1.66 1 @ 4.16	5.82	.16
87+00	17.5			2 @ 2.66	5.32	.16
84+30	17.5			2 @ 2.66	5.32	.16
93+20	17.5			1 @ 1.66 1 @ 4.16	5.82	.16
TOTALS	2	1	1	178.0	53.0	1.66