


LAKE COUNTY
ASHTABULA COUNTY
LAK-1-12.89
ATB-1-0.00


$D_c = 0^\circ 28' 0''$

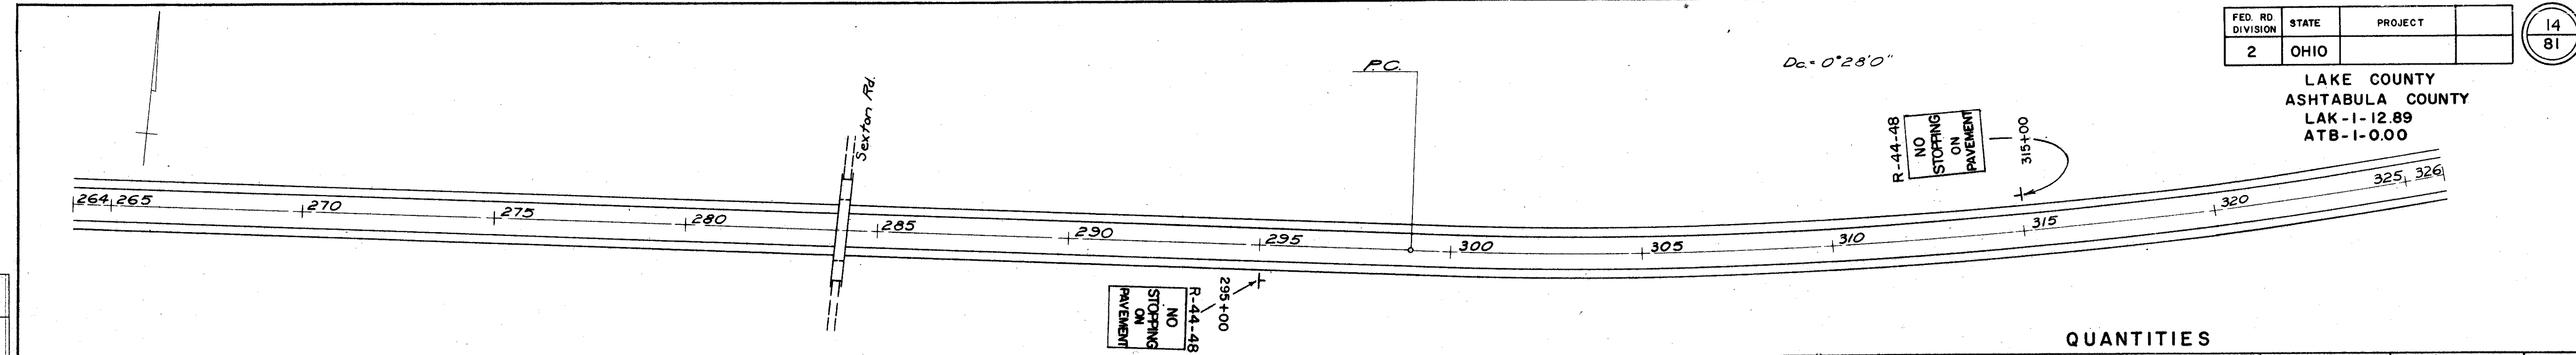

PLAN
SURVEYED
NOTE BOOK
ALIGNMENT CHECKED
RT. OF WAY CHECKED
NO. _____
BY _____
DATE _____

QUANTITIES

STATION	CODE NUMBER AND SIZE							SUPPORTS			1.12* D.P. BRC.												
	GB-4 120 X 108		N-14-96 96 X 48		GH-8 192 X 72		R-16-48 48 X 60		R-44-48 48 X 60		R-42-48 48 X 60		R-32-48 48 X 60		# BEAM	10B17	12B22	PCS.	TOT.	CONC.			
	EA.	EA.	EA.	EA.	EA.	EA.	EA.	EA.	EA.	EA.	EA.	EA.	EA.	EA.							FT.	FT.	FT.
363+00	1	1														25.5	27.5				2.54		
377+00																20.5	22.5				2.18		
295+00															18.5			2 @ 3.33	6.66	16			
315+00															18.5			2 @ 3.33	6.66	16			
379+20							*								18.5			2 @ 3.33	6.66	16			
381+20							*								18.5			2 @ 3.33	6.66	16			
330+00															18.5			2 @ 3.33	6.66	16			
350+00															18.5			2 @ 3.33	6.66	16			
TOTALS	1	1					*	2	1	1					74.0	43.0	53.0				28.64	5.36	
																						39.96	5.68

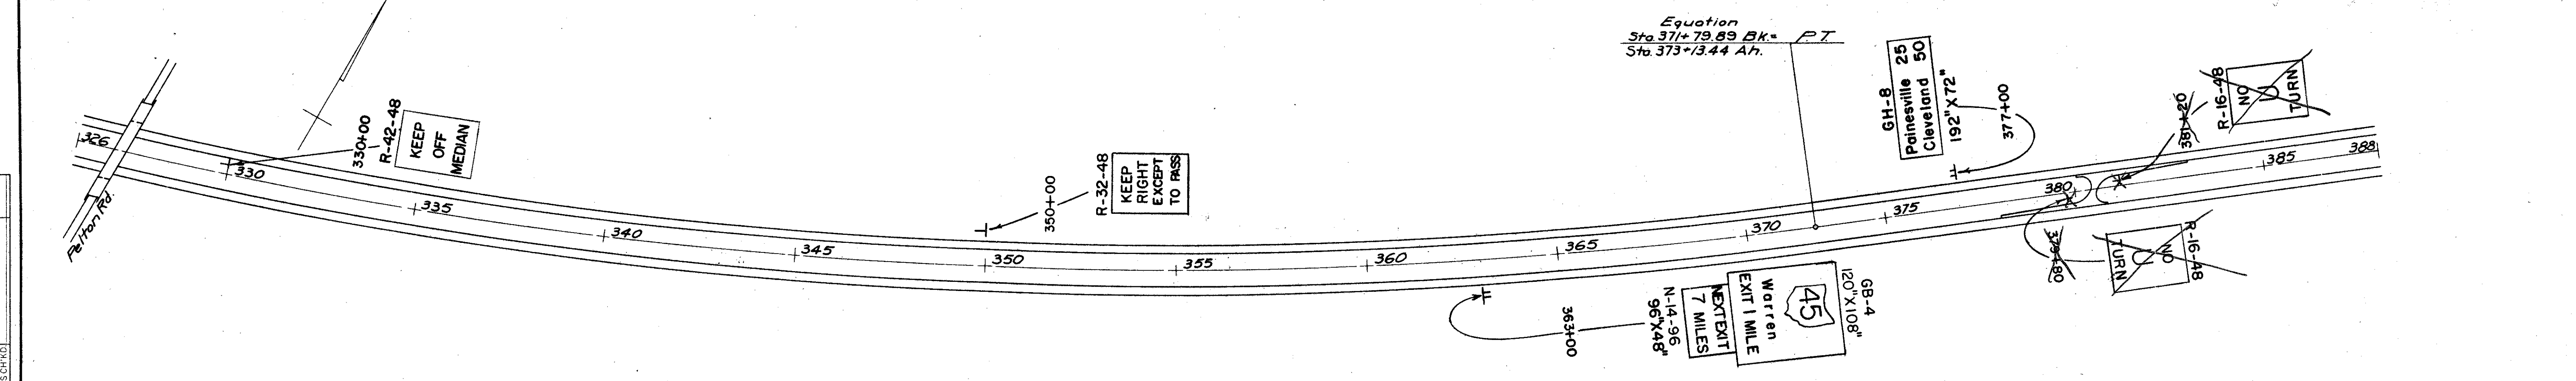

PROFILE
SURVEYED
NOTE BOOK
GRADES CHECKED
B. M. S. NOTED
STRUCTURE NOTATIONS CHECKED
NO. _____
BY _____
DATE _____