


LAKE COUNTY
ASHTABULA COUNTY
LAK-1-12.89
ATB-1-0.00

NOTE: SEE SHEET 26 FOR INTERCHANGE QUANTITIES.

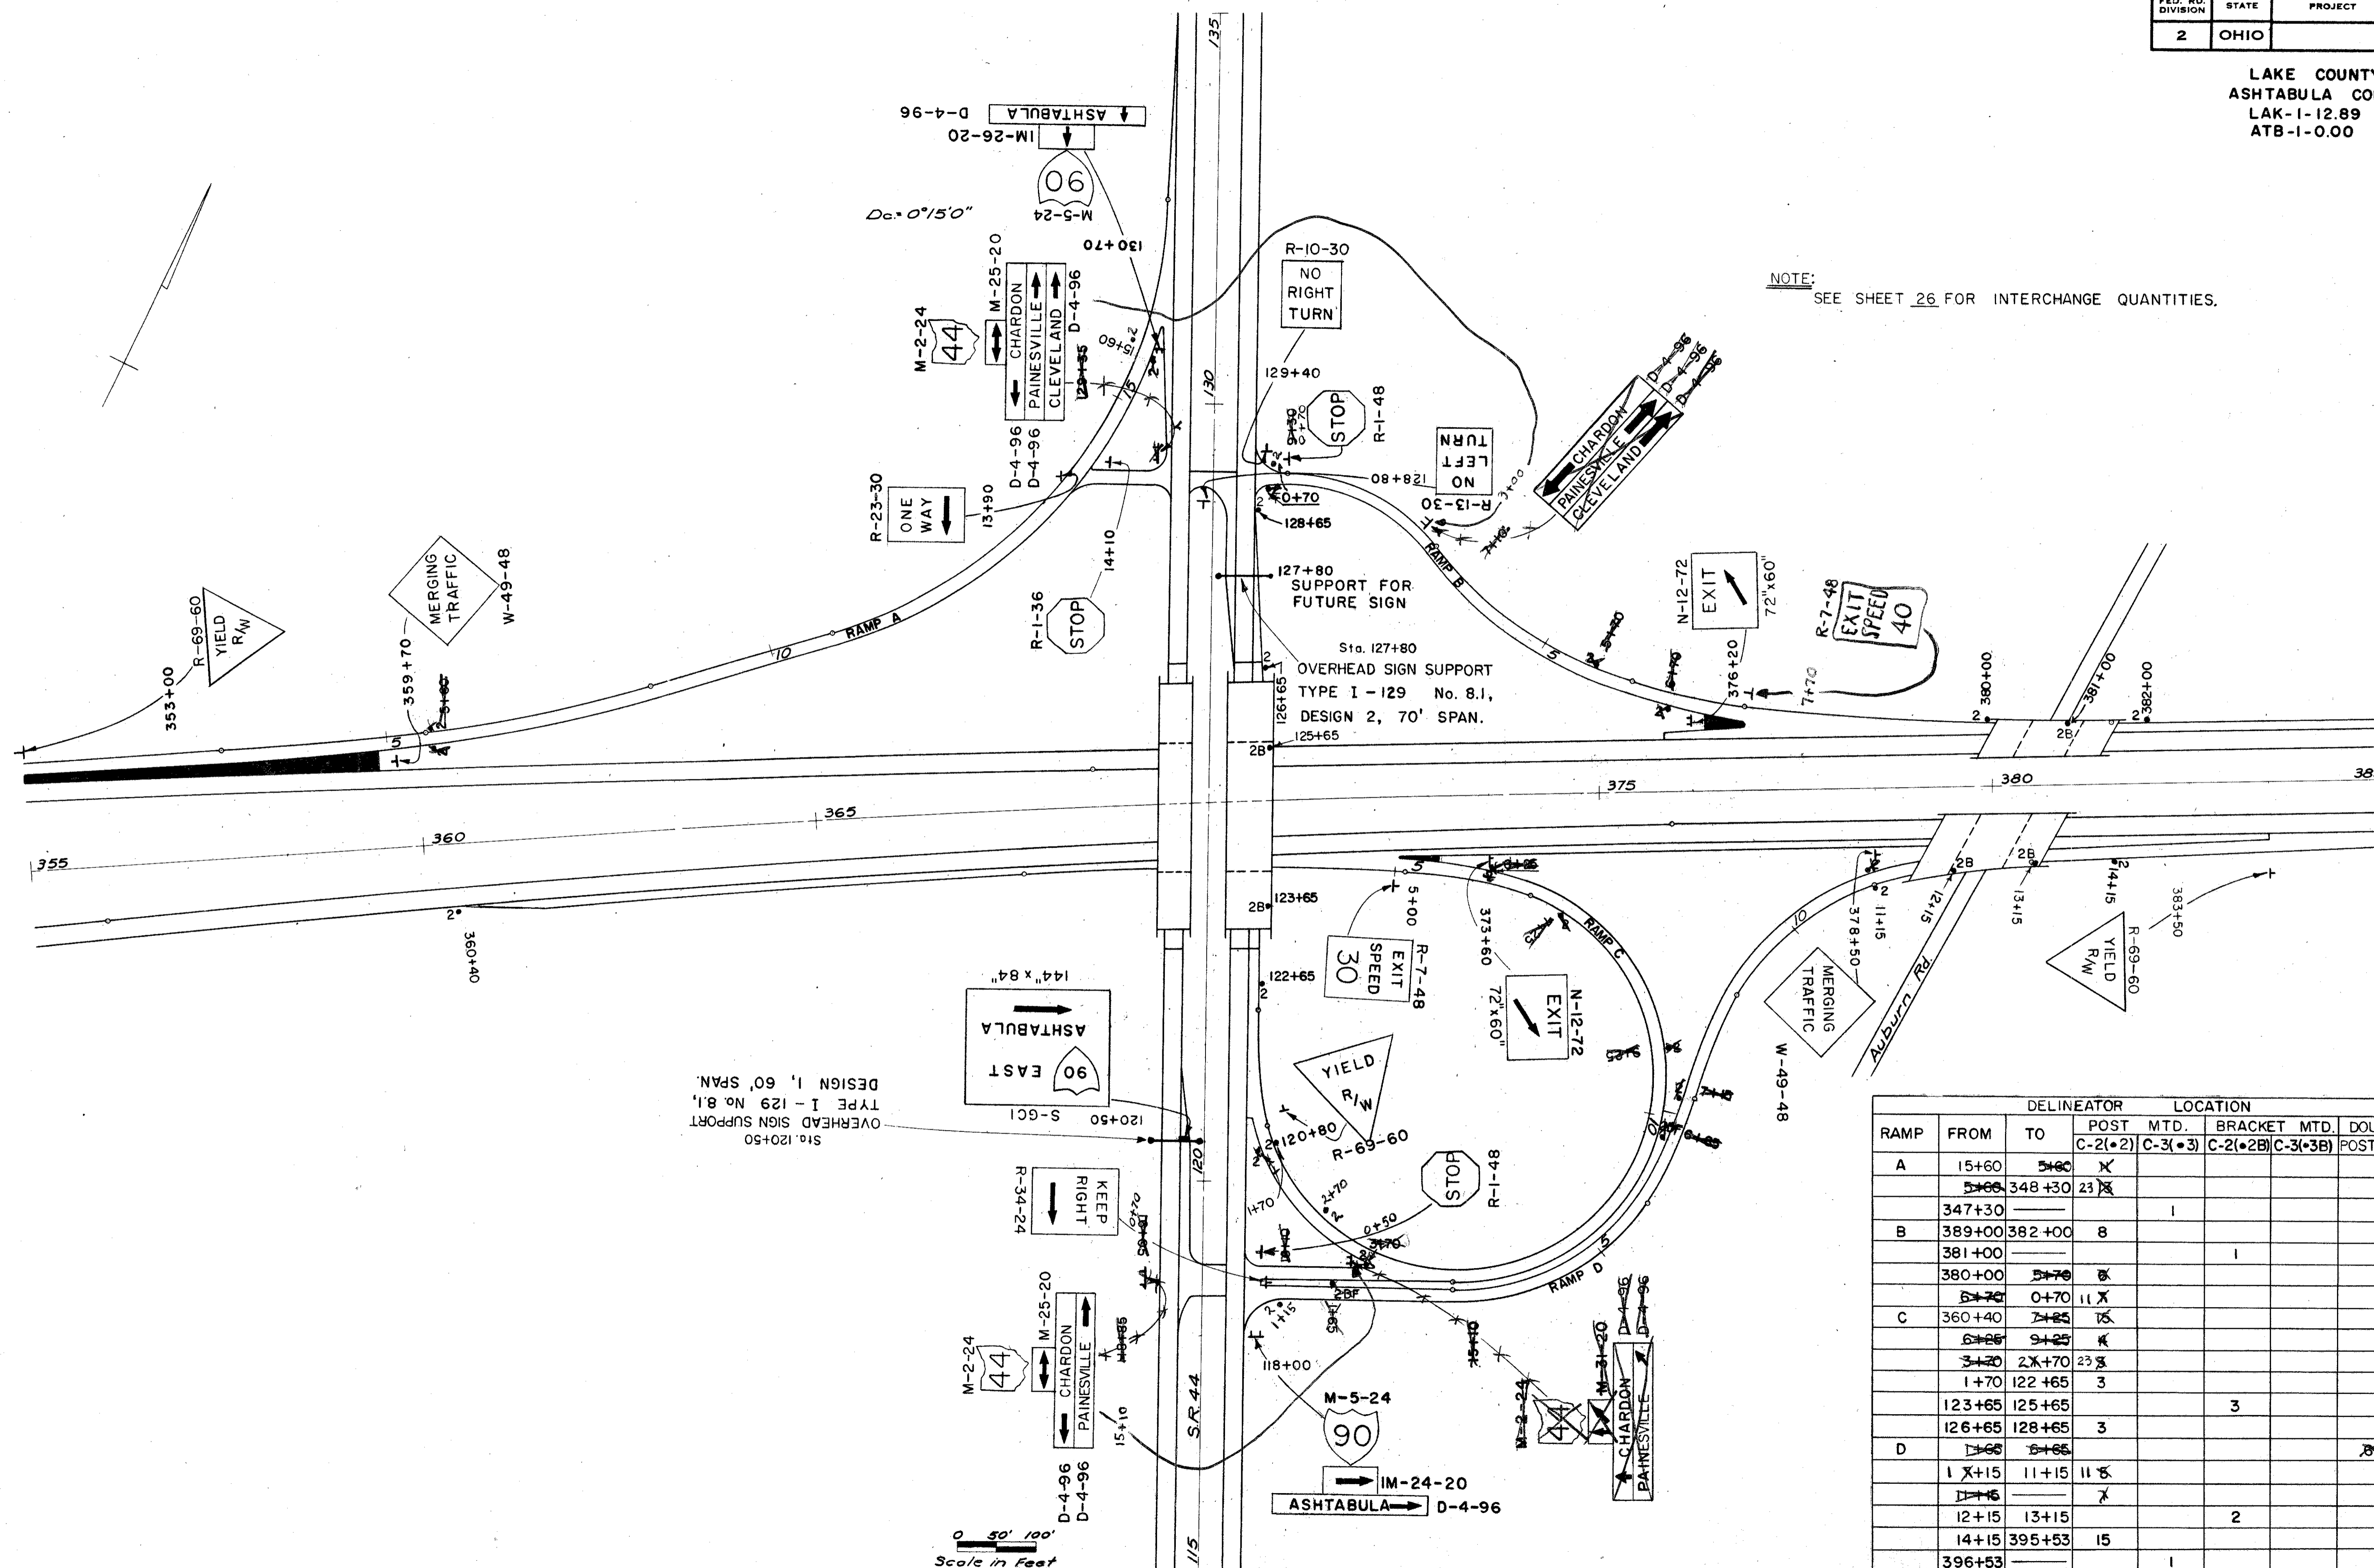

RAMP	FROM	TO	DELINEATOR LOCATION			DOUBLE FACE (C-2)	POST MTD/ERKT. MTD.
			C-2(•2)	C-3(•3)	C-2(•2B) C-3(•3B)		
A	15+60	5+60	X				
	347+30	348+30	23				
B	389+00	382+00	8				
	381+00				1		
C	360+40	0+70	11	X			
	370	2X+70	23	X			
D	1+70	122+65	3				
	123+65	125+65			3		
	126+65	128+65	3				
	11X+15	11+15	11	X			
	12+15	13+15			2		
	14+15	395+53	15				
	396+53				1		