


LAKE COUNTY
ASHTABULA COUNTY
LAK-I-12.89
ATB-I-0.00

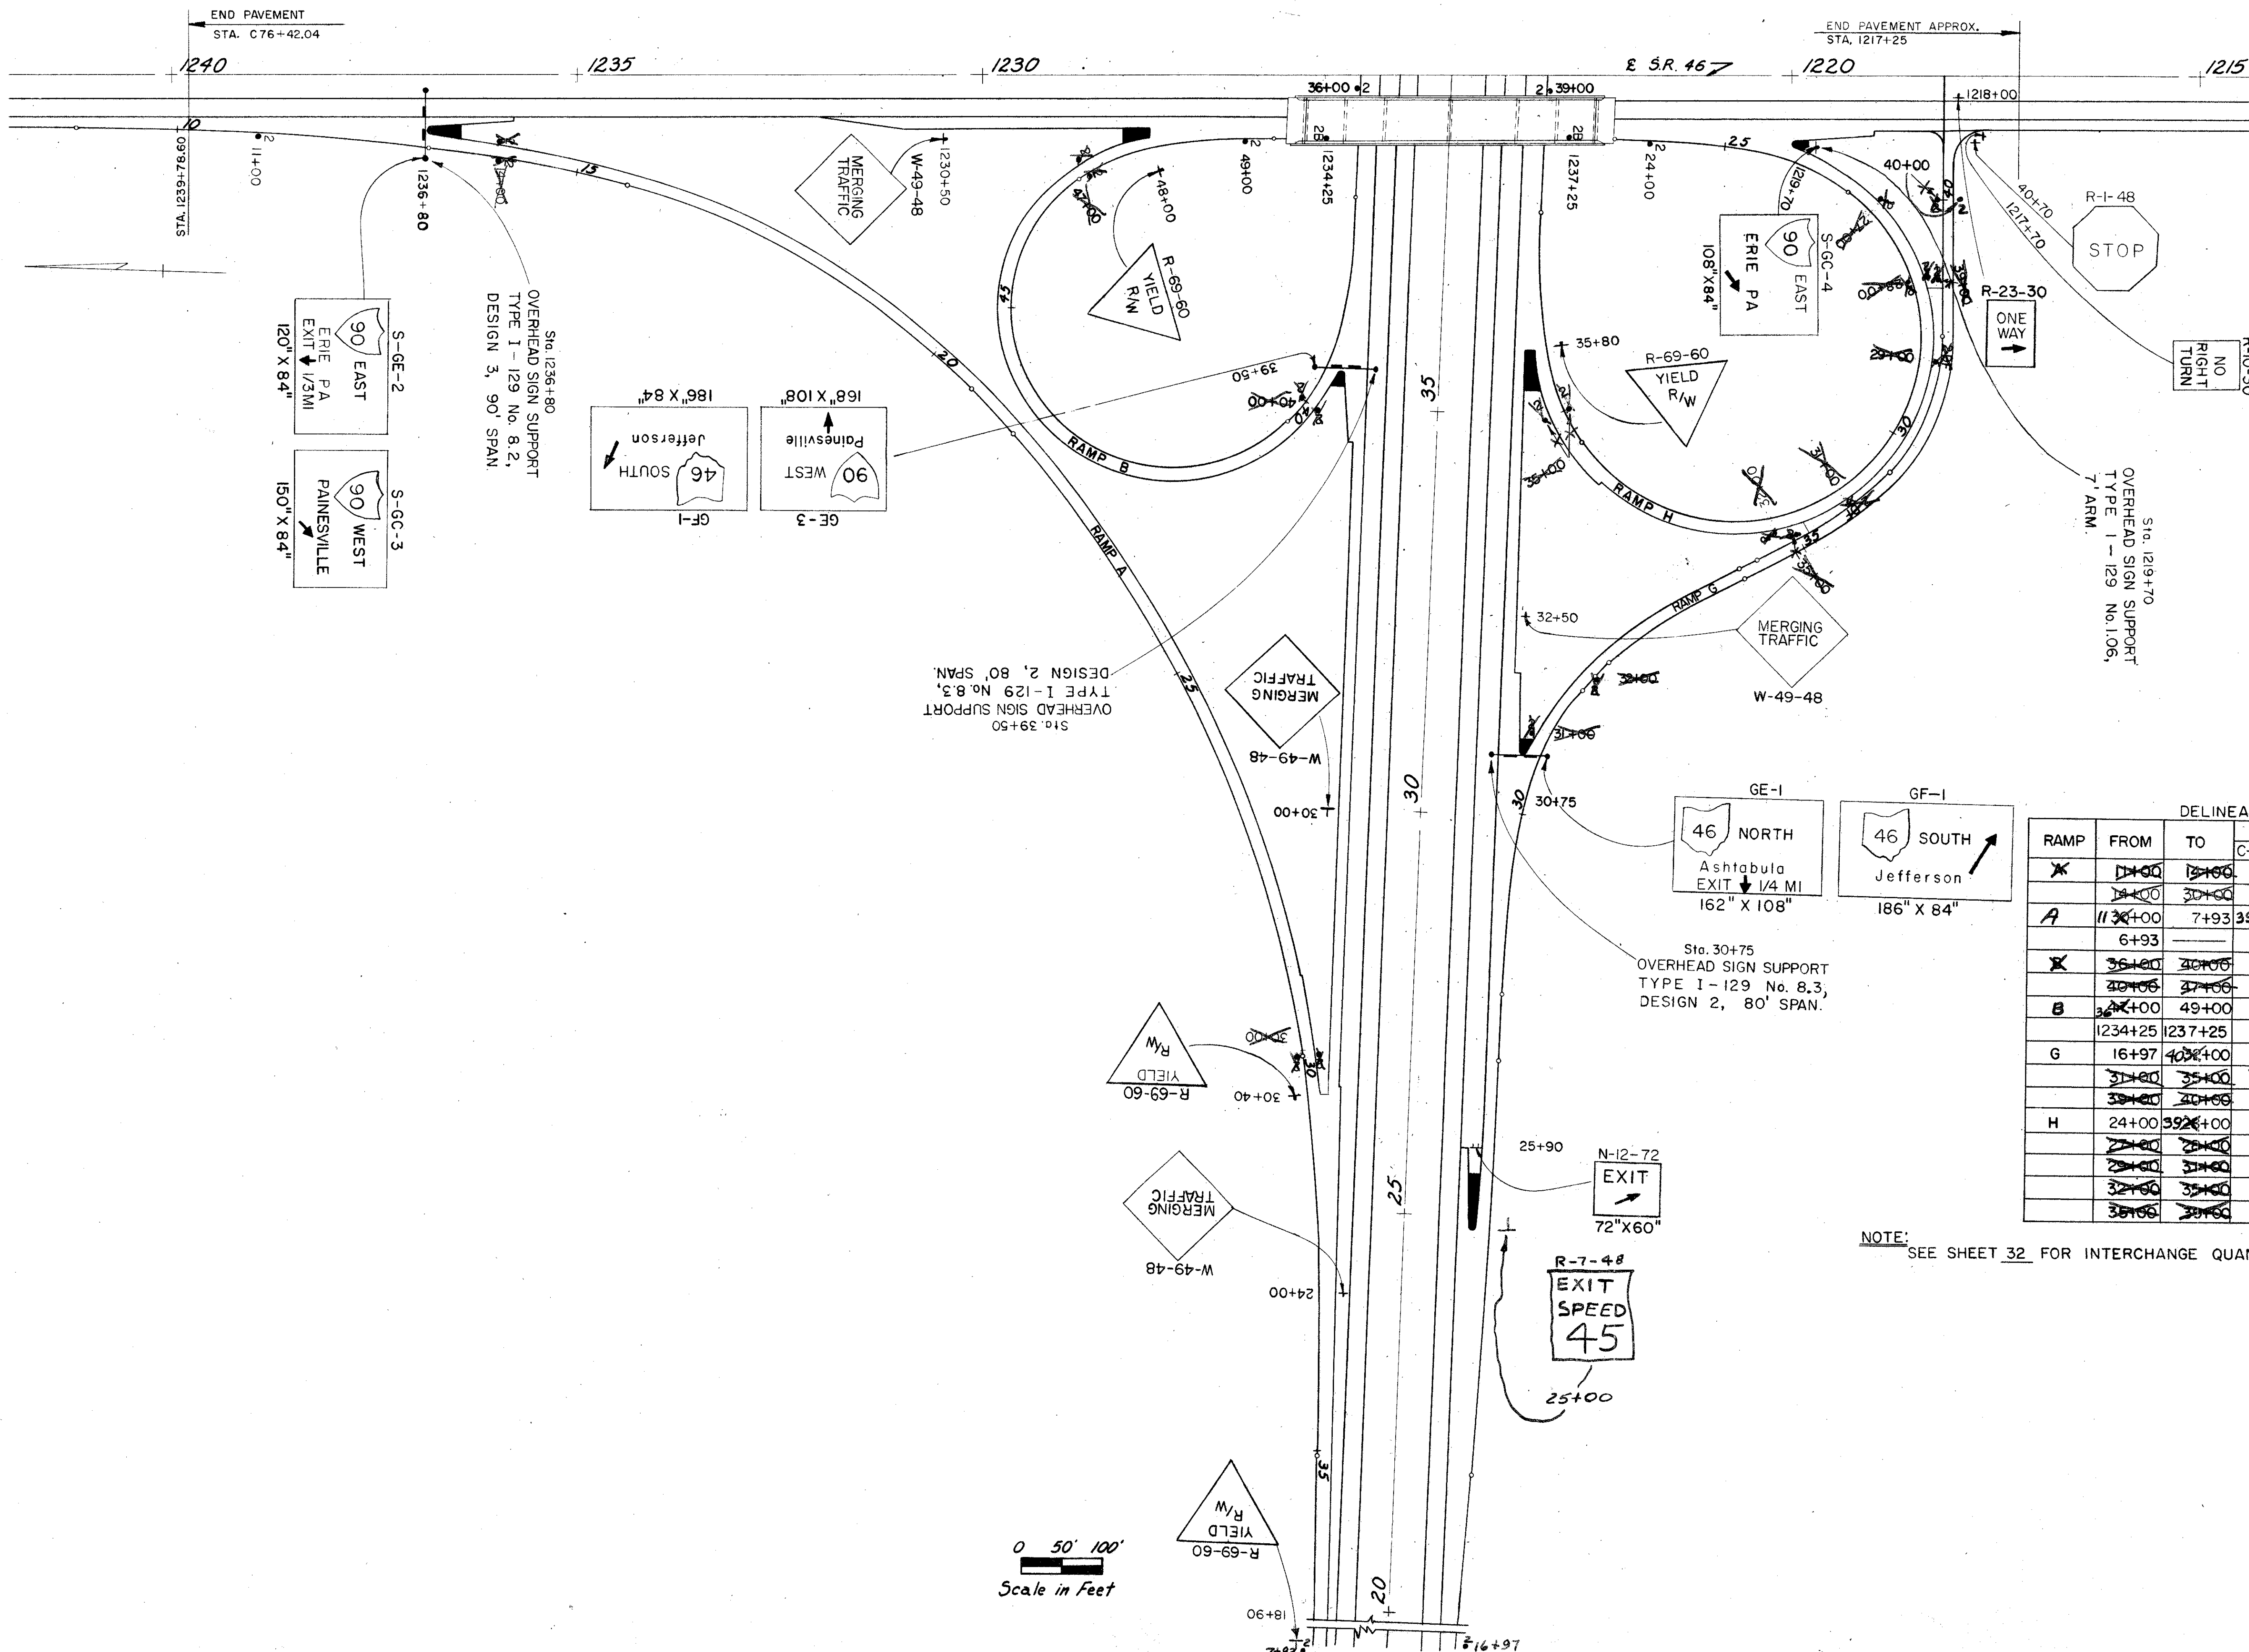

RAMP	FROM	TO	DELINEATOR LOCATION				DOUBLE FACE (C-2)
			POST MTD. C-2(•2)	C-3(•3)	BRACKET MTD. C-2(•2B)	C-3(•3B)	
X	1234+00	1237+25	X				
A	1134+00	7+93	392				
	6+93			1			
X	30+00	40+00	X				
B	30+00	49+00	X	14			
	1234+25	1237+25			4		
G	16+97	40+00	X	29			

NOTE: SEE SHEET 32 FOR INTERCHANGE QUANTITIES.

