


END PAVEMENT STA. C76+42.04

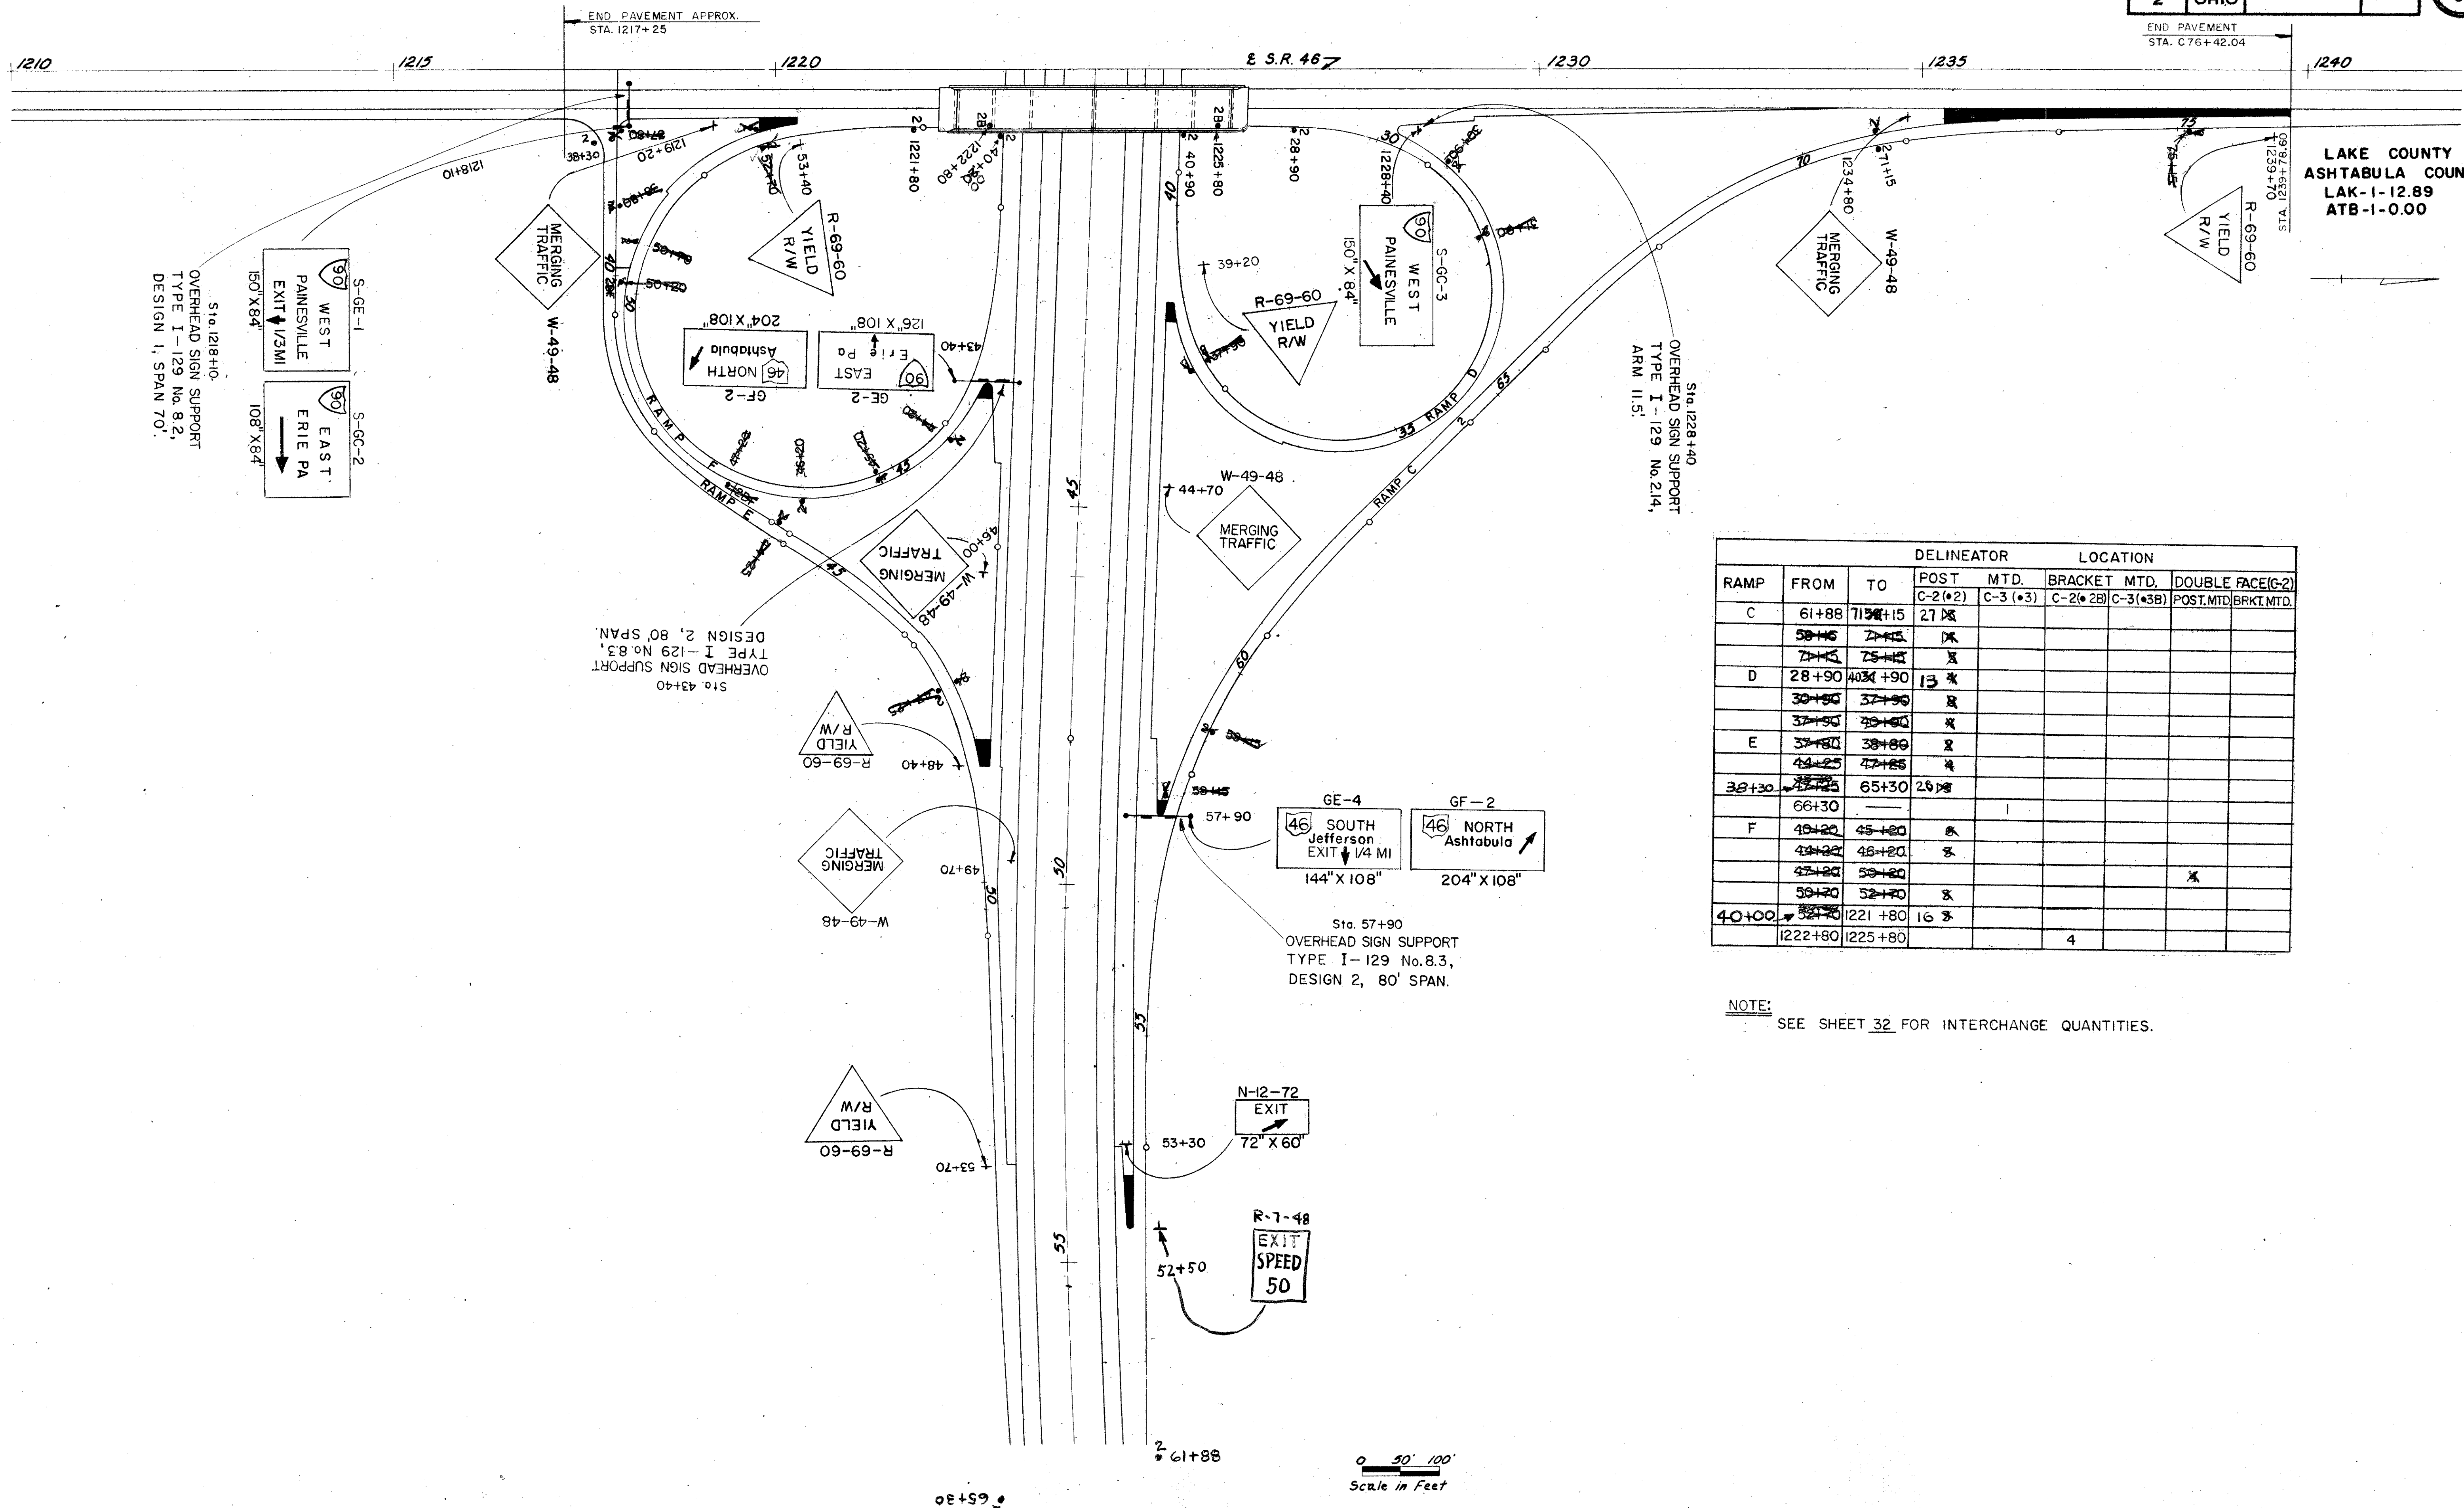

LAKE COUNTY  
ASHTABULA COUNTY  
LAK-1-12.89  
ATB-1-0.00

RAMP	FROM	TO	DELINEATOR LOCATION			
			POST	MTD.	BRACKET	DOUBLE FACE(C-2)
C	61+88	71+15	27	3	2B	3B
40+00	1221+80	1222+80	16			
	1222+80	1225+80			4	

NOTE: SEE SHEET 32 FOR INTERCHANGE QUANTITIES.

