


LAKE COUNTY  
 ASHTABULA COUNTY  
 LAK-1-12.89  
 ATB-1-0.00

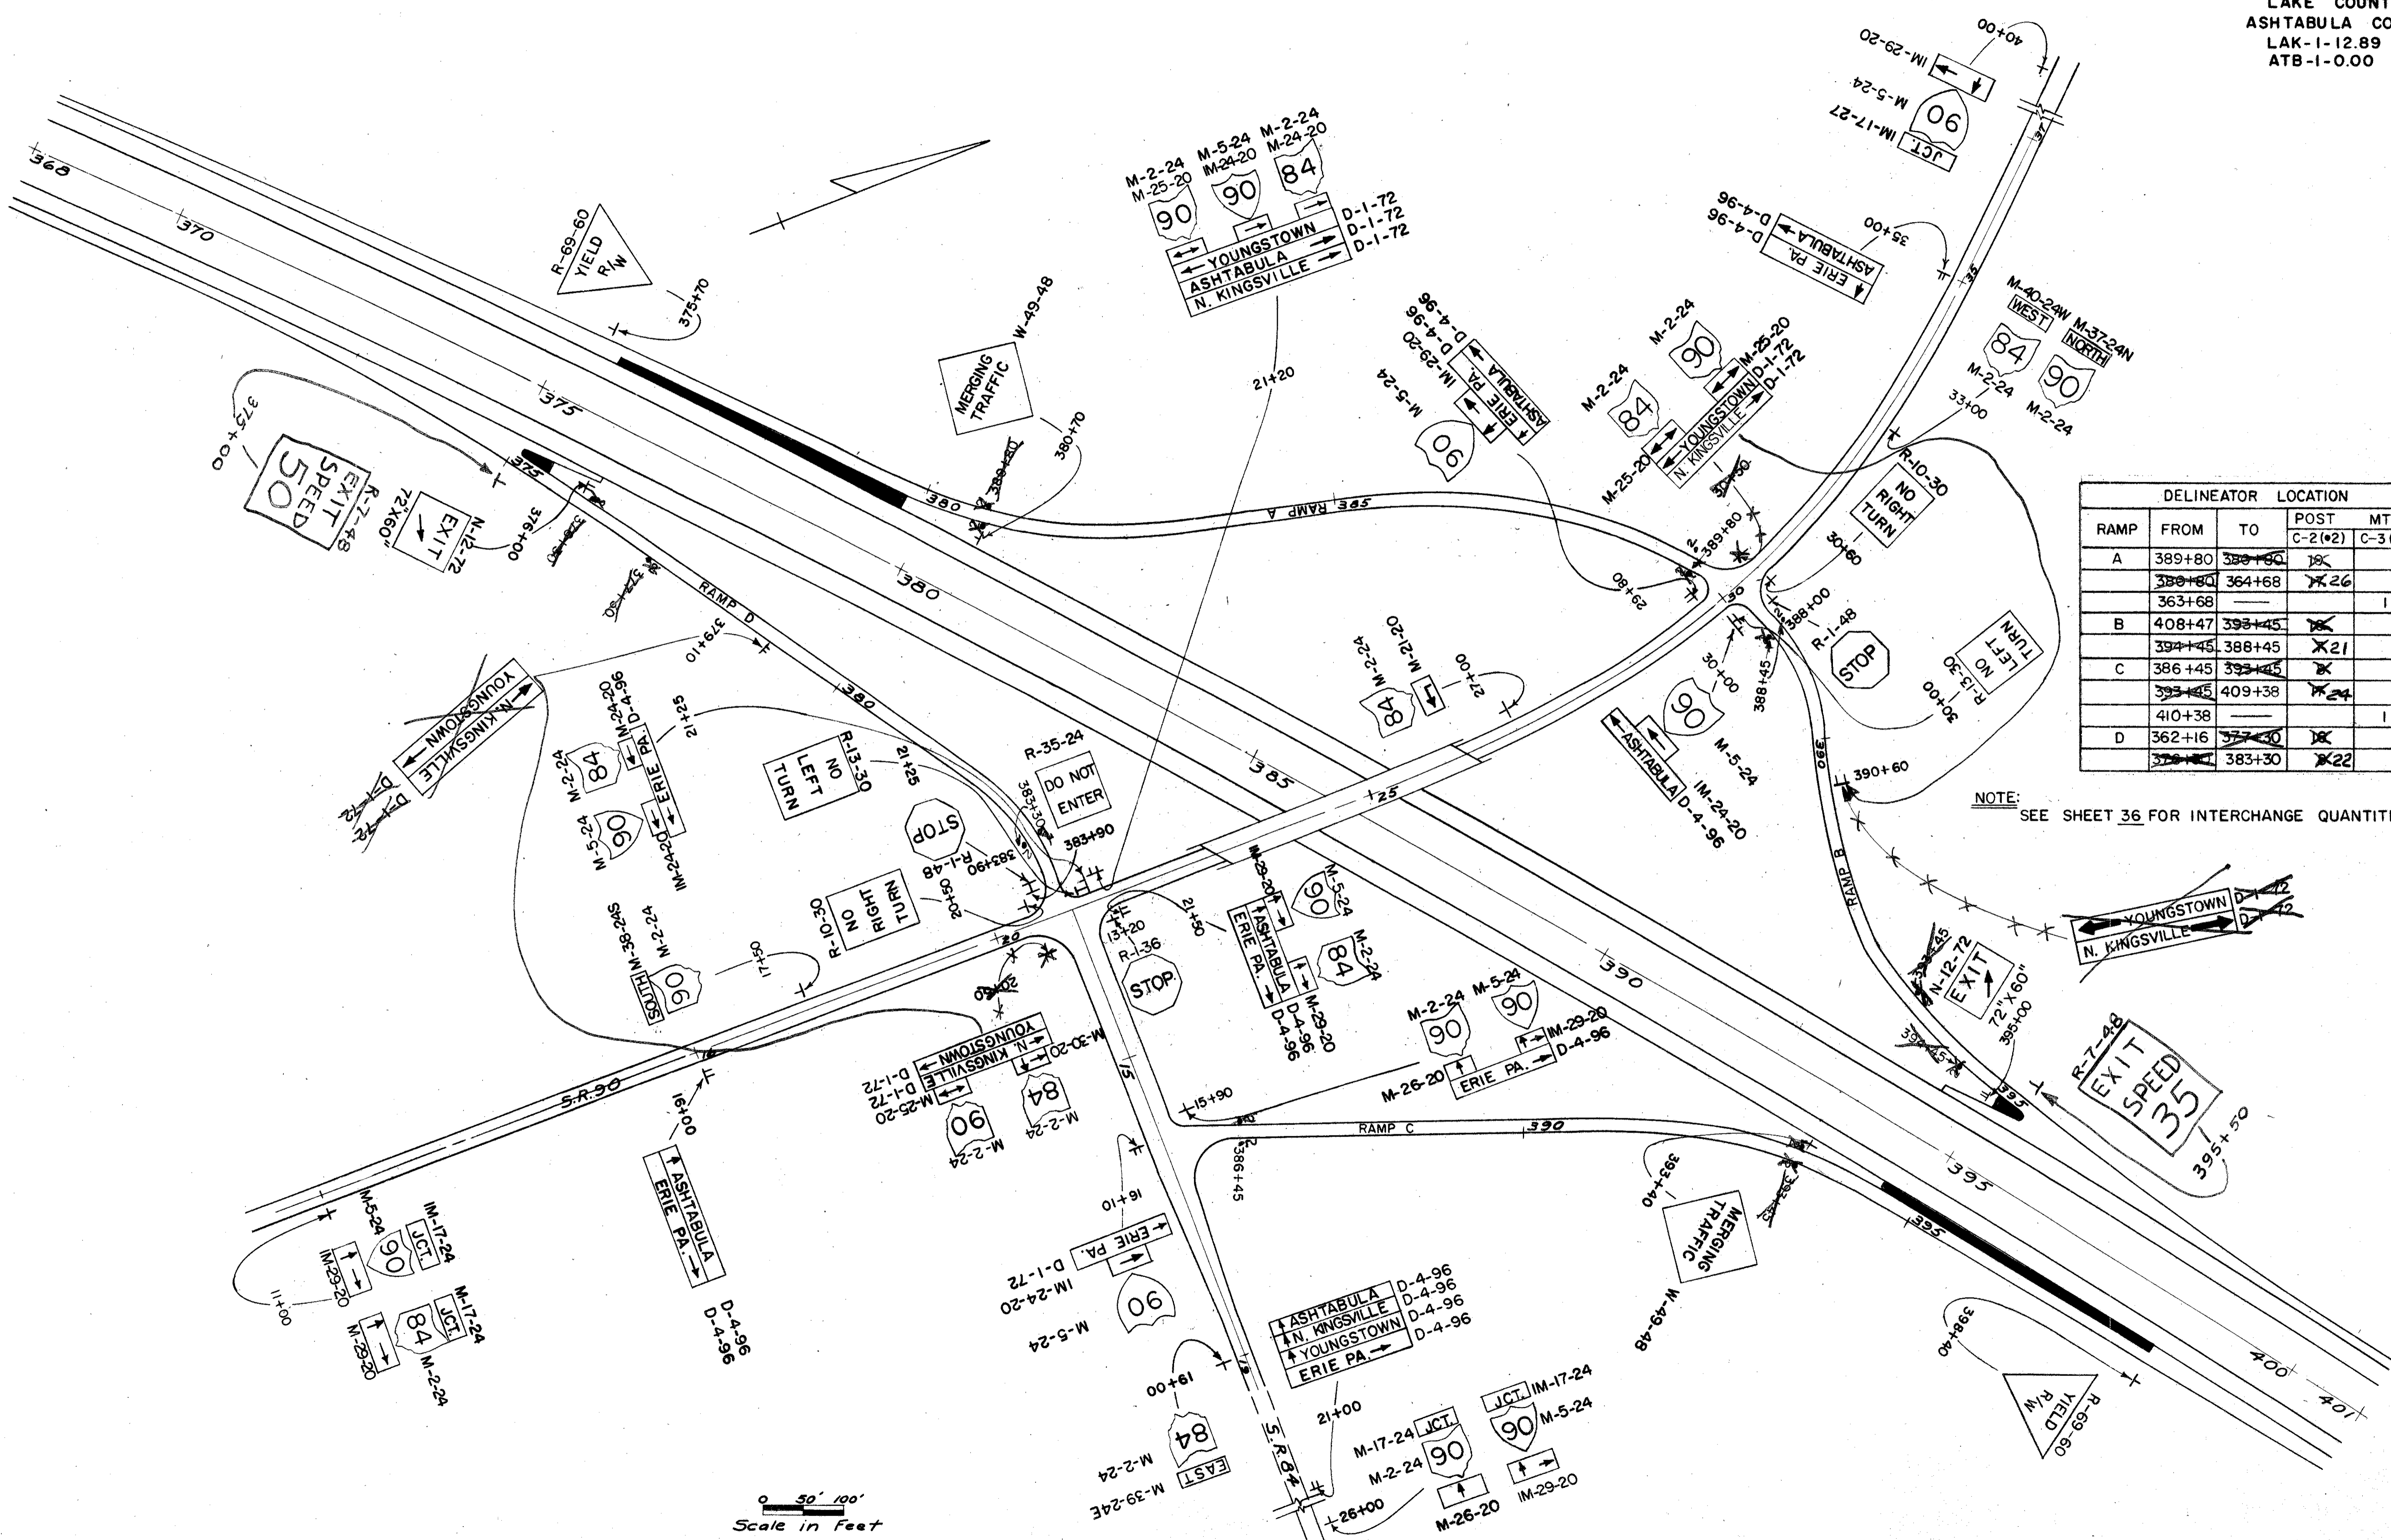

| RAMP | FROM   | TO     | POST    |         |
|------|--------|--------|---------|---------|
|      |        |        | C-2(*2) | C-3(*3) |
| A    | 389+80 | 389+60 | X       |         |
|      | 380+60 | 364+68 | X       | 26      |
|      | 363+68 |        |         | 1       |
| B    | 408+47 | 393+45 | X       |         |
|      | 394+45 | 388+45 | X       | 21      |
|      | 386+45 | 393+45 | X       |         |
| C    | 393+45 | 409+38 | X       |         |
|      | 410+38 |        |         | 1       |
|      | 362+16 | 377+00 | X       |         |
| D    |        | 383+30 | X       | 22      |

NOTE: SEE SHEET 36 FOR INTERCHANGE QUANTITIES.

0 50' 100'  
 Scale in Feet

REV. 2-11-60

S.R. 90 INTERCHANGE