


RAMP	DELINEATOR LOCATION		POST	MTD.
	FROM	TO		
C	689+00	698+00	16	
	698+00	714+00	26	
D	715+00	---	1	
	668+50	682+50	15	
	681+50	689+50	22	

LAKE COUNTY  
ASHTABULA COUNTY  
LAK-1-12.89  
ATB-1-0.00

NOTE: SEE SHEET 36 FOR INTERCHANGE QUANTITIES.

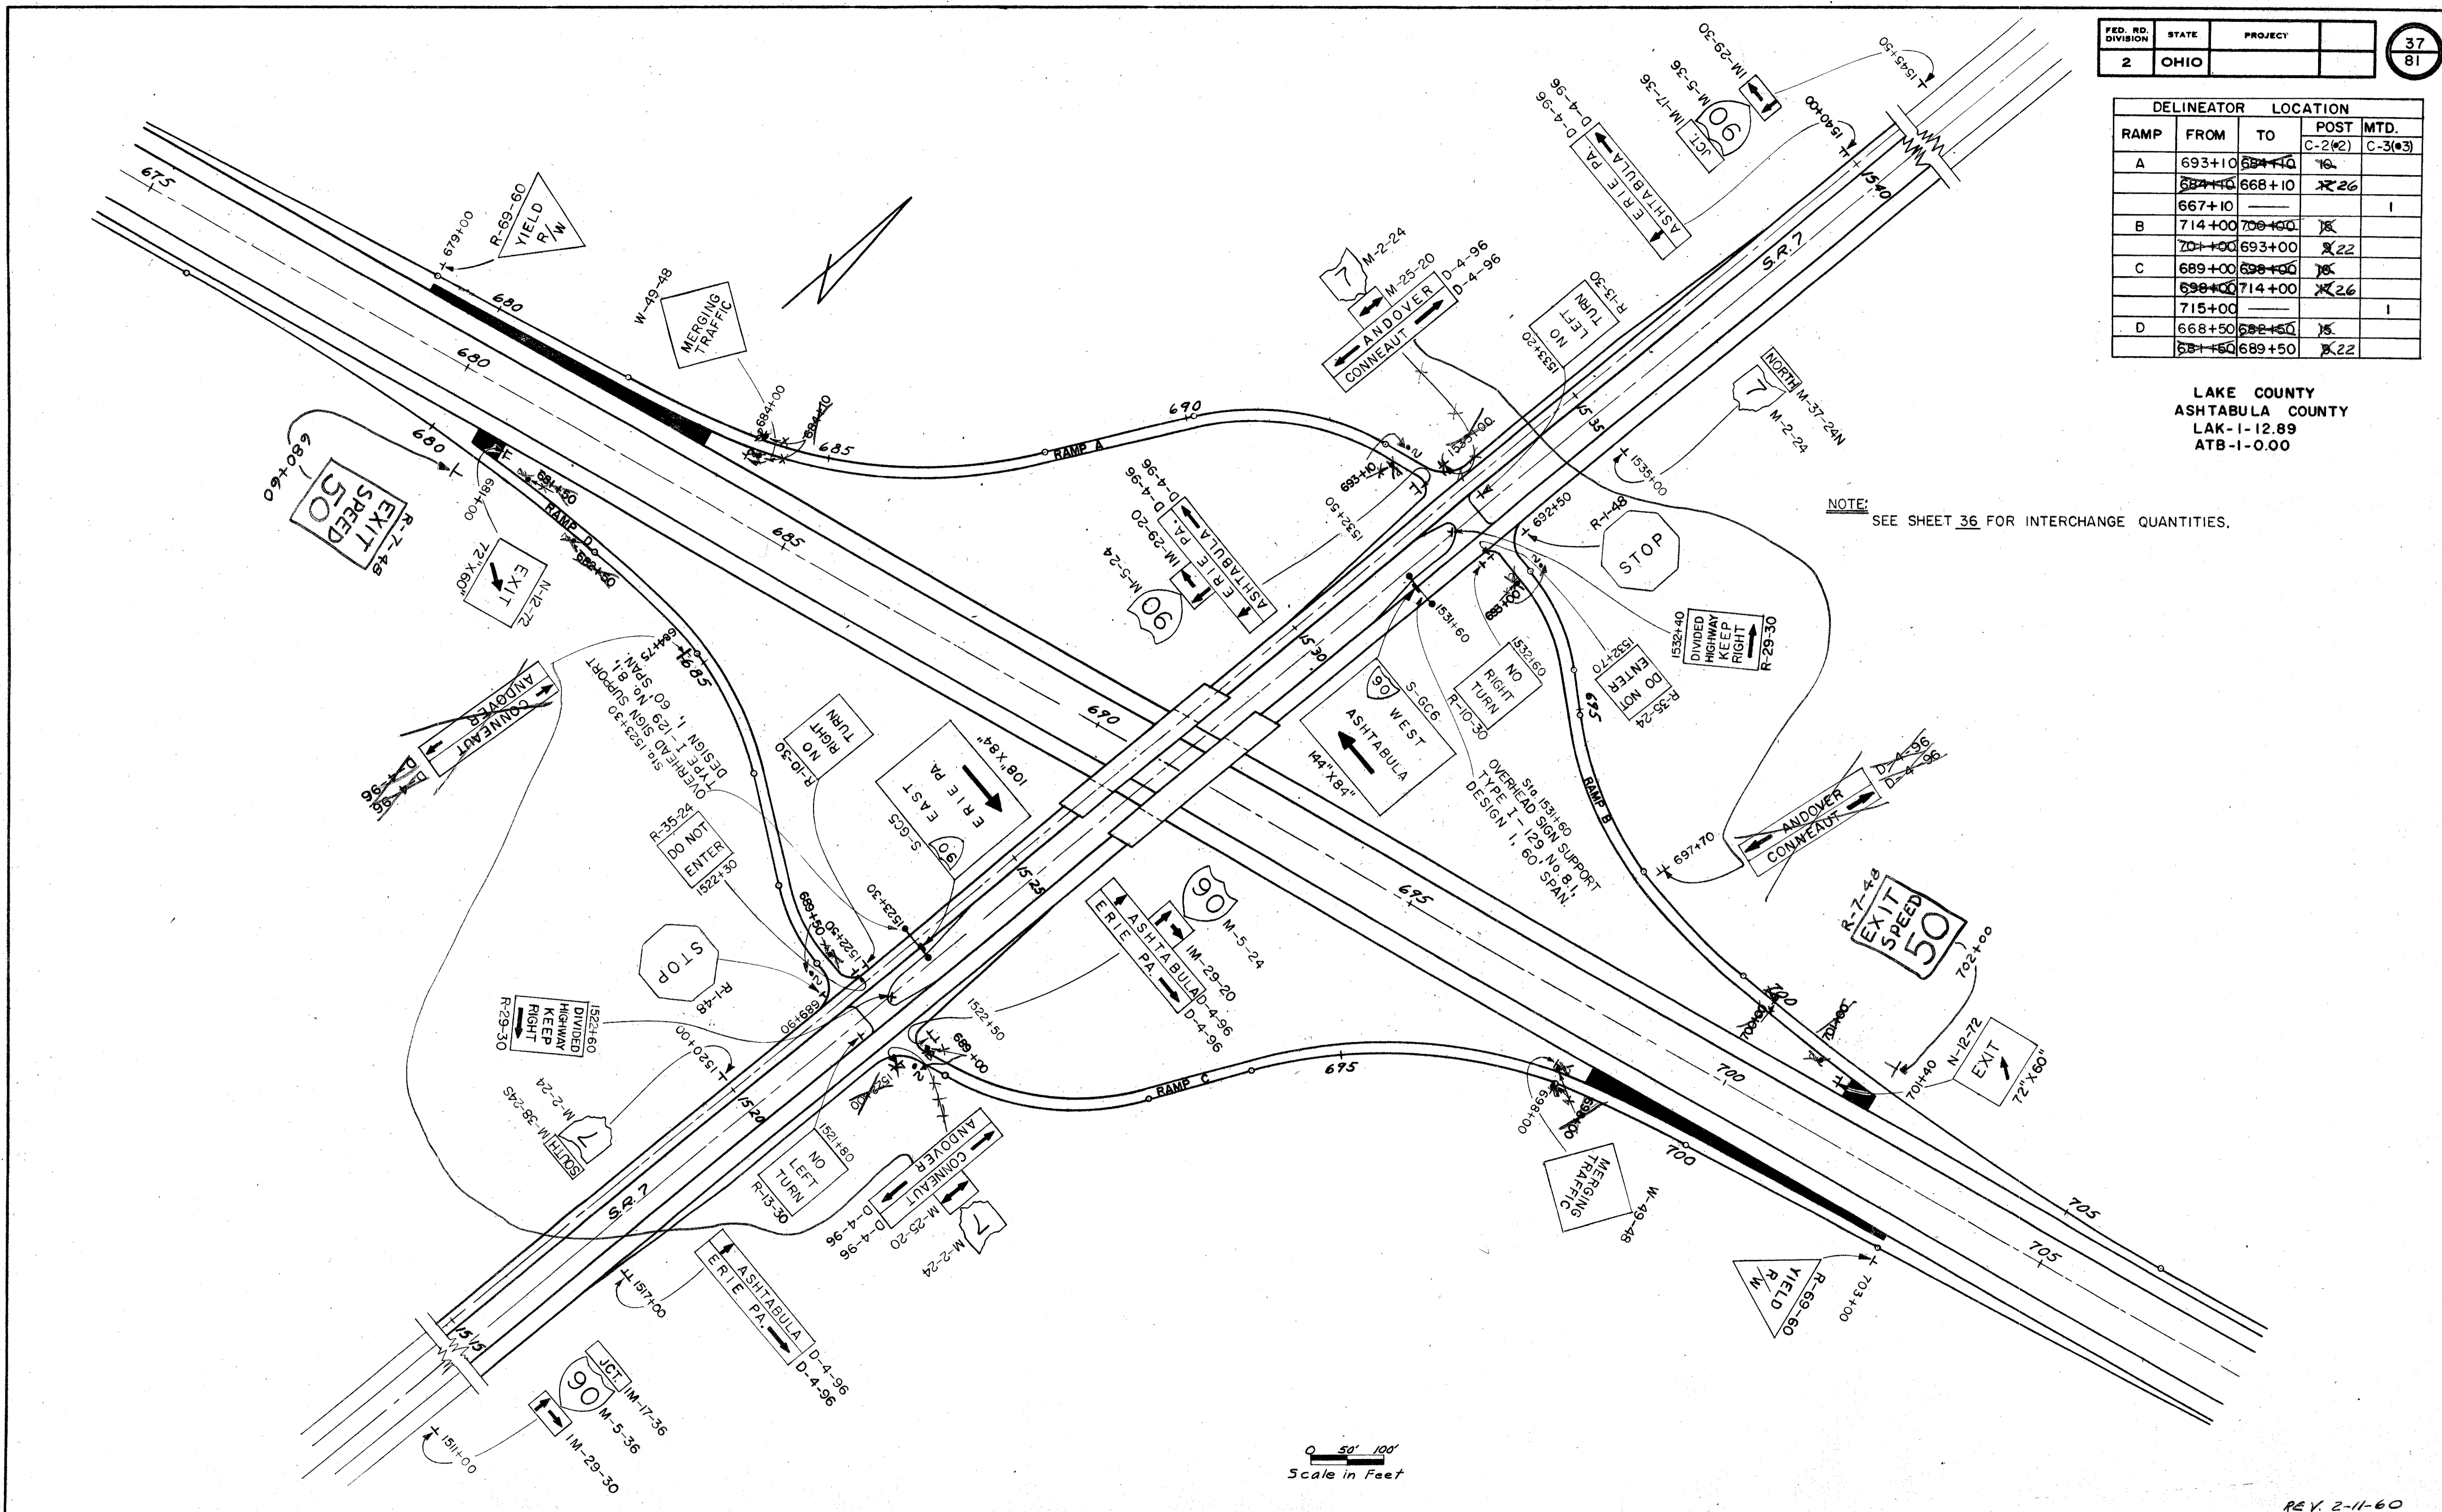

0 50' 100'  
Scale in Feet

**S.R. 7 INTERCHANGE**