

TYPICAL SECTIONS

TYPE T-71


SCALE: $\frac{1}{8}'' = 1'-0''$

FED. RD. DIVISION	STATE	PROJECT	
2	OHIO	ACI-1103 (21)	


2
488

LAKE COUNTY
LAK-1-12.89

This sheet supersedes sheet no. 2 of the original plan.

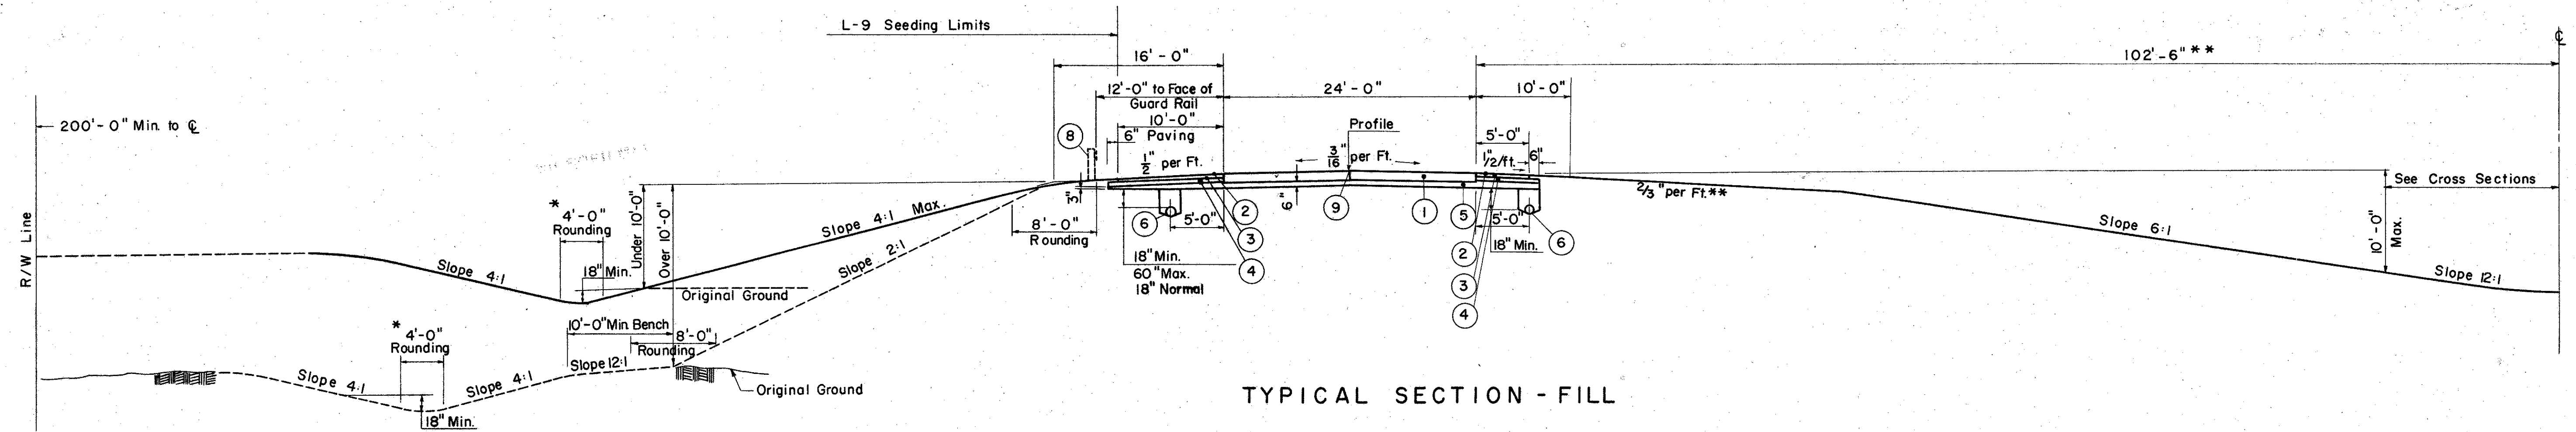

* As required for capacity.

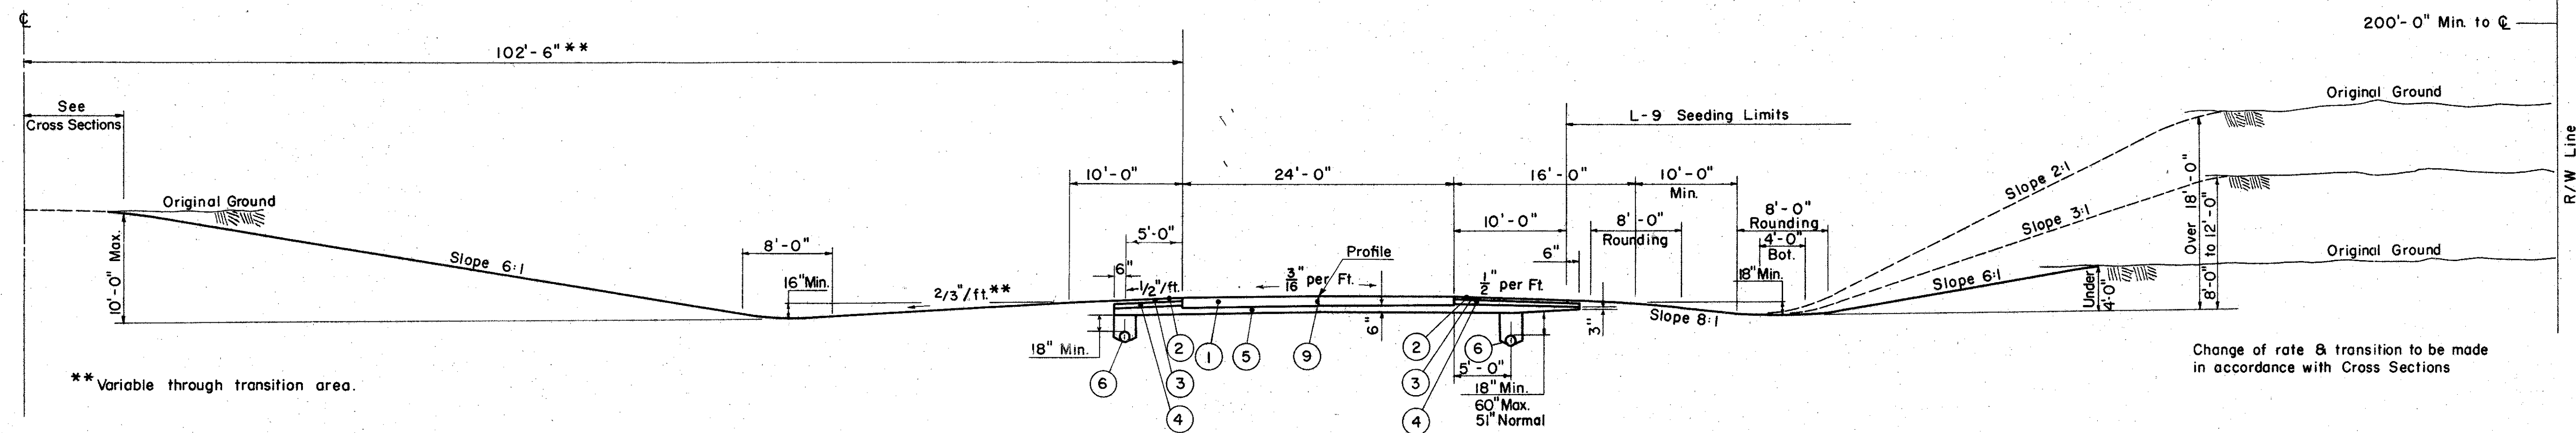

** Variable through transition area.

Change of rate & transition to be made in accordance with Cross Sections

LEGEND

- ① T-71 10" Reinforced Portland Cement Pavement.
- ② T-31 Bituminous Surface Treatment.
- ③ B-33 3" Bituminous Macadam Base Course.
- ④ I-18 5" Stabilized Crushed Aggregate Shoulders & Approaches.
- ⑤ I-22 Variable Depth Subbase.
- ⑥ I-4 6" Pipe Underdrain.
- ⑦ L-9 Seeding & Protecting Roadway Areas.
- ⑧ I-15 Guard Rail.
- ⑨ Standard Longitudinal Joint.

TYPICAL SECTION - CUT

LIMITING STATIONS
STA. 326+50 TO STA. 367+00