
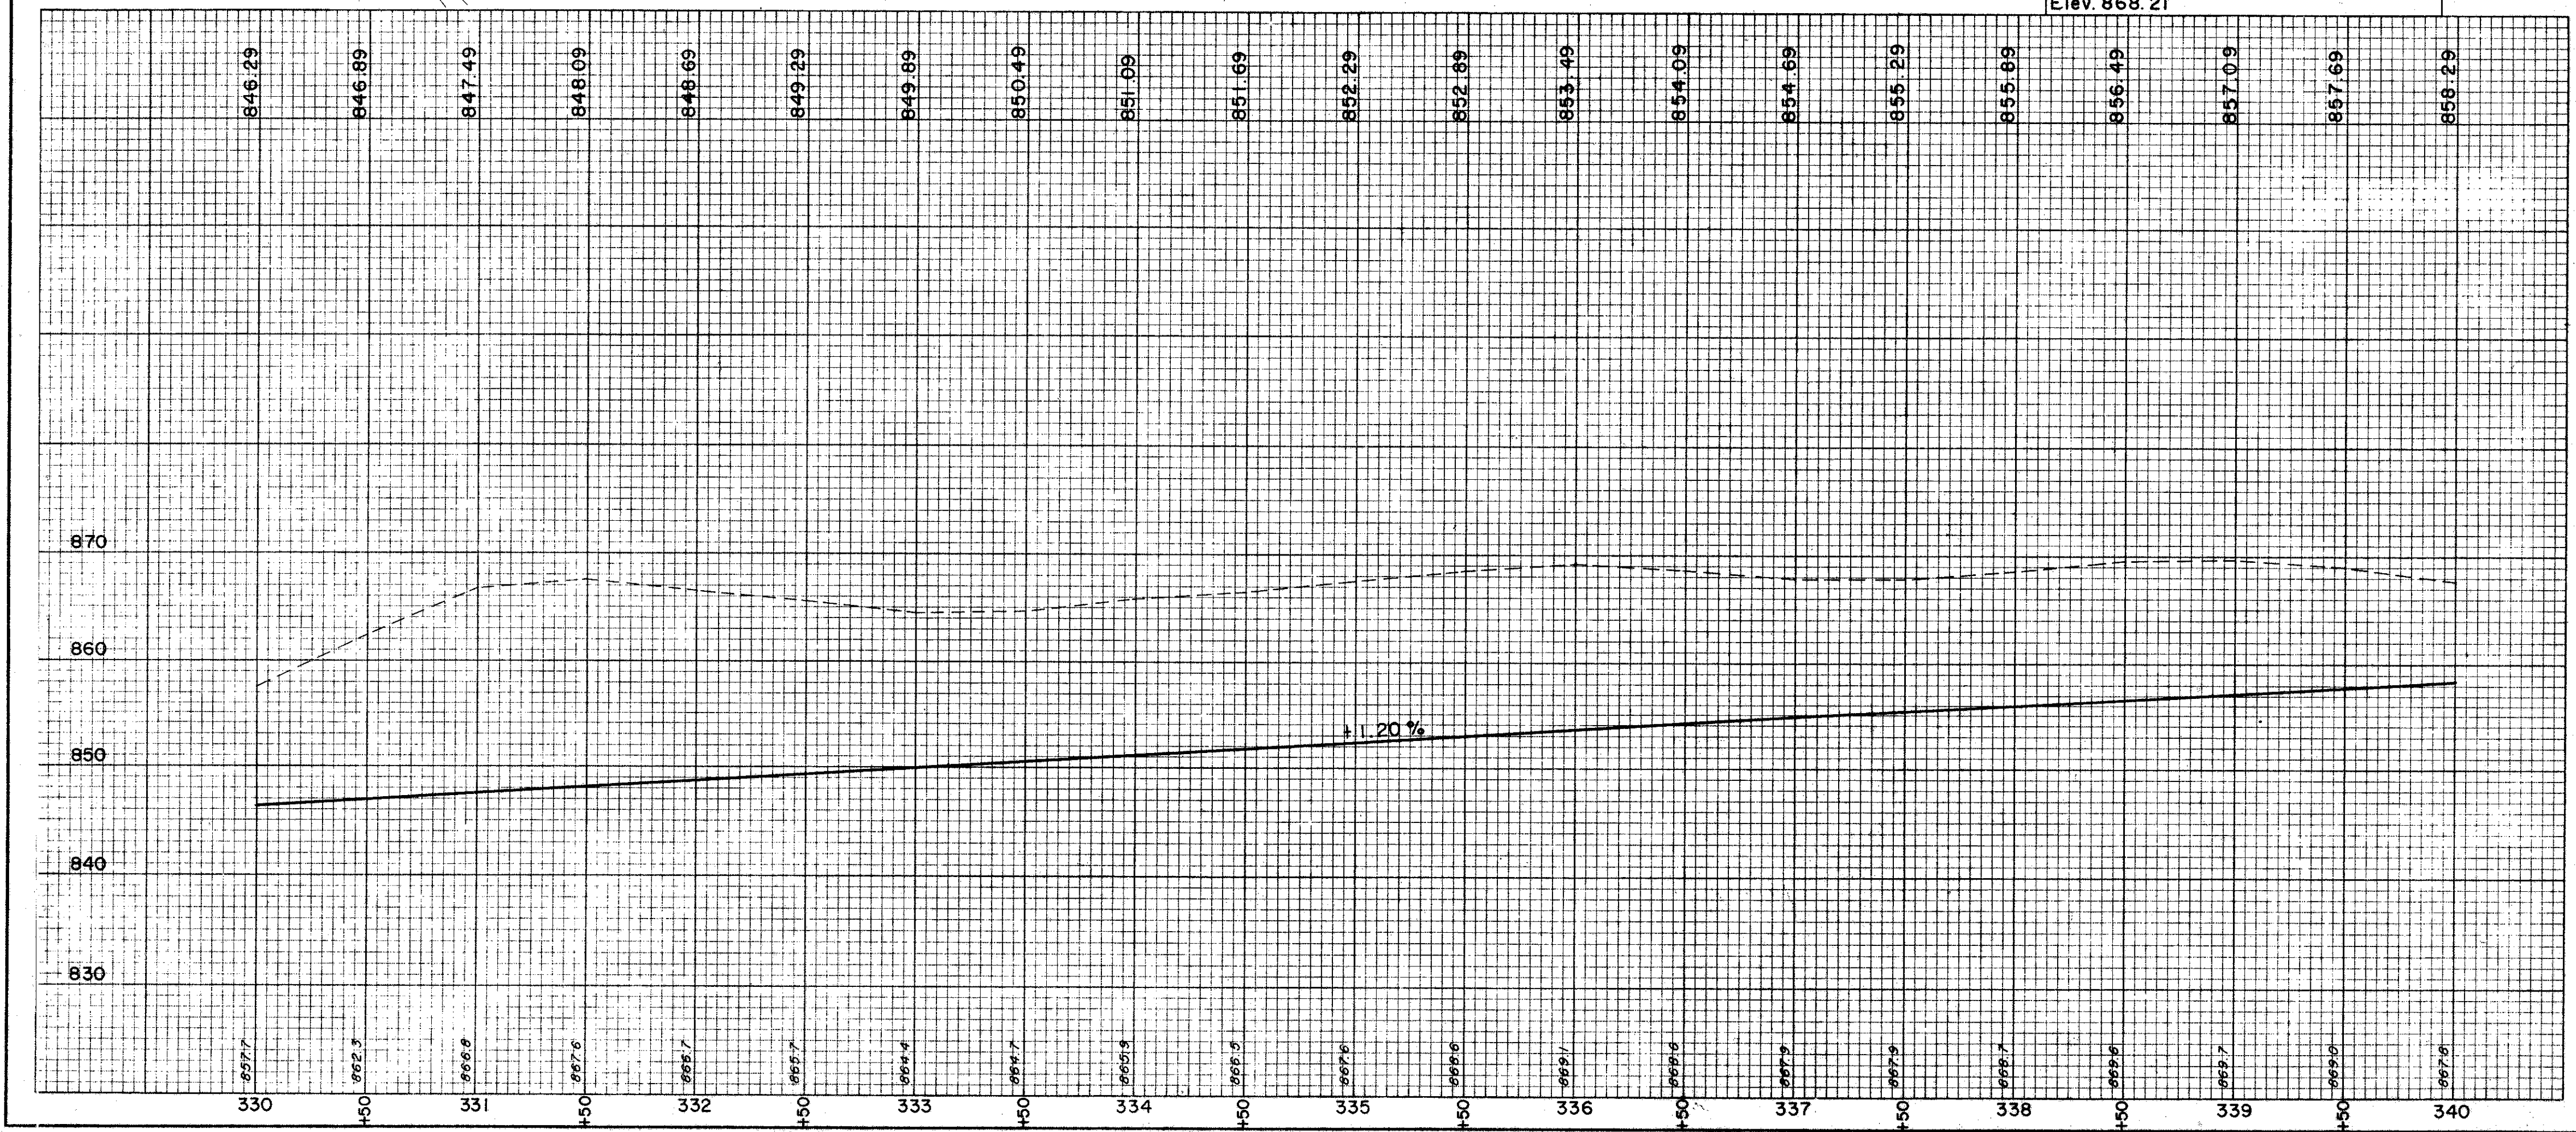


LAKE COUNTY
LAK-1-12.89

This sheet supersedes sheet no. 18
of the original plan.

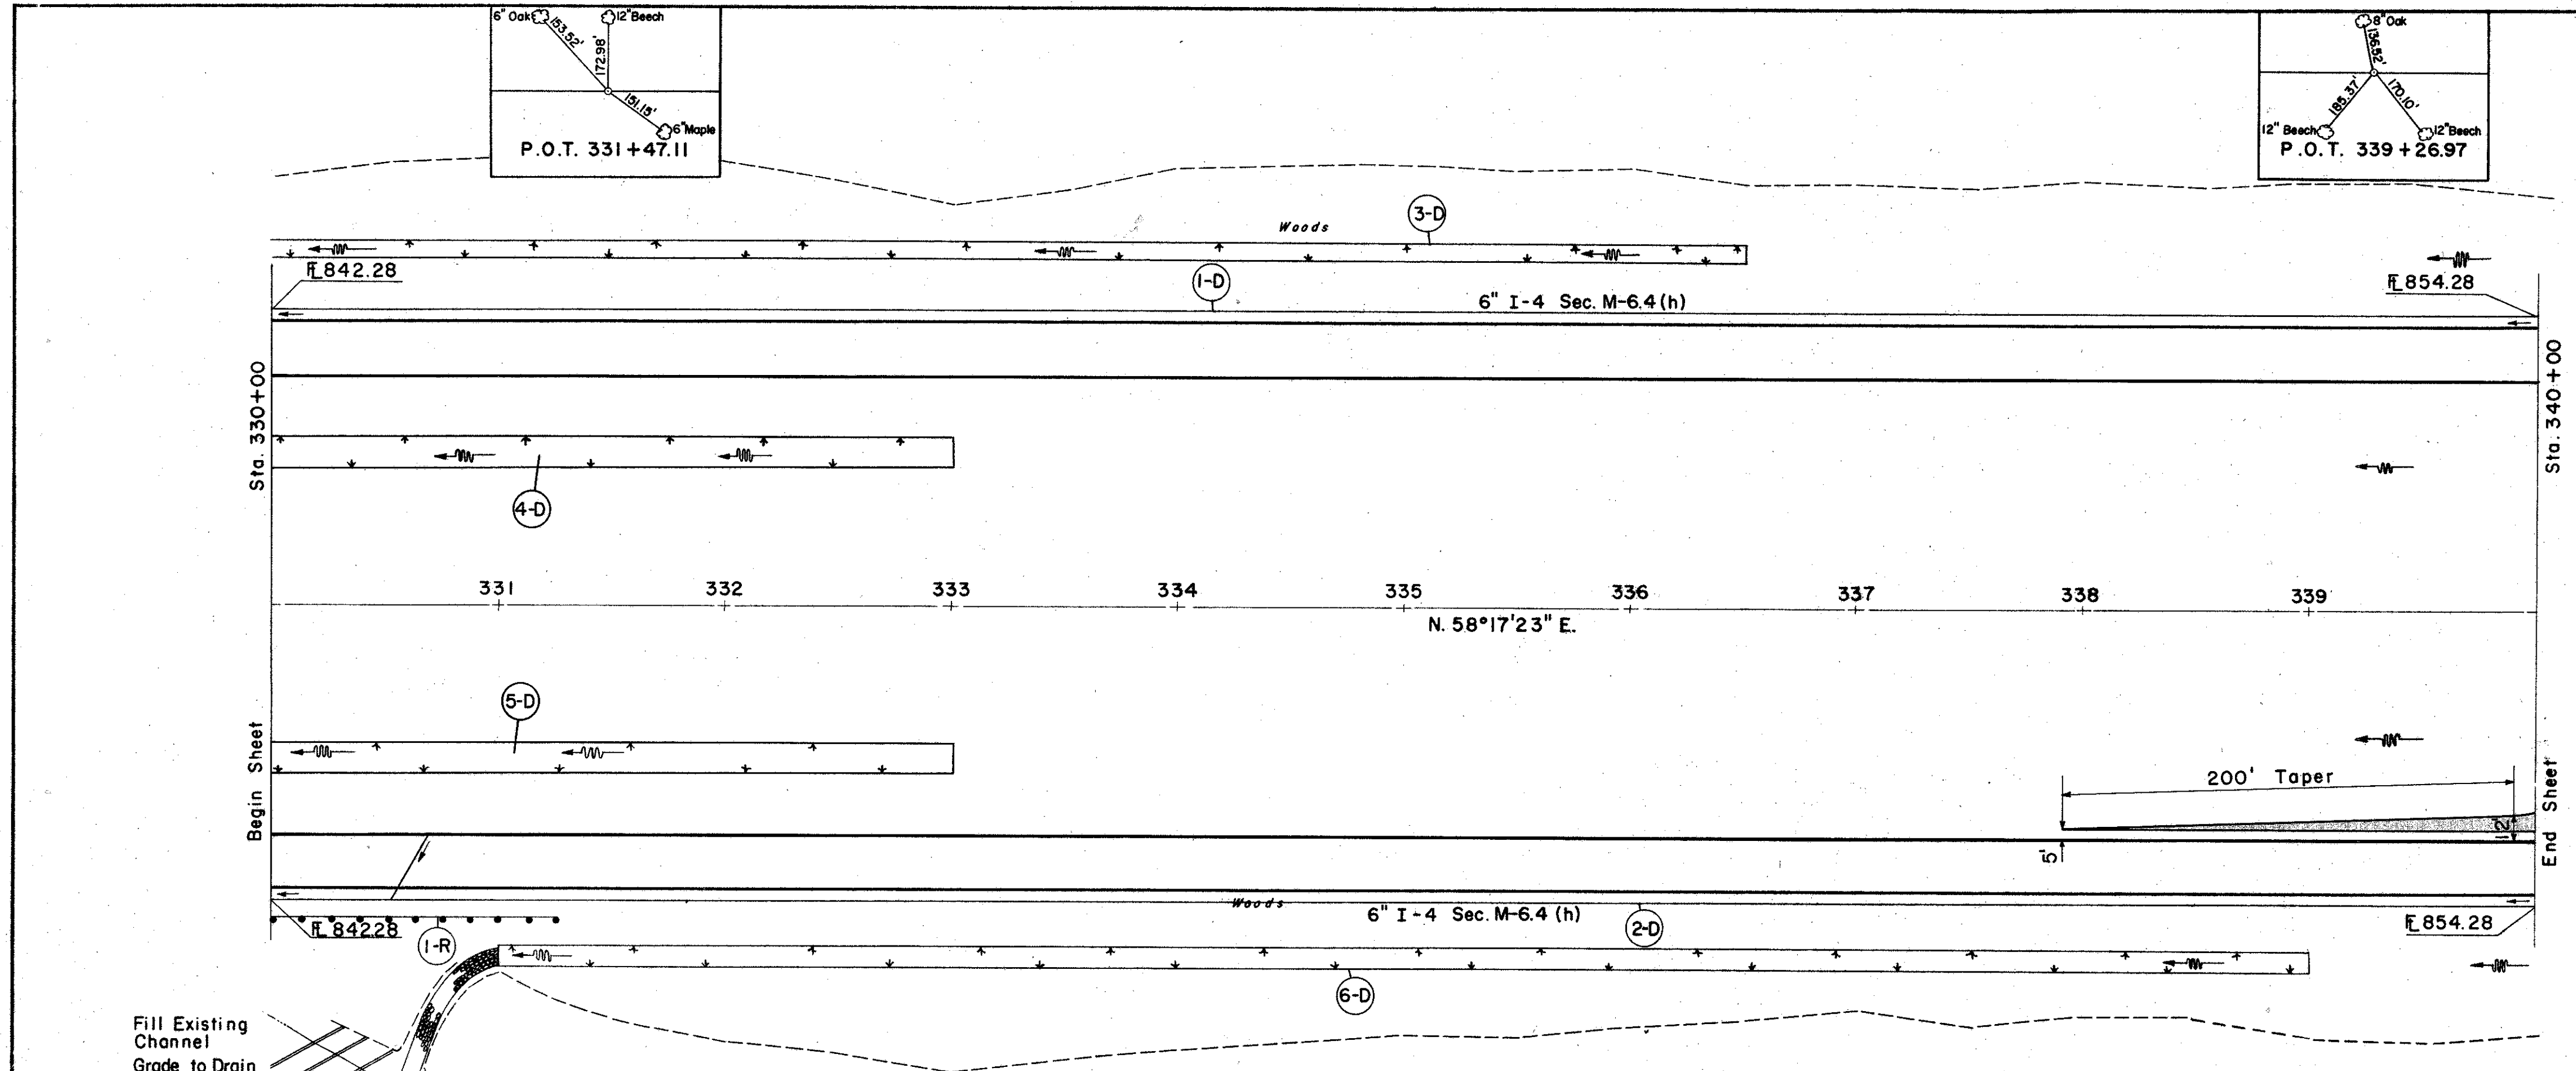

(R) ROADWAY

REF. NO.	STATION	SIDE	TYPE	
			DEPTH	TYPE
I-R330+00	331+25	RT.	12.5	

(D) DRAINAGE

REF. NO.	STATION	SIDE	TYPE	LENGTH	S.Y.	C.Y.
I-D	330+00	340+00	3/4" x 1/4"	1000		
2-D	330+00	340+00	1038	1	628	
3-D	330+00	336+50	LT		453	
4-D	330+00	335+50	LT		453	
5-D	330+00	335+50	RT.		453	
6-D	330+50	339+00	RT.		768	56

STATION	DEPTH OF SODDING, FT.	SLOPES	WIDTH OF SODDING, FT.	LENGTH, FT.	S.Y.
330+00	.42	18:1	6:1	14.0	300
333+00	.38	18:1	6:1	13.2	453
SUBTOTAL					453
330+00	.42	18:1	6:1	14.0	300
333+00	.38	18:1	6:1	13.2	453
SUBTOTAL					453

STATION	DEPTH OF SODDING, FT.	SLOPES	WIDTH OF SODDING, FT.	LENGTH, FT.	S.Y.
330+00	.5	8:1	3:1	9.5	628
336+50	.35	8:1	3:1	7.9	
SUBTOTAL					628
331+00	.43	18:1	3:1	8.7	600
337+00	.40	8:1	3:1	8.4	570
337+00	.40	8:1	6:1	9.6	198
339+00	.30	8:1	6:1	8.2	
SUBTOTAL					768

Excavation	= 147,285 C.Y.
EMBANKMENT	= 2,353 C.Y.
EMBANKMENT +175%	= 2,765 C.Y.