

SEEDING
END SP.
WIDTH YDS.

280 260 240 220 200 180 160 140 120 100 80 60 40

2 ONR ACI-1103 (21)

39
488

This sheet supersedes sheet no. 39
of the original plan.


LAKE COUNTY
LAK-1-12.89

355

356

349

Sta. 327+00

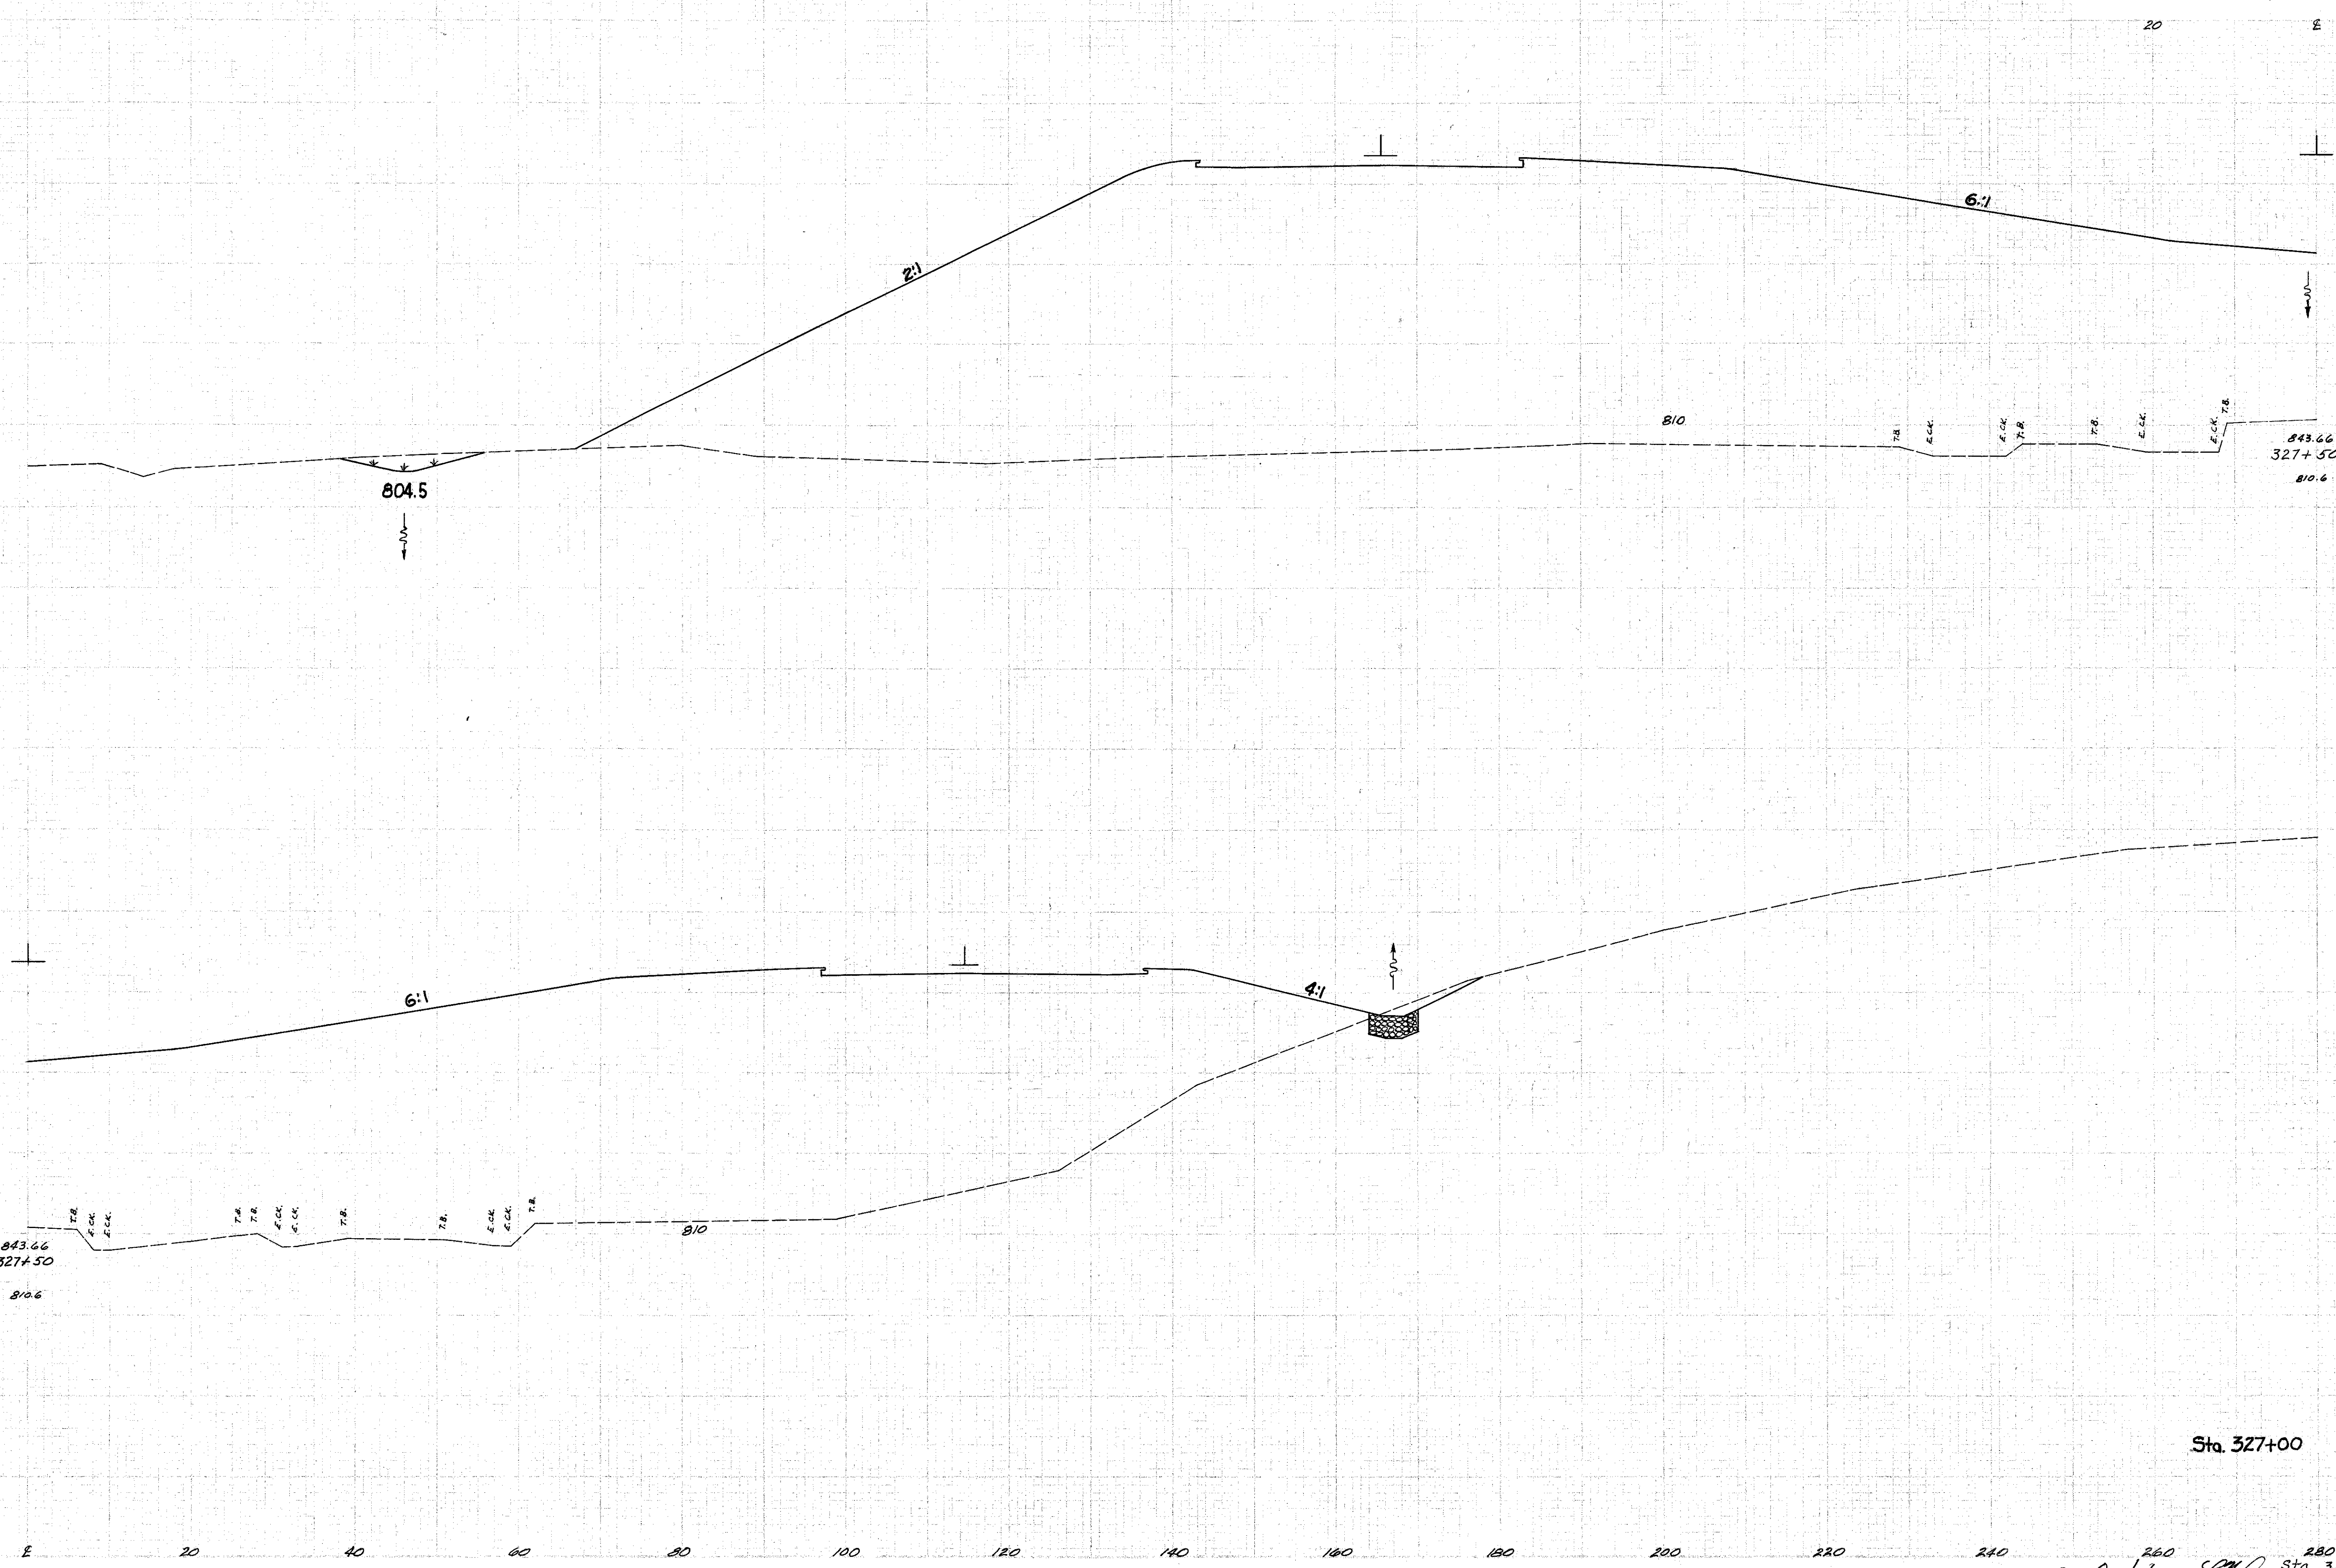

END AREA		CU. YDS.	
CUT	FILL	CUT	FILL
33	9827		
248	16510		
		235	8004

Sta. 327+00

27 Oct. '58
Sta. 327+50