


SEEDING  
END SQ.  
WIDTH YDS.

DESIGN NO.	DATE	PROJECT
2	OHIO	ACI-1103 (21)

40  
488

This sheet supersedes sheet no. 40  
of the original plan.

LAKE COUNTY  
LAK-1-12.89

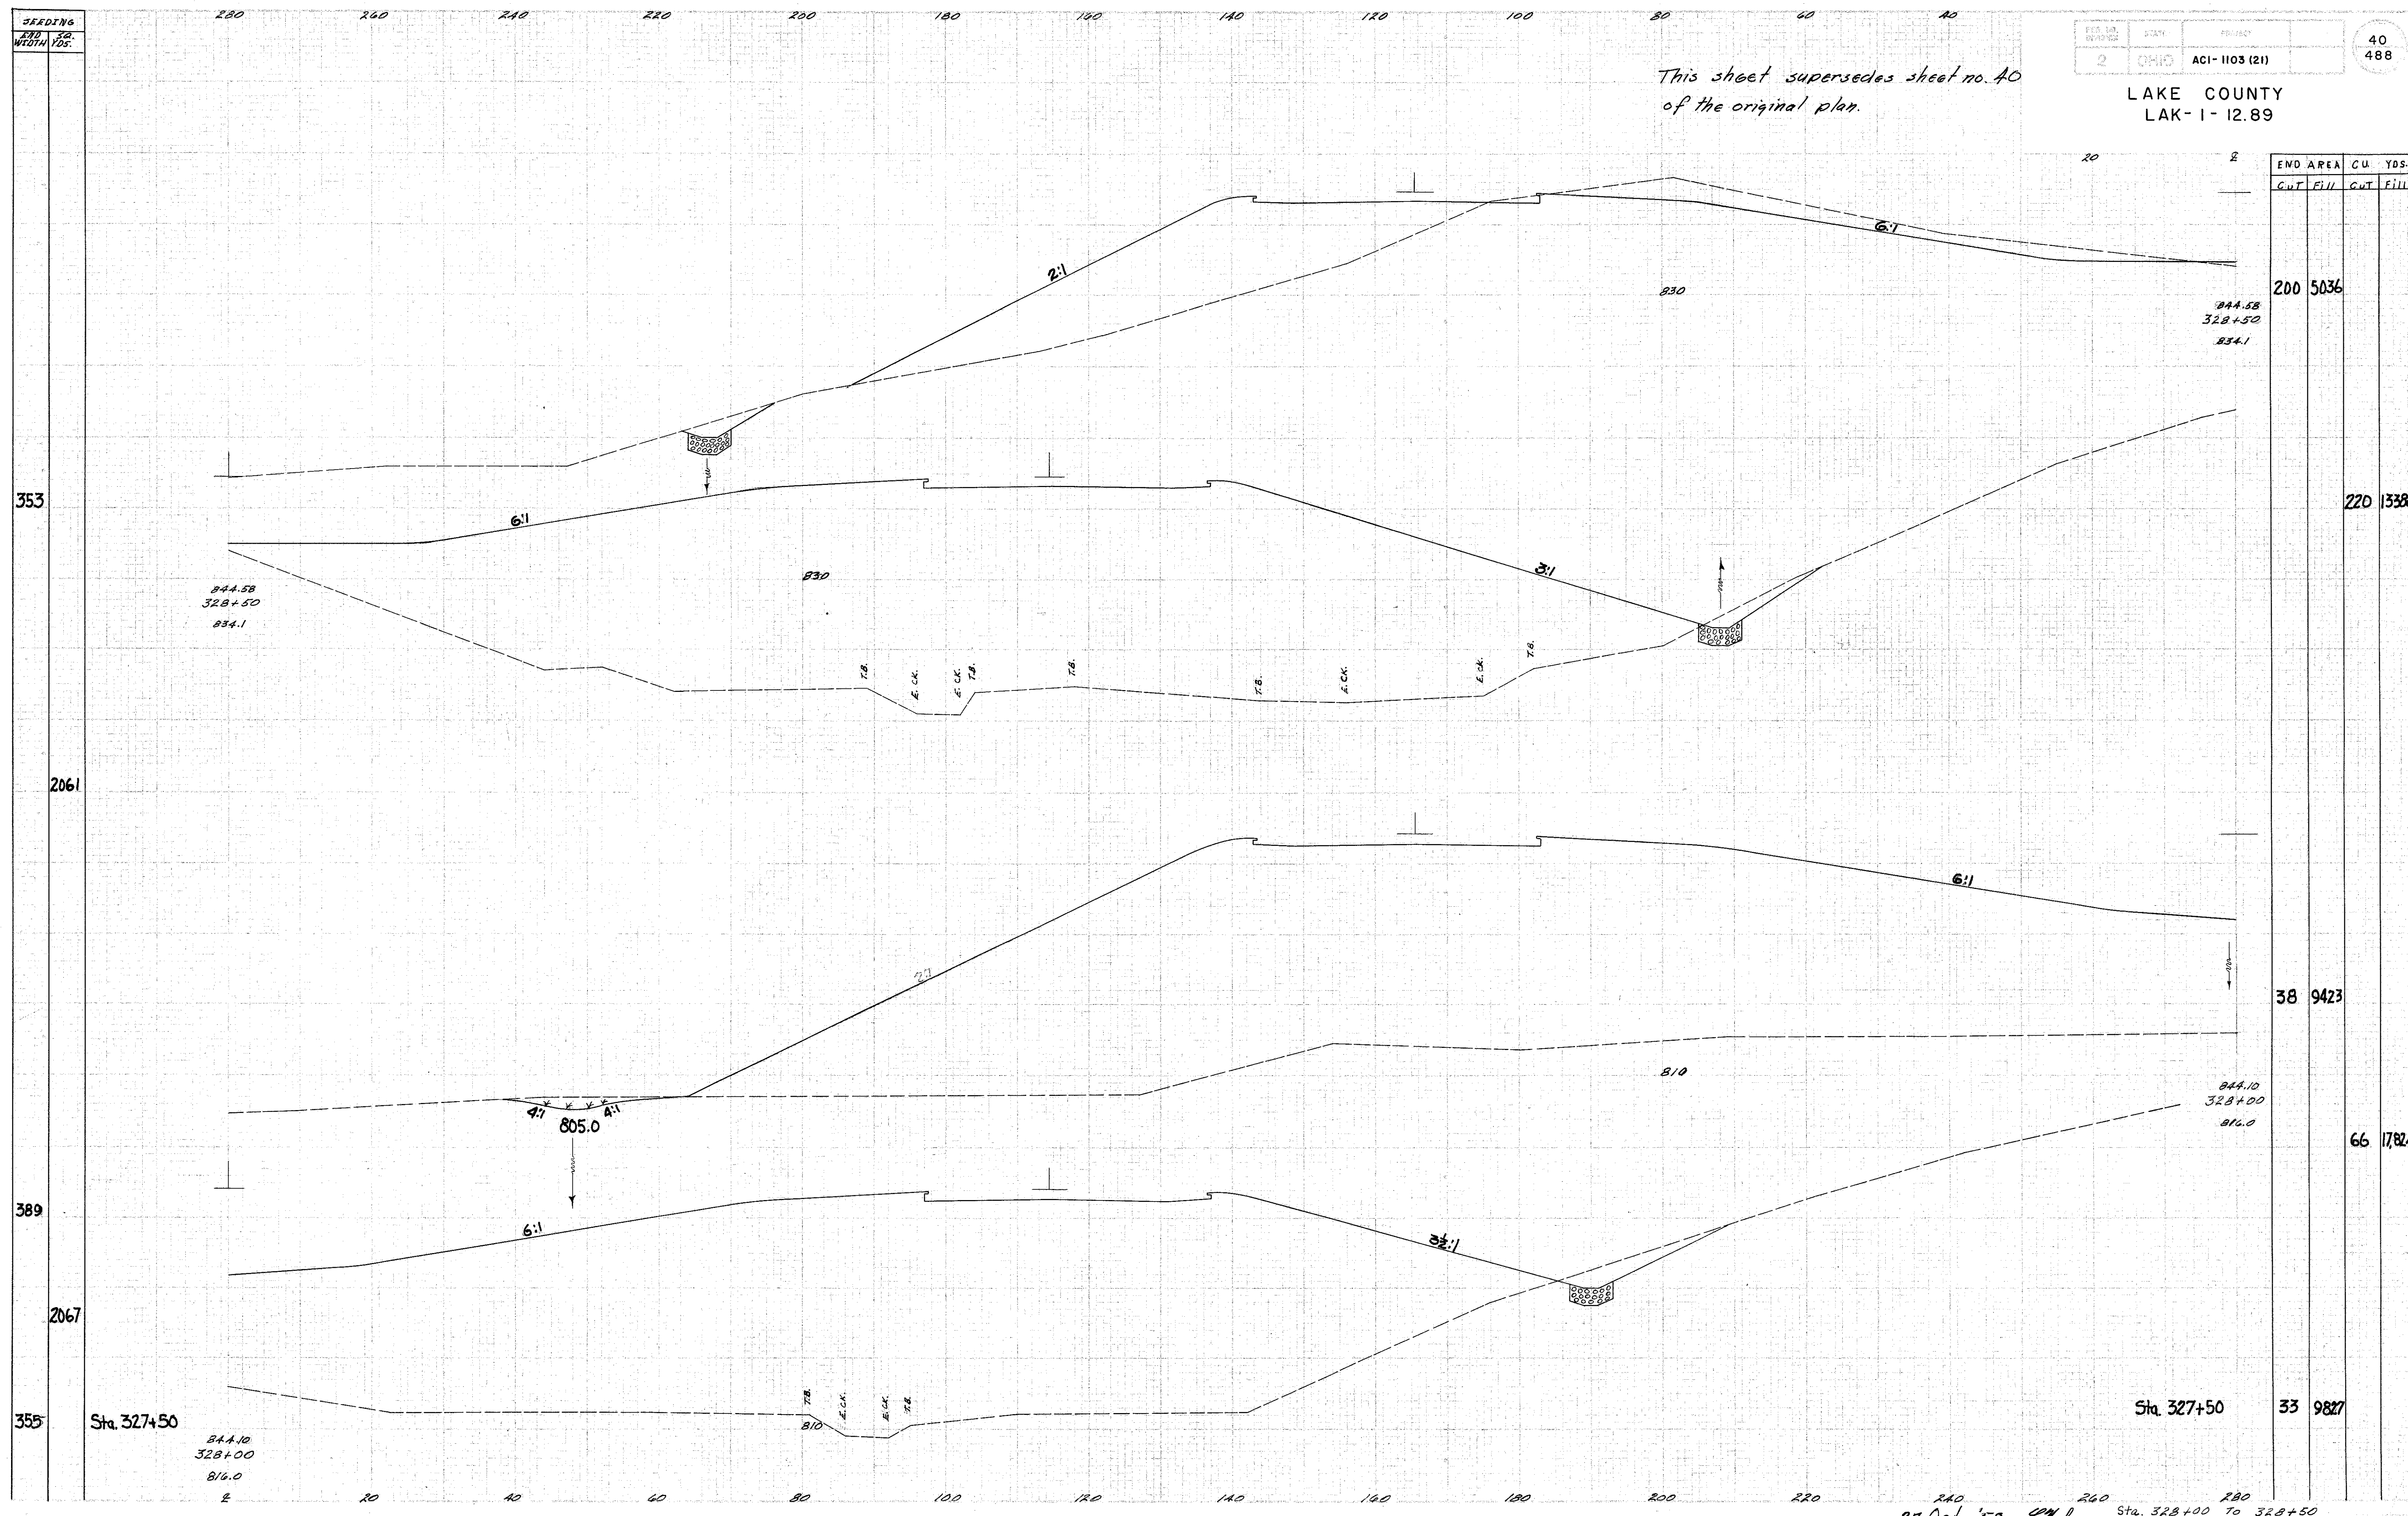

END AREA	CU.		YDS.	
	CUT	FILL	CUT	FILL
200	5036			
220	13388			
38	9423			
66	17824			
33	9827			

Sta. 327+50  
844.10  
328+00  
816.0

Sta. 327+50  
33 9827

27 Oct. '58  
Sta. 328+00 To 328+50