


280 260 240 220 200 180 160 140 120 100 80 60 40

SECTION
END WIDTH SQ. YDS.

PLAN NO.	DATE	PROJECT	41
2	OHIO	ACI-1103 (21)	488

This sheet supersedes sheet no. 41 of the original plan.

LAKE COUNTY
LAK-1-12.89

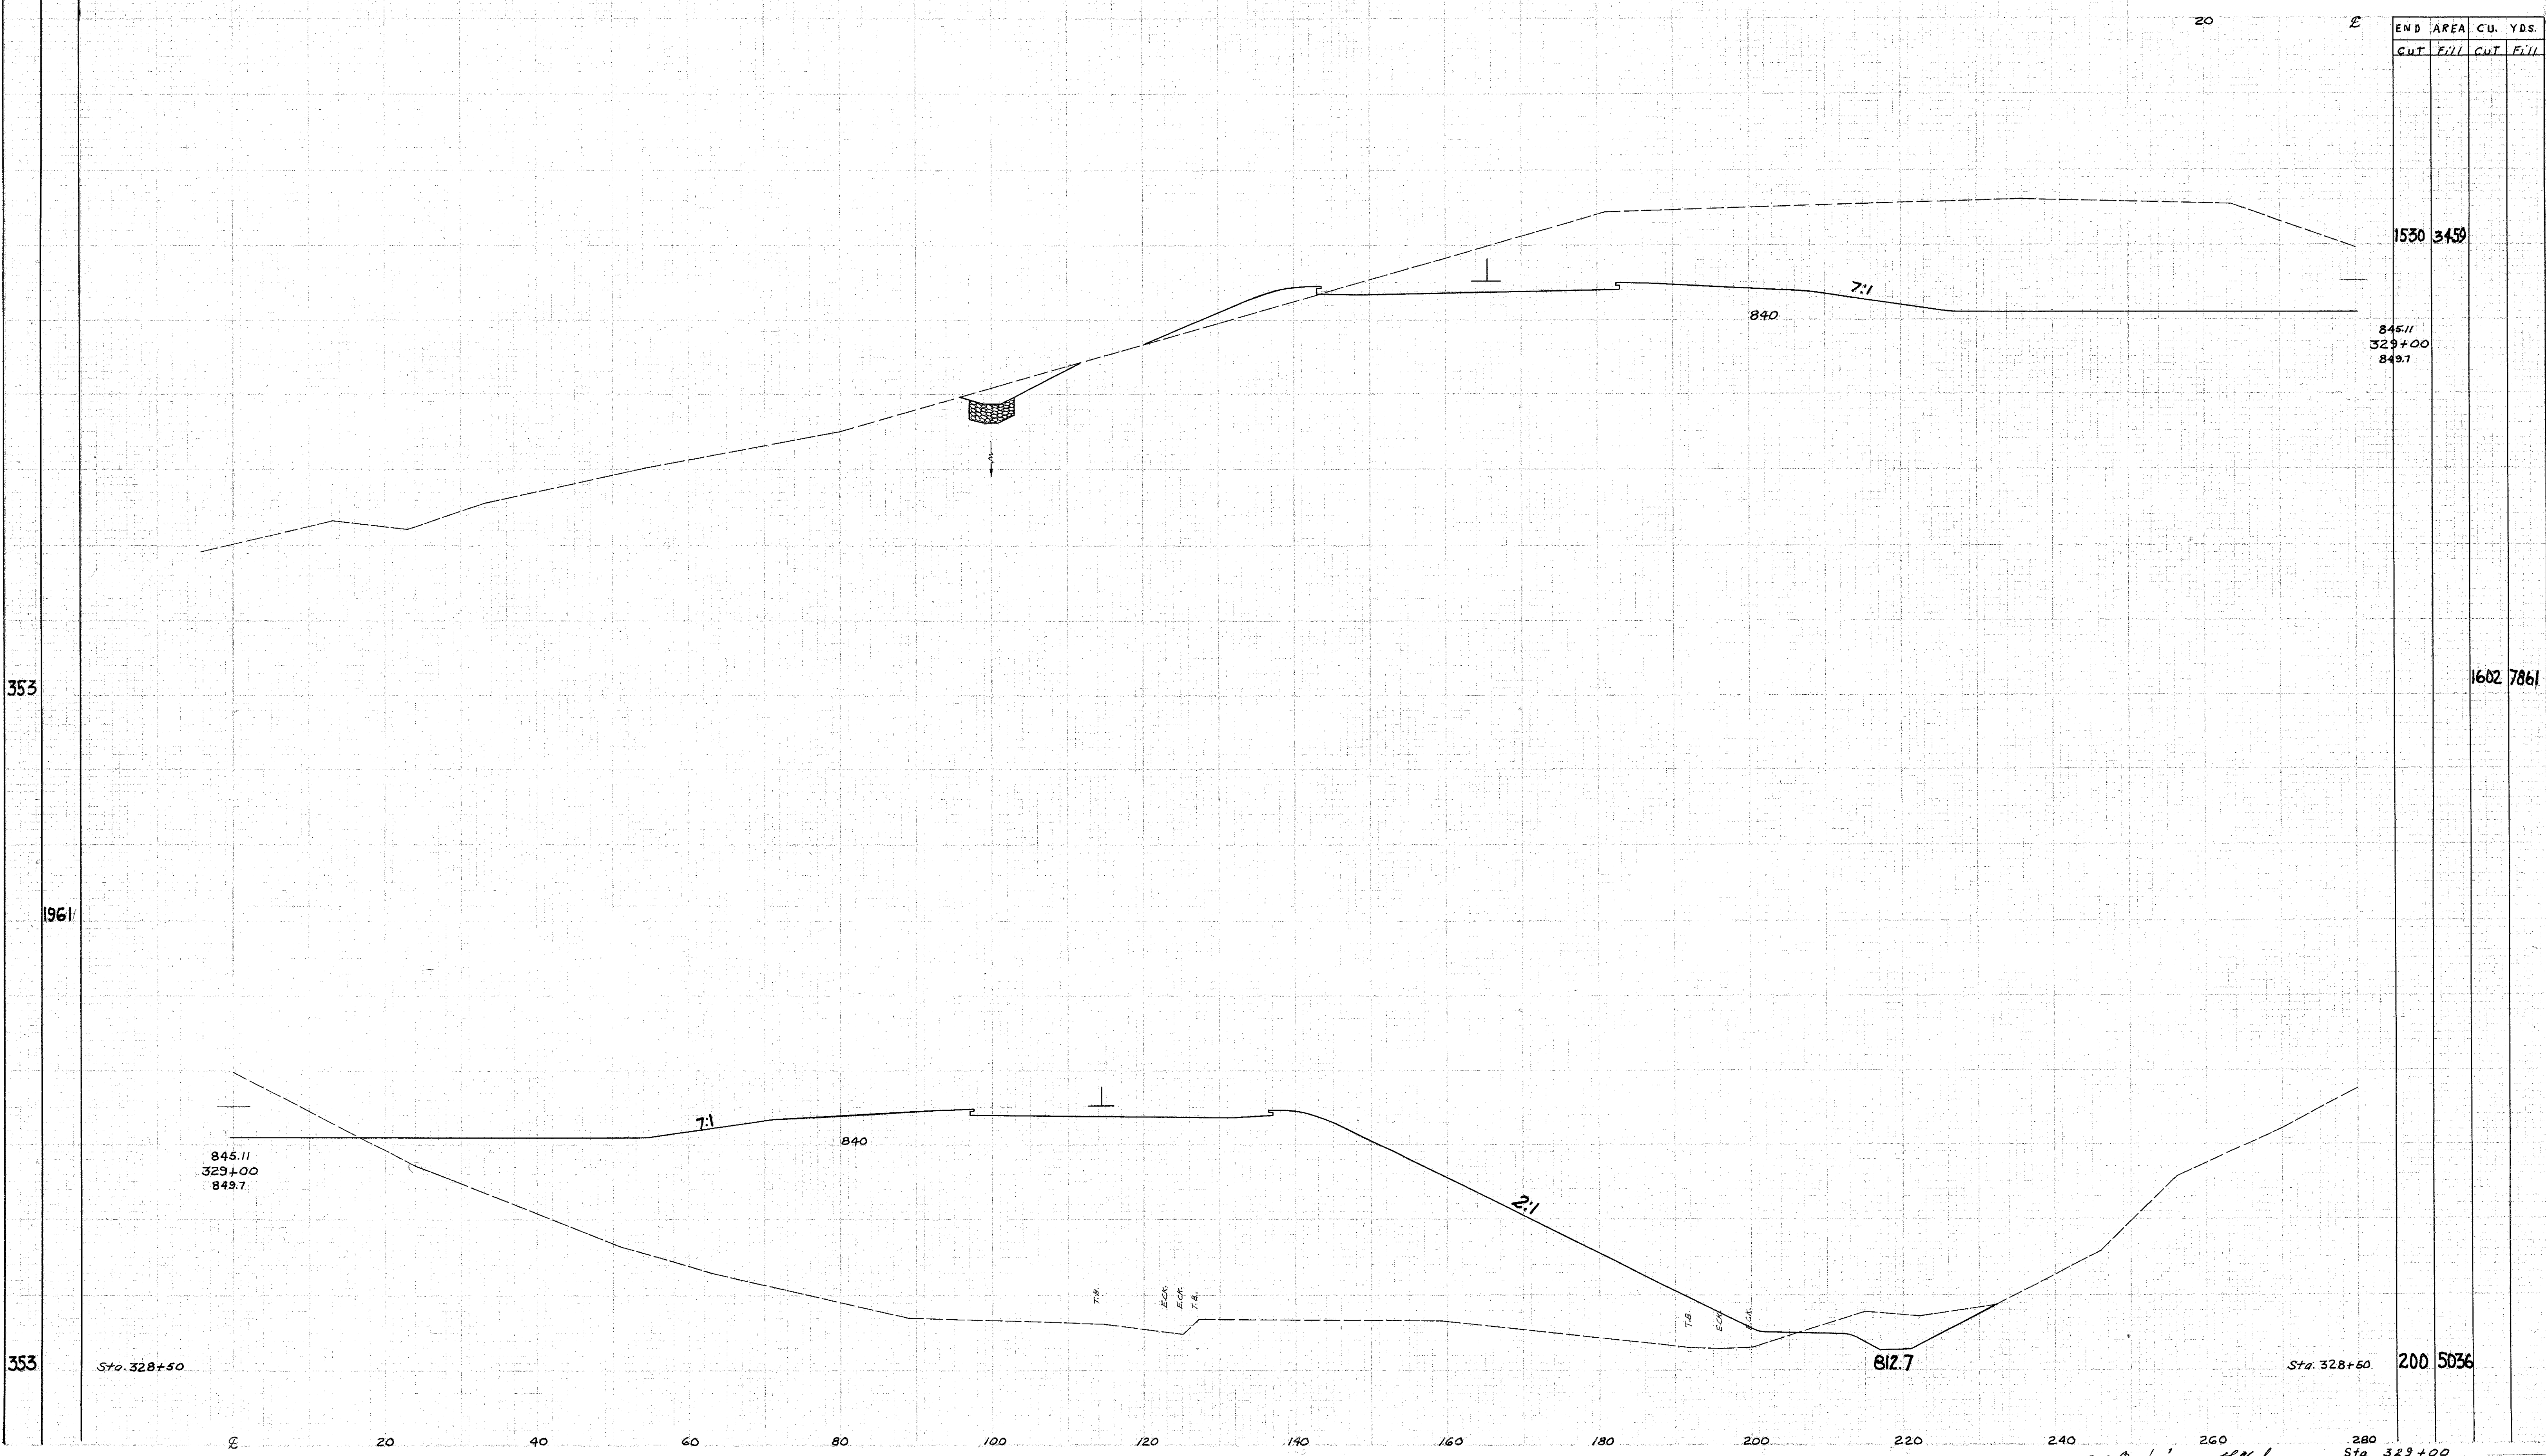

END AREA		CU. YDS.	
CUT	FILL	CUT	FILL

1530	3459
845.11	329+00
849.7	

1602 7861

200	5036
-----	------

27 Oct. '58 *[Signature]*

Sta. 329+00