


SEEDING 280 260 240 220 200 180 160 140 120 100 80 60 40

PLAN NO.	SHEET	PROJECT
2	OHIO	ACI-1103 (21)

43
488

This sheet supersedes sheet no. 43
of the original plan.

LAKE COUNTY
LAK-1-12.89

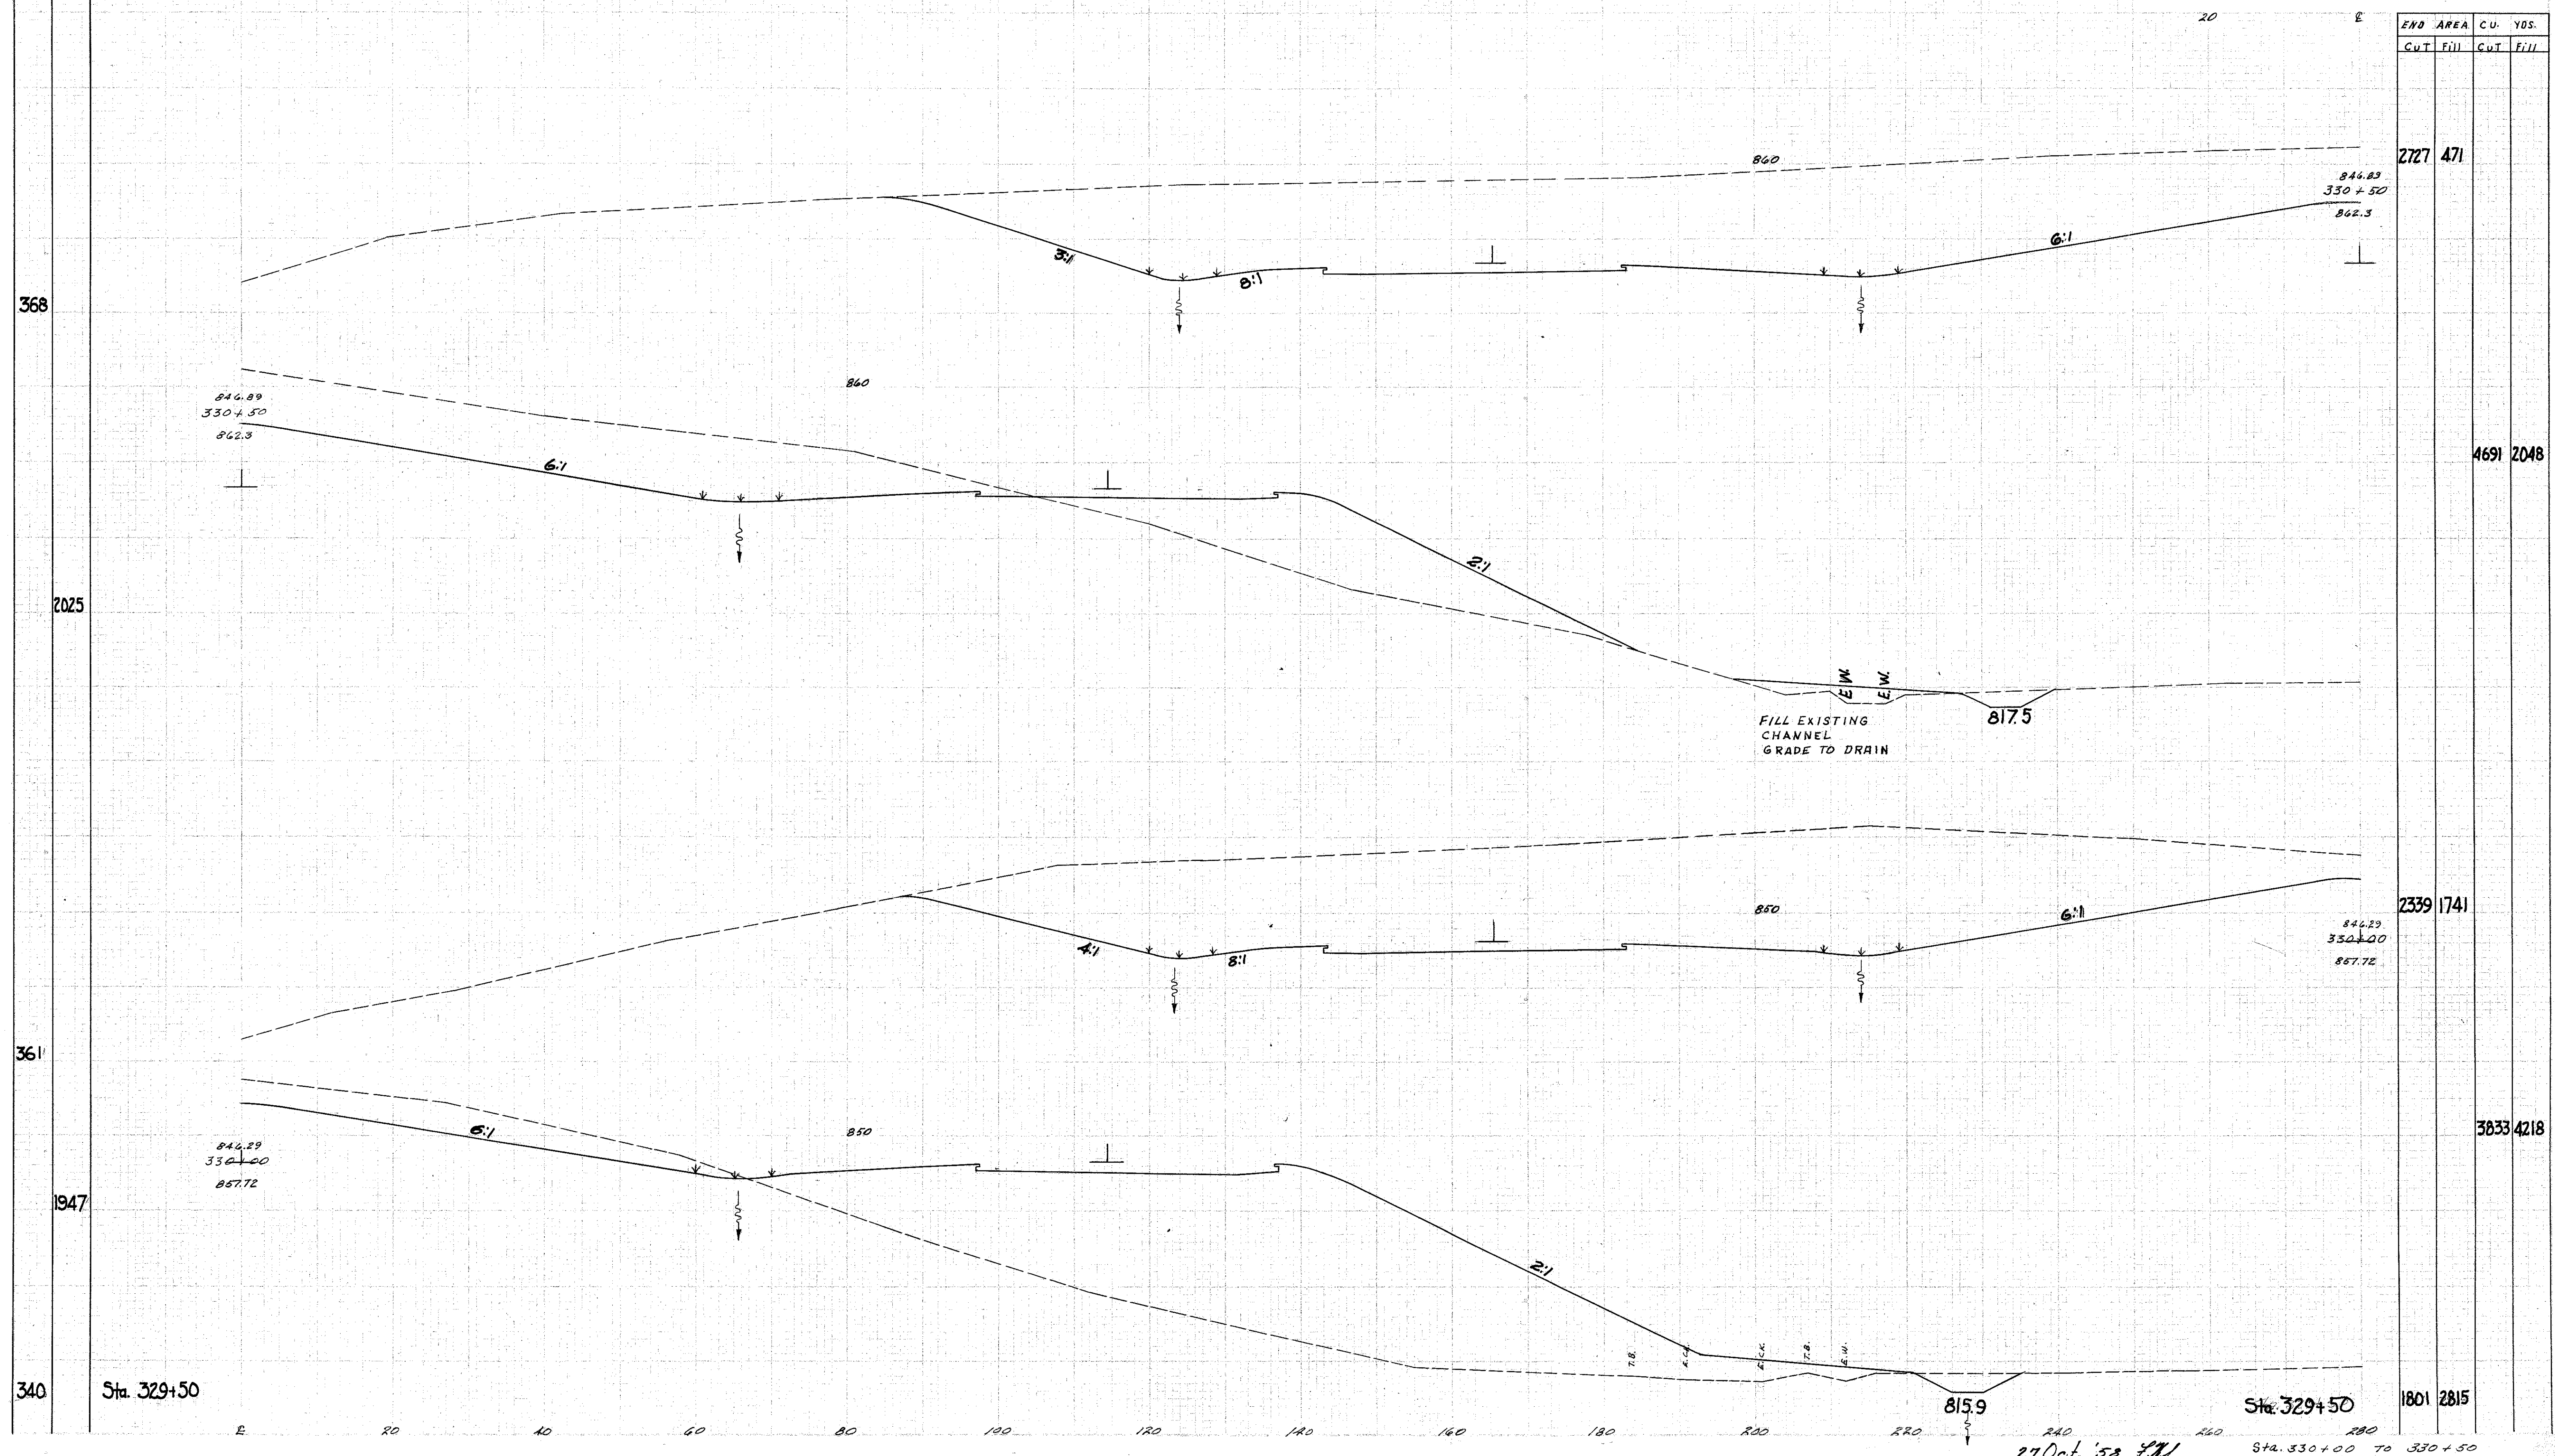

END AREA		CU. YDS.	
CUT	FILL	CUT	FILL
2727	471		
4691	2048		
2339	1741		
1801	2815		

27 Oct. '58 *[Signature]* Sta. 330+00 TO 330+50