

SEEDING  
END  
WIDTH  
SQ.  
YDS.

280 260 240 220 200 180 160 140 120 100 80 60 40

2 CHIC ACI-1103 (21)

44  
488

This sheet supersedes sheet no. 44  
of the original plan.

LAKE COUNTY  
LAK-1-12.89


314

1686

293

1836

368

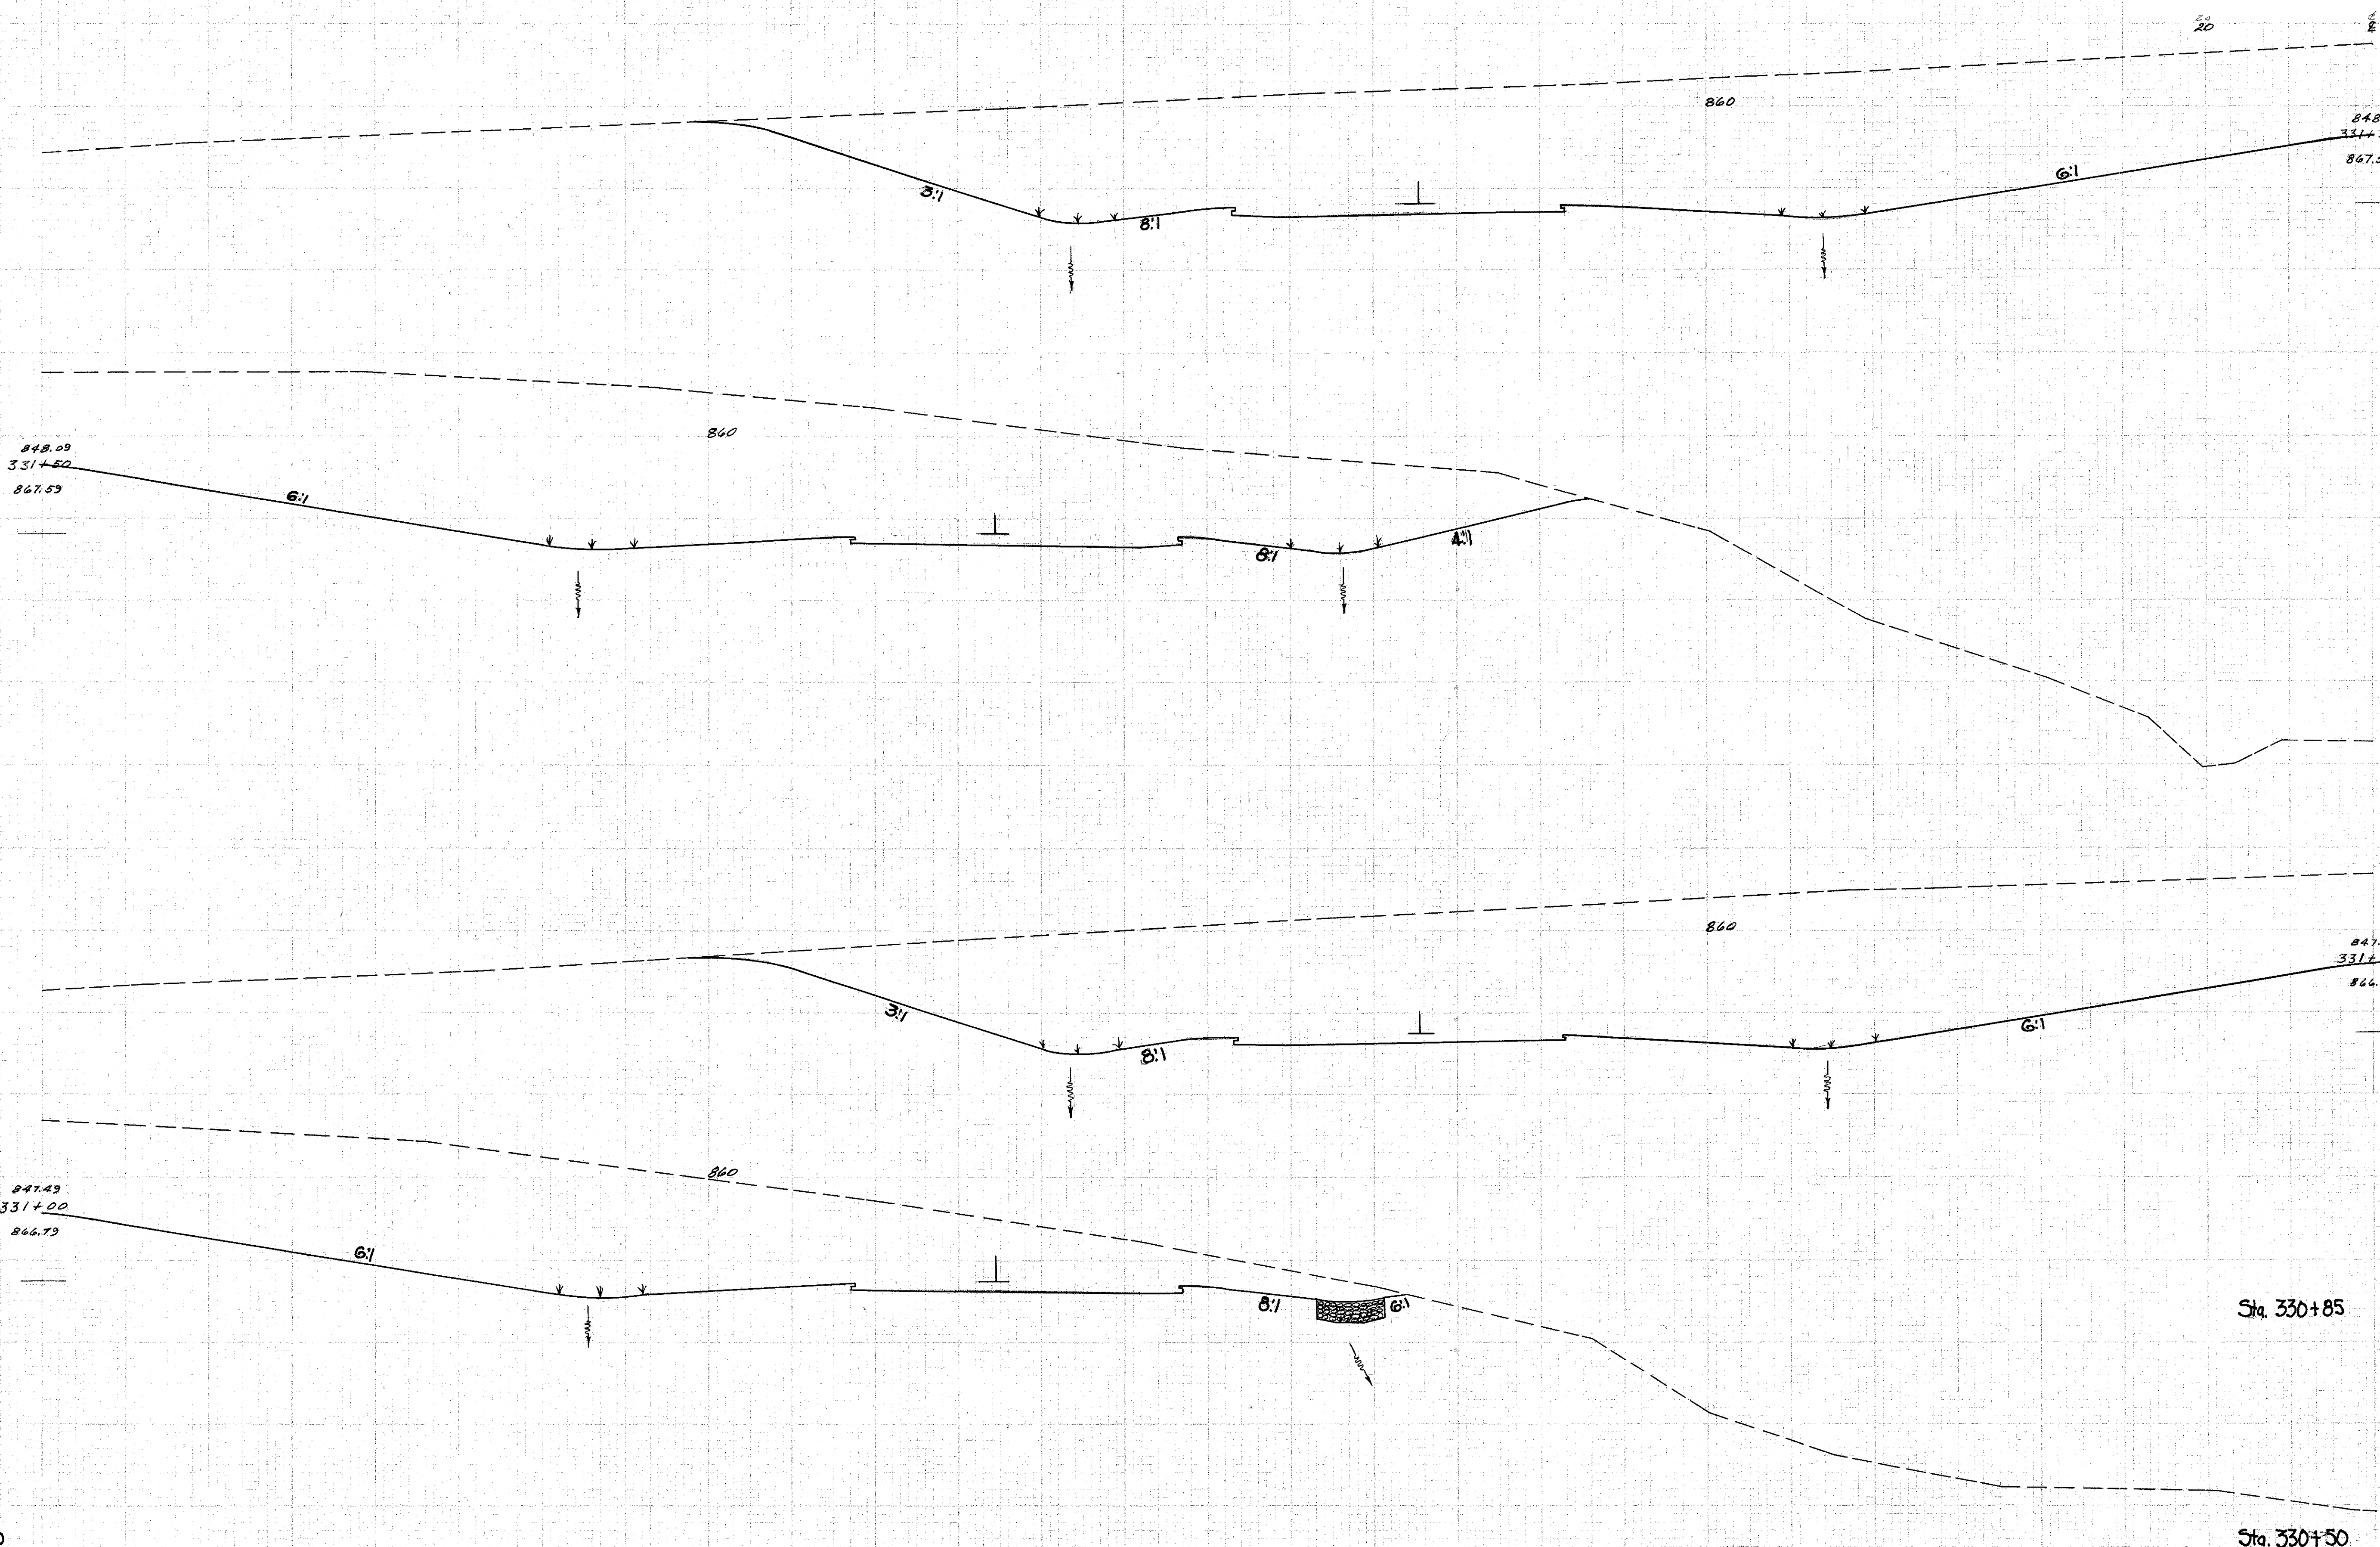

END AREA		CU. YDS.	
CUT	FILL	CUT	FILL
5216			
	8973		
4475			
	2342		
3956	0		
	4332	305	
2727	471		

Sta. 330+50

Sta. 330+50

27 Oct. '58 F. Red Sta. 331+00 To 331+50