


SEEDING
EXH. 38

280 260 240 220 200 180 160 140 120 100 80 60 40

45
488

This sheet supersedes sheet no. 45
of the original plan.

LAKE COUNTY
LAK-1- 12.89

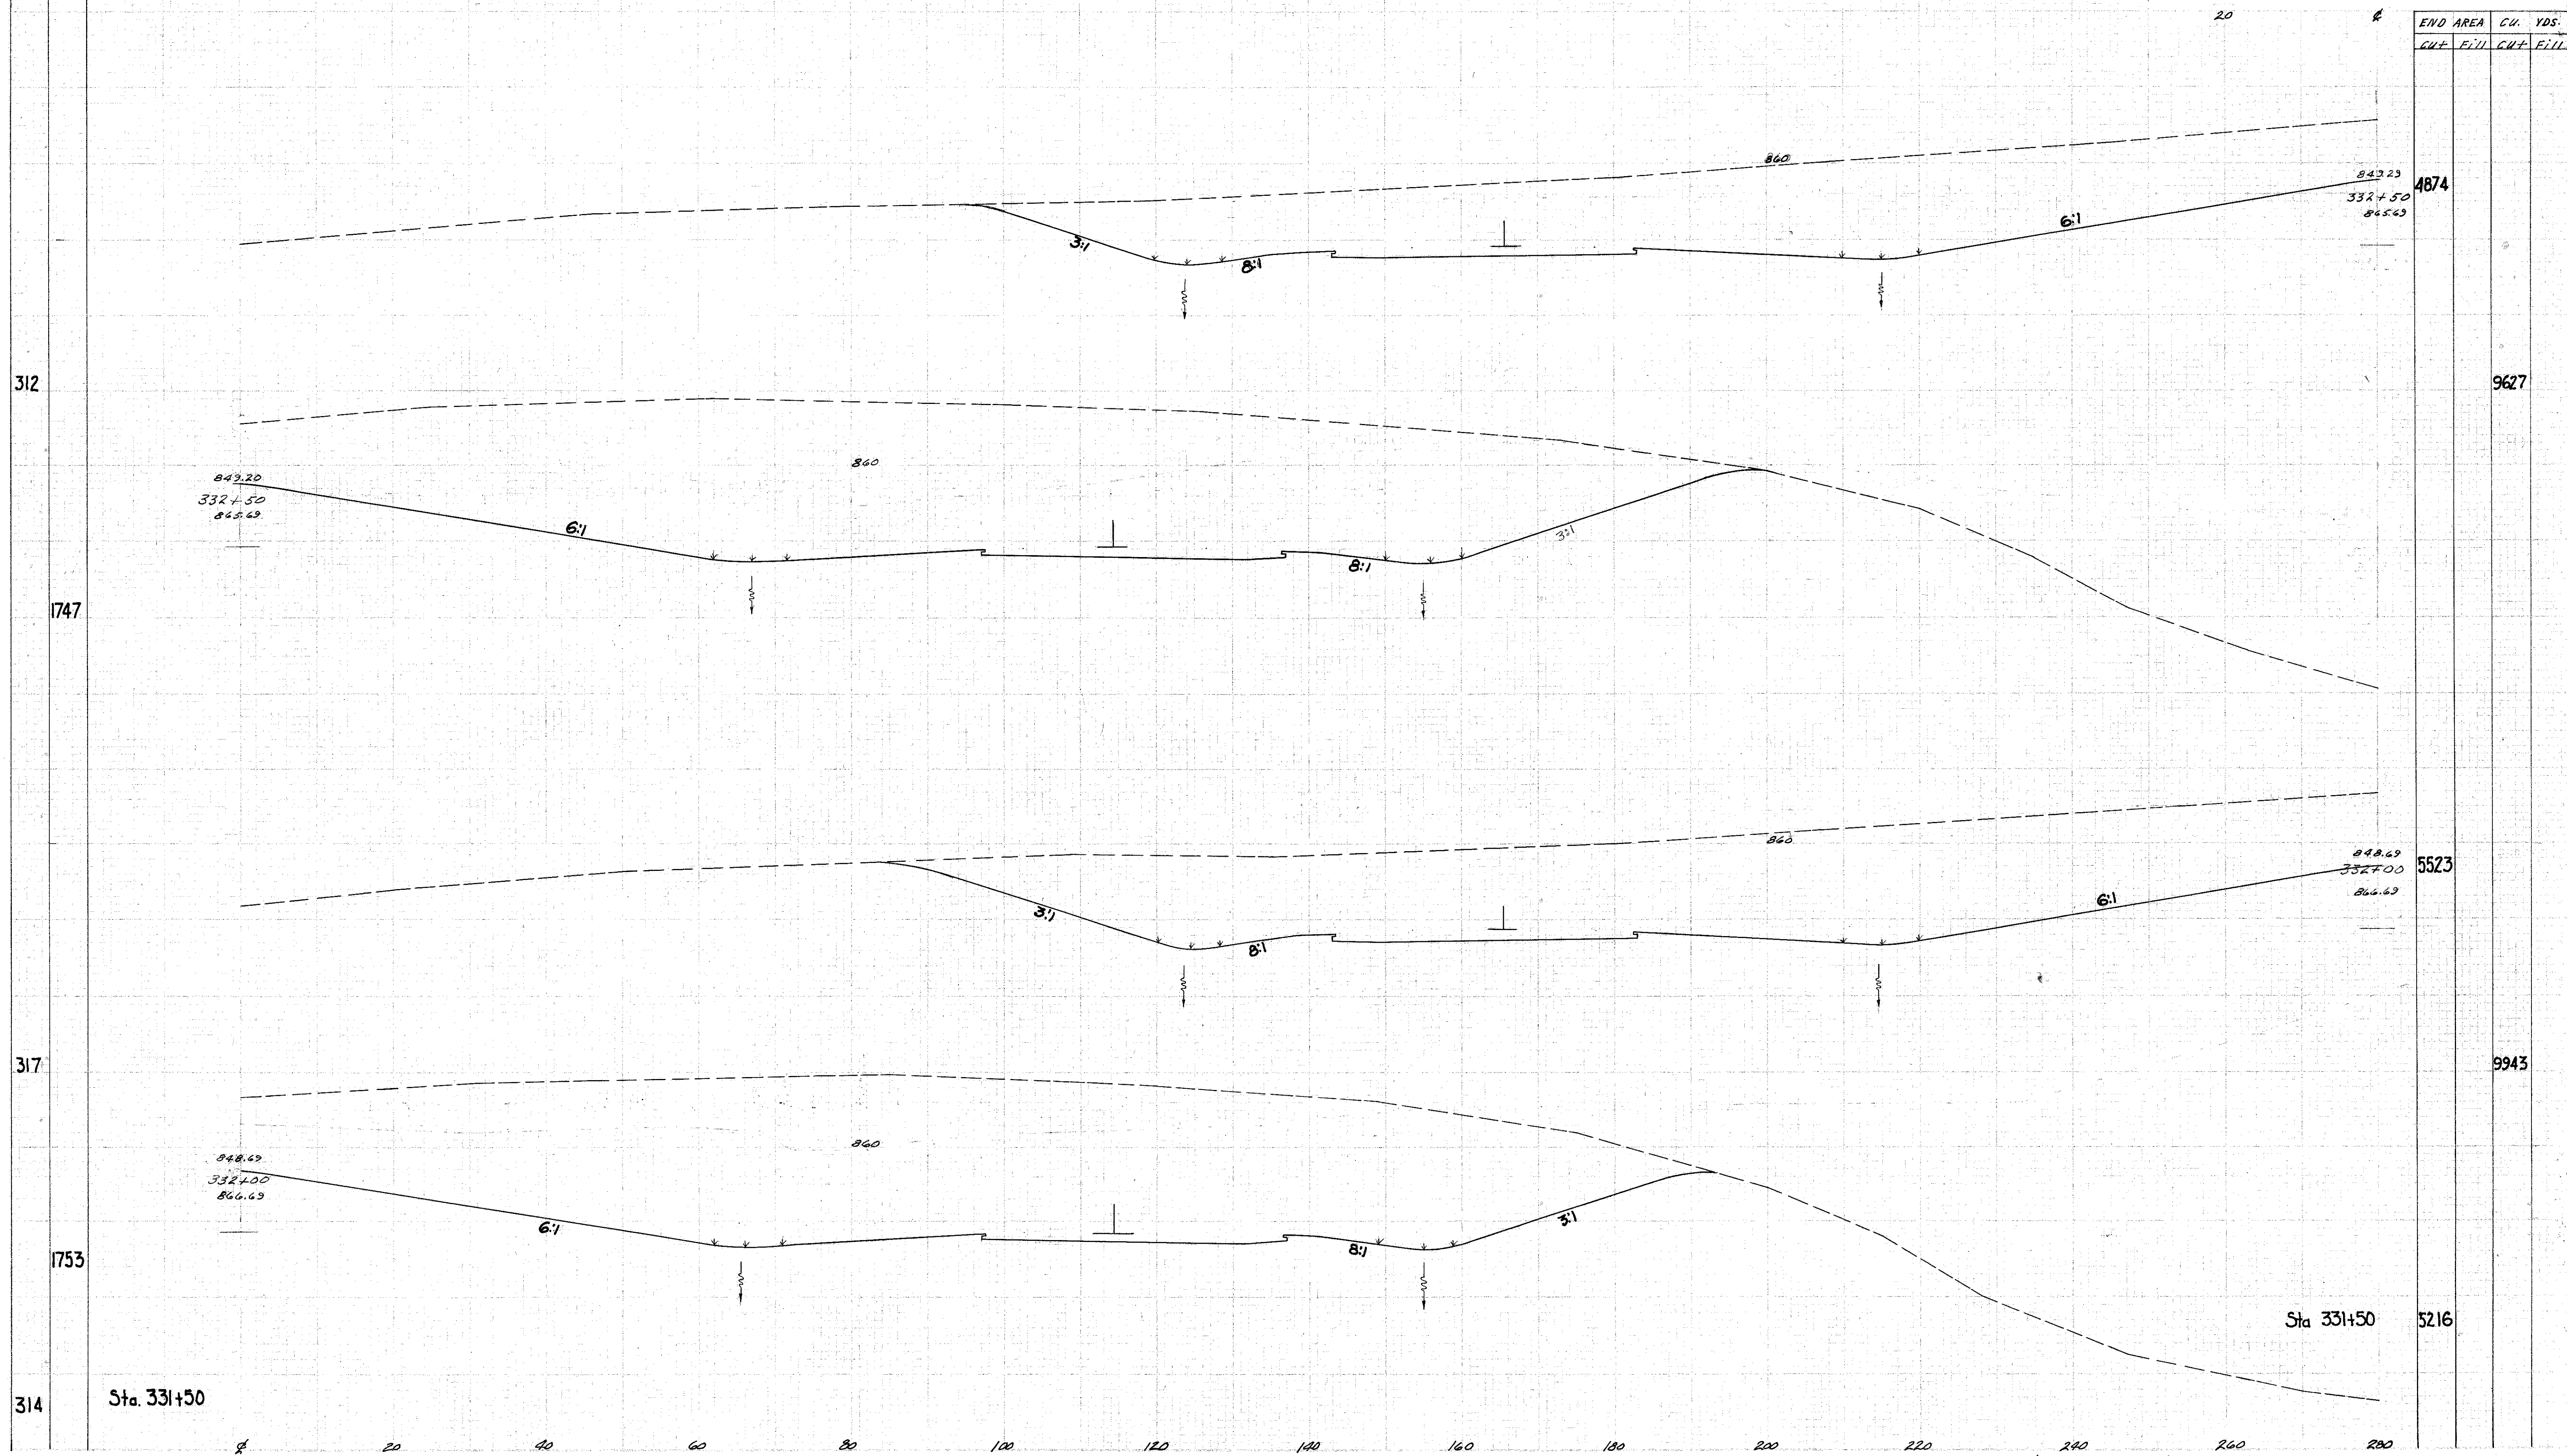

312

1747

317

1753

314

Sta. 331+50

Sta 331+50

27 Oct. '58 F.M.L. Sta. 332+00 TO 332+50