

SEEDING  
END WIDTH SQ. YDS.


280 260 240 220 200 180 160 140 120 100 80 60 40

NO. OF DEPARTMENTS	STATE	PROJECT	46 488
2	OHIO	ACI-1103 (21)	

This sheet supersedes sheet no. 46 of the original plan.

LAKE COUNTY  
LAK-1- 12.89

END AREA		CU. YDS.	
CUT	FILL	CUT	FILL

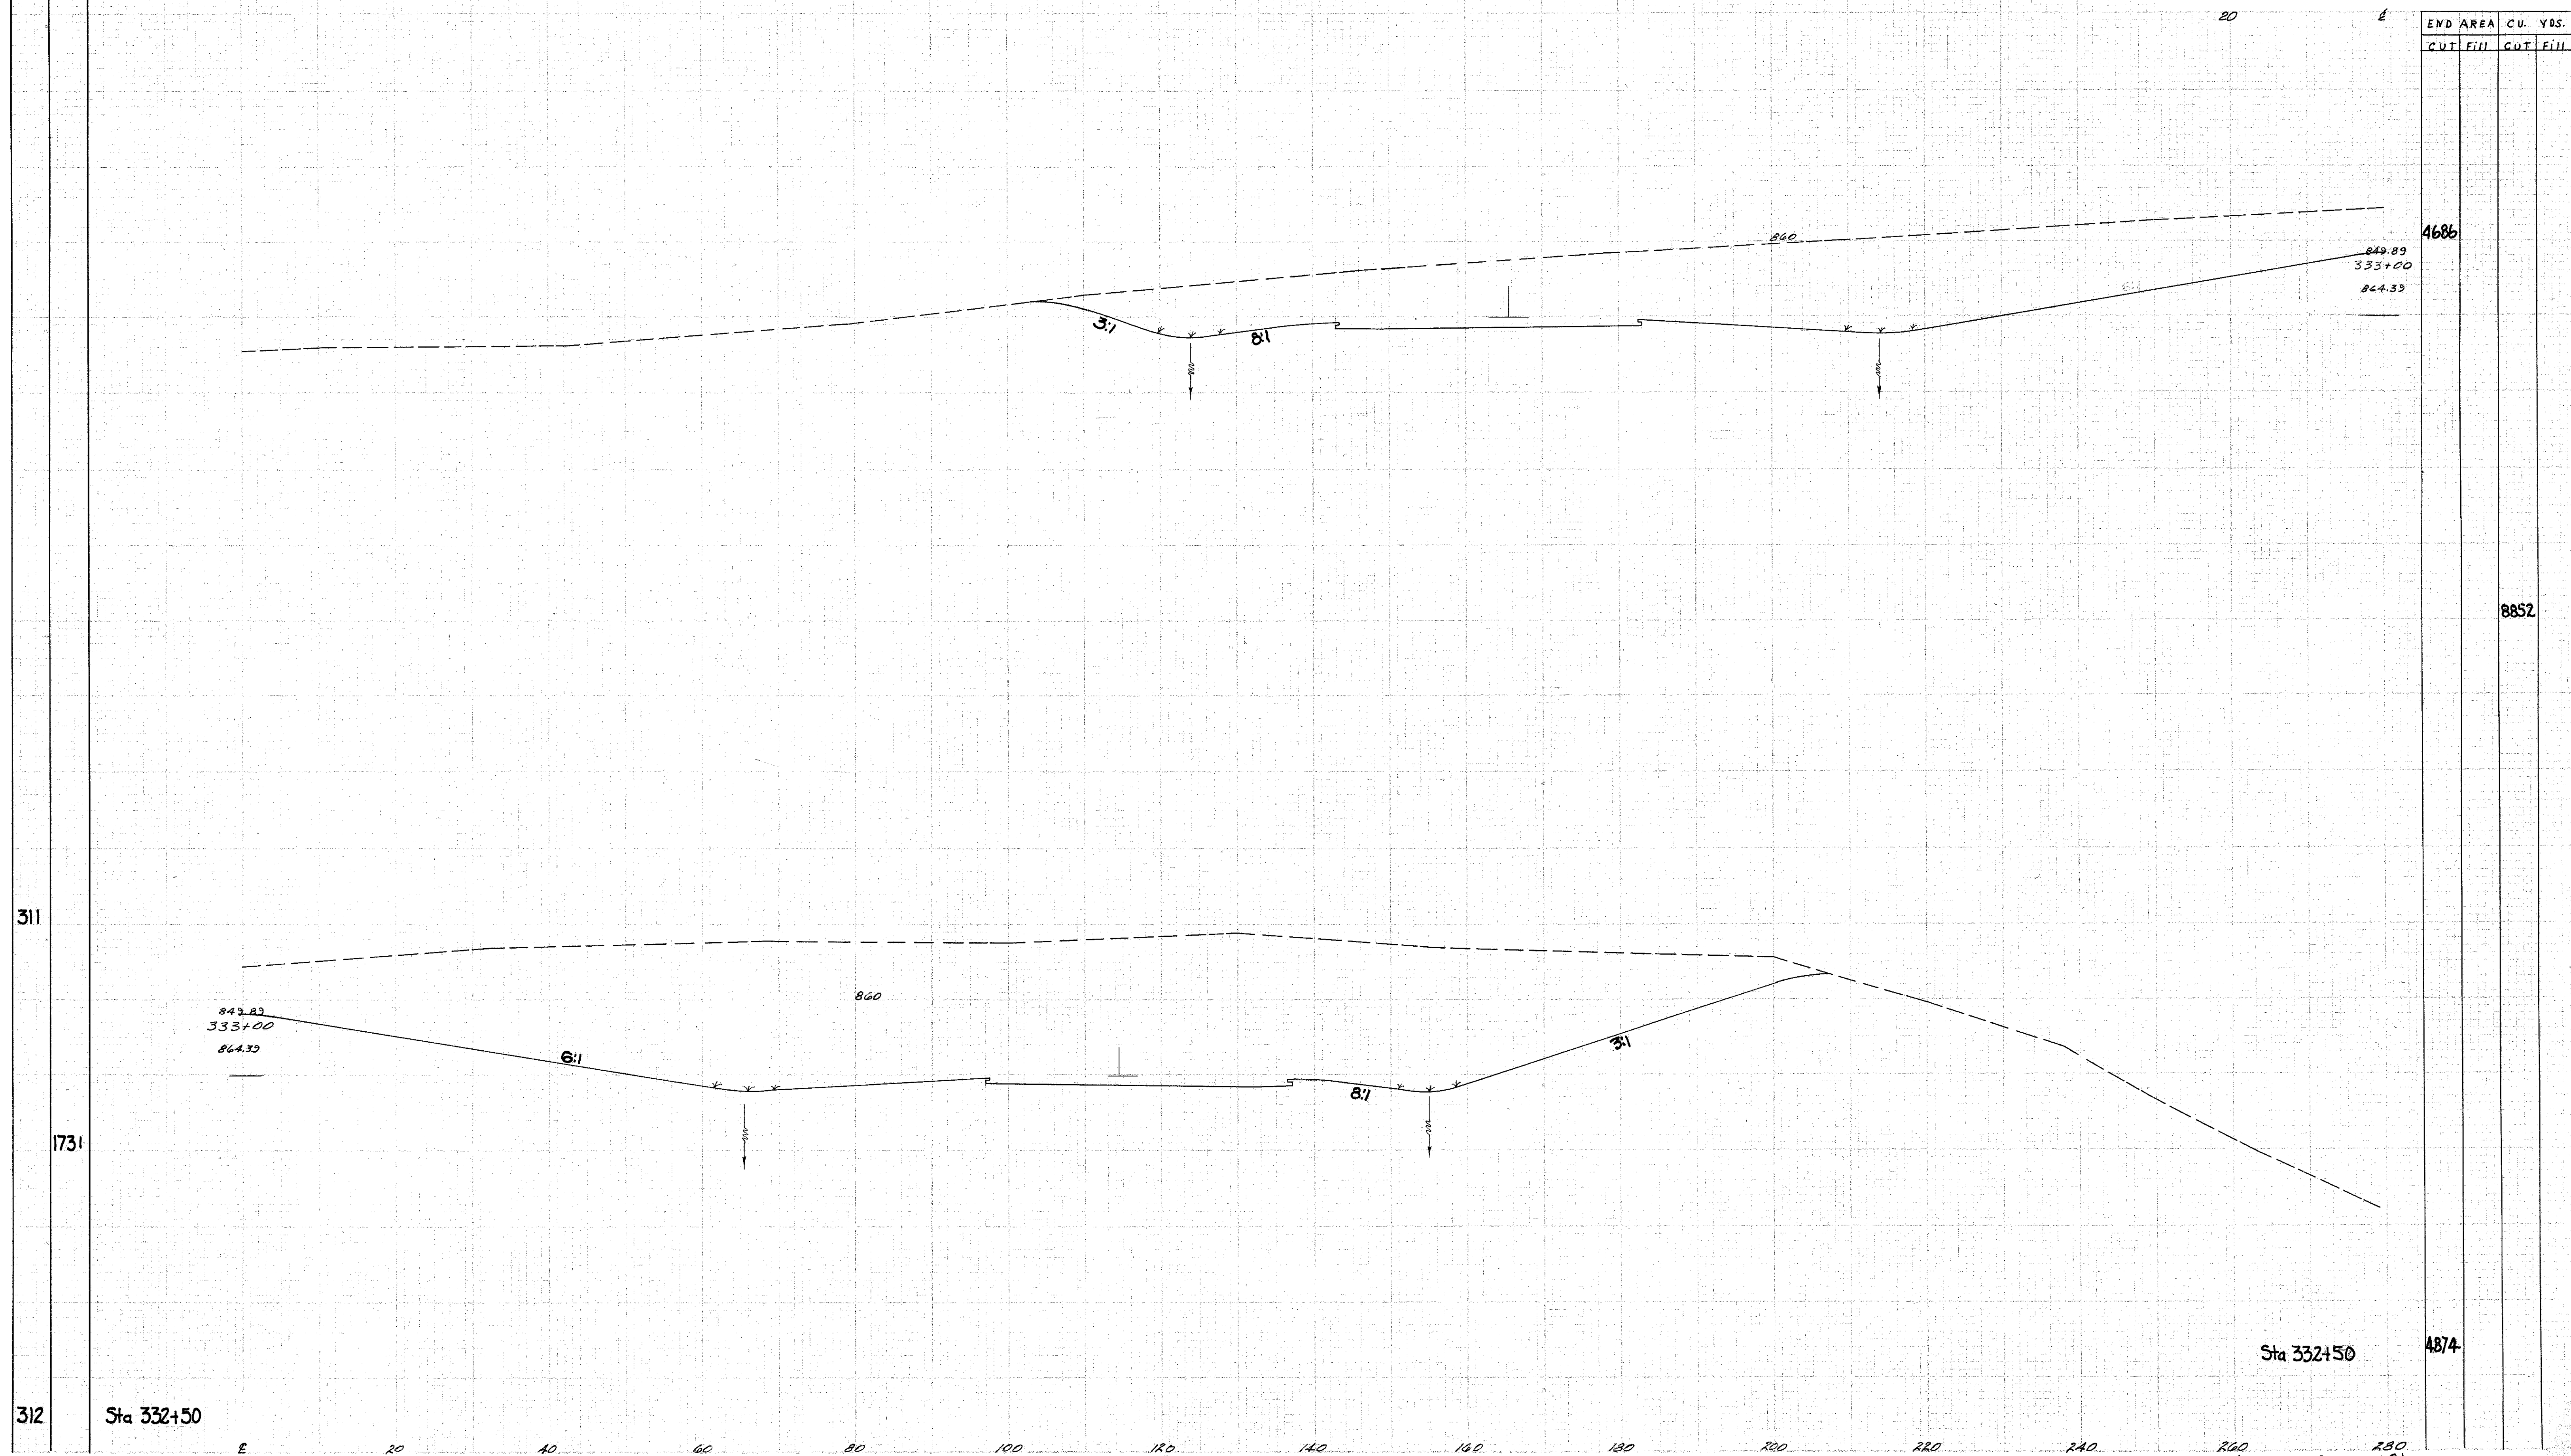

4686  
849.89  
333+00  
864.33

8852

311

849.89  
333+00  
864.33

1731

312 Sta 332+50

Sta 332+50

4874

E 20 40 60 80 100 120 140 160 180 200 220 240

27 Oct. '58 *J. L. ...* Sta. 333+00